

N O T I C E

THIS DOCUMENT HAS BEEN REPRODUCED FROM
MICROFICHE. ALTHOUGH IT IS RECOGNIZED THAT
CERTAIN PORTIONS ARE ILLEGIBLE, IT IS BEING RELEASED
IN THE INTEREST OF MAKING AVAILABLE AS MUCH
INFORMATION AS POSSIBLE

24
(NASA-CR-165129) MOD-OA 200 kW WIND TURBINE
GENERATOR ENGINEERING Final Engineering
Drawing Report (Westinghouse Electric Corp.)
246 p HC A11/MF A01 CSCL 10B

N81-23598

Unclass
42242

G3/44

DOE/NASA/0163-3
NASA CR-165129
AESD-TME-3053

MOD-OA 200 kW WIND TURBINE GENERATOR ENGINEERING DRAWING REPORT

T.S. Andersen, C.A. Bodenschatz,
A.G. Eggers, P.S. Hughes, and R.F. Lampe
Westinghouse Electric Corporation
Advanced Energy Systems Division



AUGUST 1980

Prepared for
NATIONAL AERONAUTICS AND SPACE ADMINISTRATION
Lewis Research Center
Under Contract DEN 3-163

U.S. DEPARTMENT OF ENERGY
Conservation and Solar Energy
Office of Solar Power Applications

TABLE OF CONTENTS

<u>Section</u>	<u>Page</u>
ACKNOWLEDGEMENTS	ii
SUMMARY.	1
INTRODUCTION	2
DISCUSSION	6

LIST OF FIGURES

<u>Figure No.</u>		<u>Page</u>
1	MOD-OA 200 kW Wind Turbine Generator; Clayton, NM.	5

LIST OF TABLES

<u>Table No.</u>		<u>Page</u>
1	List of Drawings for the MOD-OA 200 kW Wind Turbine Generator - Correlation of Westinghouse Drawings to NASA LeRC Drawings	7
2	List of Drawings for the MOD-OA 200 kW Wind Turbine Generator - Correlation of NASA LeRC Drawings to Westinghouse Drawings	23

PRECEDING PAGE BLANK NOT FILMED

SUMMARY

This report provides engineering drawings which document the design of the MOD-OA 200 kW wind turbine generator installed at Clayton, NM. The MOD-OA wind turbine was designed and built by the NASA Lewis Research Center for the U.S. Department of Energy as part of the Federal Wind Energy Program. The objective of the MOD-OA project is to obtain early operation and performance data and experience with horizontal-axis wind turbines in utility environments. The first MOD-OA wind turbine was released to the Town of Clayton Light and Water Plant for utility operation in March 1978.

This report contains the engineering drawings for all mechanical and electrical systems except the blades. Included are drawings for the hub, pitch change mechanism, drive train, nacelle equipment, yaw drive system, tower, foundation, electrical power system, and the control and safety systems.

INTRODUCTION

HISTORY AND BACKGROUND

Wind energy systems have been utilized for centuries as a source of power for a variety of applications. Some of the more recent applications included sailing ships for transportation and wind turbines (windmills) for grinding grain, pumping water, and generating electricity. In the early 1940's, a Smith-Putnam large Horizontal-Axis Wind Turbine (HAWT) was designed and built to feed power into the existing electrical network of the Central Vermont Public Service Company. This machine consisted of a two-bladed 175 foot (53.3 m) diameter rotor which was capable of producing 1.25 MW of power. In addition, Dr. U. Hütter designed and built a 100 kW Wind Turbine Generator (WTG) in West Germany in the late 1950's and gained operating experience with his machine tied to the utility network. The Hütter machine used a downwind 112 foot (34.1 m) diameter two-bladed rotor. Several of the design criteria and design features of the Smith-Putnam and Hütter WTGs were considered or incorporated into the MOD-0 and MOD-0A HAWTs.

RECENT DEVELOPMENTS

The recent national concern over the increase in energy demand and costs of fossil fuels, the dwindling supplies of domestic gas and oil, and the nation's increasing dependence upon imported oil has made it necessary to develop alternate energy sources. Wind energy conversion has long been recognized as a potentially abundant source of electrical power. Utilization of wind energy is becoming more attractive as the cost differential between wind and the more conventional fossil alternative narrows.

A Federal Wind Energy Program originated at the National Science Foundation in 1973. The objective of this program is to accelerate the development of reliable and economically viable wind energy systems and achieve early commercialization. Satisfying this objective requires advancing the technology, developing a sound industrial base, and addressing the non-technological issues which could impede its development. In January 1975, the responsibility for managing the program was transferred to the Energy Research and Development Administration (ERDA). These efforts were continued by the Division of Distributed Solar Technology in the U.S. Department of Energy (DOE) after October 1, 1977.

One segment of the Federal Wind Program is the development of large horizontal-axis WTGs. In 1973, the NASA Lewis Research Center (LeRC) was asked by the National Science Foundation (and later by ERDA and DOE) to develop, and provide project management for, the designs of large, experimental, horizontal-axis WTGs and perform the necessary supporting research and technology development. Initially, a review of prior experience

in WTGs was performed. Then, analytical techniques and computer codes were developed to predict the structural dynamics of large HAWT systems such as the MOD-OA.

MOD-O WIND TURBINE GENERATOR

As part of the federal wind program, NASA LeRC designed, built, and started testing a 100 kW wind turbine in September 1975. This experimental project, designated the MOD-O, had primary objectives of providing the engineering data and serving as a test bed for evaluating advanced wind turbine design concepts. The MOD-O WTG was designed using available technology and "off-the-shelf" components where possible. Design, fabrication, and assembly were completed in 18 months. The MOD-O WTG has a 125 foot (38.1 m) diameter downwind rotor which operates at 40 rpm. The rotor drives a 60 Hz synchronous alternator through a step-up gearbox at 1800 rpm. The MOD-O project has been used to help understand the performance and the dynamic behavior of wind turbines. The MOD-O WTG was utilized to: 1) understand the tower shadow and wind shear effects; 2) assess operational performance; 3) evaluate automatic startup and shutdown capabilities, including synchronization to a large and small utility network; and 4) test various components, such as induction generators and steel spar wind turbine blades.

MOD-OA WIND TURBINE GENERATOR

The MOD-OA 200 kW wind turbine generator is, in most respects, an uprated version of the MOD-O 100 kW WTG. The MOD-OA WTG was designed and analyzed by the NASA LeRC for the DOE. The objective of the MOD-OA Project is to conduct early testing of wind turbines in utility environments so that the machine operating performance and dynamic characteristics can be determined. Besides gaining operational experience with wind turbines interfaced with utility networks, an additional objective of the -OA project is obtaining the utility's and the public's reaction to intermediate size WTGs. The prototype MOD-O design was simplified and made "field-worthy" as it was uprated to the 200 kW size.

The purpose of this engineering drawing report is to document the design of the MOD-OA 200 kW wind turbine generator at Clayton, NM now being operated by the Town of Clayton Light and Water Plant. This machine was built to NASA drawings and specifications. Updated drawings were subsequently prepared in Westinghouse format to reflect as-built conditions on the Clayton and later machines. These latest drawings are presented here with a cross index to the original NASA drawings.

The MOD-OA wind turbine is shown in operation at the Clayton site in Figure 1. The operational history for the Clayton MOD-OA WTG during its initial phases of use is as follows:

<u>Date</u>	<u>Event</u>
● November 30, 1977	First rotation
● January 19, 1978	First 100 hours (0.36 megaseconds) of operation
● January 28, 1978	Formal dedication of wind turbine
● March 6, 1978	Turned over the operation by the utility
● May 24, 1978	1000 hours (3.6 megaseconds) of operation [94,000 kW-hr (338.GJ)]

SUPPLEMENTARY MOD-OA REPORTS

Two supplementary reports to this MOD-OA engineering drawing report provide the details¹ and an executive summary² of the design and analysis of the MOD-OA wind turbine generator.

¹ Andersen, T.S., Bodenschatz, C.A., Eggers, A.G., Hughes, P.S., Lampe, R.F., Lipner, M.H., and Schornhorst, J.R., "MOD-OA 200 kW Wind Turbine Generator Design and Analysis Report," DOE/NASA/O163-2, NASA CR-165128, and AESD-TME-3052, August 1980.

² Andersen, T.S., Bodenschatz, C.A., Eggers, A.G., Hughes, P.S., Lampe, R.F., Lipner, M.H., and Schornhorst, J.R., "Executive Summary. MOD-OA 200 kW Wind Turbine Generator Design and Analysis Report," DOE/NASA/O163-1, NASA CR-165127, and AESD-TME-3051, August 1980.



Figure 1. MOD-0A 200 kW Wind Turbine
Generator; Clayton, NM

ORIGINAL PAGE IS
OF POOR QUALITY

DISCUSSION

The MOD-OA engineering drawings follow this discussion in numerical order (by Westinghouse drawing number). The mechanical drawings (Westinghouse drawings 1015F-- and 1017F--) are followed by the electrical drawings (1016F--). Table 1 provides a list of drawings and title in this order with cross-reference to the number and title of the NASA drawings from which the Westinghouse drawings were prepared. The NASA drawings formed the basis for assembly and installation of the MOD-OA wind turbine generators and are listed in numerical order in Table 2 with cross reference to the number and title of the corresponding Westinghouse drawings.

TABLE 1
LIST OF DRAWINGS FOR THE MOD-OA 200 kW WIND TURBINE GENERATOR

CORRELATION OF WESTINGHOUSE DRAWINGS TO NASA LEWIS RESEARCH CENTER DRAWINGS

WESTINGHOUSE DRAWING NUMBER	NUMBER OF SHTS.	NASA LEWIS DRAWING NUMBER	NUMBER OF SHTS.	*REV.	TITLE OF DRAWING
1015F01	11	CR758862 CR758863	1 1	K G	(NASA) MOD-OA 200 kW WIND TURBINE GENERATOR ASSEMBLY (NASA) MOD-OA 200 kW WIND TURBINE GENERATOR ASSEMBLY (W) ASSEMBLY MOD-OA 200 kW WIND TURBINE GENERATOR
1015F02	1	CD758836	1	A	(NASA) HUB FORGING (W) HUB PITCH FORGING MOD-OA 200 kW WIND TURBINE GENERATOR
1015F03	4	CR758864 CD758875	1 1	D C	(NASA) ASSEMBLY-GEAR TYPE PITCH CONTROL HUB (NASA) SUB-ASSEMBLY BEARING & GEAR ADJUSTMENT (W) PITCH CONTROL HUB ASS'Y MOD-OA 200 kW WIND TURB. GEN.
1015F04	1	CF758865	1	B	(NASA) ASSEMBLY-GEAR TYPE PITCH CONTROL HUB - DETAIL 1 (W) HUB PITCH DETAIL MOD-OA 200 kW WIND TURBINE GENERATOR
1015F05	1	CD758866	1	A	(NASA) ASSEMBLY-GEAR TYPE PITCH CONTROL HUB - DETAIL 2 (W) BLADE SPINDLE SLEEVE MOD-OA 200 kW WIND TURBINE GEN.
1015F06	1	CD758867	1	D	(NASA) ASSEMBLY-GEAR TYPE PITCH CONTROL HUB - DETAIL 3 (W) BLADE SPINDLE HOUSING MOD-OA 200 kW WIND TURBINE GEN.
1015F07	1	CD758868	1	C	(NASA) ASSEMBLY-GEAR TYPE PITCH CONTROL HUB - DETAIL 4 (W) DRIVE SHAFT BEARING RETAINER MOD-OA 200 kW WTG
1015F08	1	CD758869	1	B	(NASA) ASS'Y-GEAR TYPE PITCH CONTROL HUB-DETAILS 5 THRU 11 (W) HUB PITCH DETAILS MOD-OA 200 kW WIND TURBINE GENERATOR
1015F09	1	CD758870	1	B	(NASA) ASSEMBLY-GEAR TYPE PITCH CONTROL HUB - DETAIL 12 (W) HUB PITCH DRIVE SHAFT MOD-OA 200 kW WIND TURBINE GEN.
1015F10	1	CD758872	1	C	(NASA) ASSEMBLY-GEAR TYPE PITCH CONTROL HUB - DETAIL 15 (W) HUB PITCH BEVEL PINION GEAR MOD-OA 200 kW WTG
1015F11	1	CD758873	1	C	(NASA) ASSEMBLY-GEAR TYPE PITCH CONTROL HUB - DETAIL 16 (W) HUB PITCH BEVEL GEAR SECTOR MOD-OA 200 kW WTG

*All Westinghouse Drawings are Revision - (i.e., Unrevised)

TABLE 1 (Cont'd.)
LIST OF DRAWINGS FOR THE MOD-OA 200 kW WIND TURBINE GENERATOR
CORRELATION OF WESTINGHOUSE DRAWINGS TO NASA LEWIS RESEARCH CENTER DRAWINGS

WESTINGHOUSE DRAWING NUMBER	NUMBER OF SHTS.	NASA LEWIS DRAWING NUMBER	NUMBER OF SHTS.	REV.	TITLE OF DRAWING
1015F12	1	CF758874	1	C	(NASA) ASS'Y-GEAR TYPE PITCH CONTROL HUB-DETAILS 17 THRU 25 (W) HUB PITCH DETAILS MOD-OA 200 kW WIND TURBINE GENERATOR
1015F13	1	NONE	-	-	(W) GENERAL OUTLINE MOD-OA 200 kW WIND TURBINE GENERATOR
1015F14	6	CR758877	1	E	(NASA) BEDPLATE (W) BEDPLATE MOD-OA 200 kW WIND TURBINE GENERATOR
1015F15	3	CR758878	1	D	(NASA) FWD CENTER SHROUD (W) FORWARD CENTER SHROUD MOD-OA 200 kW WIND TURBINE GEN.
1015F16	4	CR758879	1	E	(NASA) REAR CENTER SHROUD (W) REAR CENTER SHROUD MOD-OA 200 kW WIND TURB. GENERATOR
1015F17	1	CF758880	1	A	(NASA) NOSE CONE (W) NOSE CONE MOD-OA 200 kW WIND TURBINE GENERATOR
1015F18	1	CF758881	1	C	(NASA) PROP CONE (W) PROP CONE (SPINNER) MOD-OA 200 kW WIND TURBINE GEN.
1015F19	1	CD758882	1	B	(NASA) PROP HUB & CONE COVER PLATE (W) BLADE OPENING COVERS MOD-OA 200 kW WIND TURBINE GEN.
1015F20	1	CD758883	1	-	(NASA) CONE SUPPORT DETAILS (W) CONE SUPPORT DETAILS MOD-OA 200 kW WIND TURBINE GEN.
1015F21	1	CD758884	1	A	(NASA) FRONT HUB SUPPORT (W) MOUNTING PANEL-PROP CONE MOD-OA 200 kW WIND TURB. GEN.
1015F22	1	CD758885	1	-	(NASA) REAR HUB SUPPORT (W) SUPPORT-PROP CONE MOD-OA 200 kW WIND TURBINE GENERATOR
1015F23	2	CF758886	1	C	(NASA) WALKWAYS (W) WALKWAYS MOD-OA 200 kW WIND TURBINE GENERATOR
1015F24	1	CF758887	1	A	(NASA) ADJ. GENERATOR BOTTOM PLATE (W) BOTTOM PLATE-GENERATOR ADJUSTMENT MOD-OA 200 kW WTG

ALL Westinghouse Drawings are Revision -

Sheet 2

TABLE 1 (Cont'd.)
LIST OF DRAWINGS FOR THE MOD-0A 200 kW WIND TURBINE GENERATOR
CORRELATION OF WESTINGHOUSE DRAWINGS TO NASA LEWIS RESEARCH CENTER DRAWINGS

WESTINGHOUSE DRAWING NUMBER	NUMBER OF SHTS.	NASA LEWIS DRAWING NUMBER	NUMBER OF SHTS.	* REV.	TITLE OF DRAWING
1015F25	1	CF758888	1	A	(NASA) ADJ. GEN. TOP & LOCK BAR (W) GENERATOR ADJUSTMENT DETAILS
1015F26	1	CF758889	1	C	(NASA) DETAILS (W) DETAILS MOD-0A 200 kW WIND TURBINE GENERATOR
1015F27	1	CF758890	1	C	(NASA) MAIN DRIVE SHAFT (W) MAIN DRIVE SHAFT MOD-0A 200 kW WIND TURBINE GENERATOR
1015F28	1	CD758892	1	-	(NASA) BRAKE SUPPORT (W) BRAKE SUPPORT MOD-0A 200 kW WIND TURBINE GENERATOR.
1015F29	1	CD758895	1	-	(NASA) PULLEY DRIVE SHAFT (W) PULLEY DRIVE SHAFT MOD-0A 200 kW WIND TURB. GENERATOR
1015F30	2	CR758896	1	E	(NASA) MAIN YAW BRG SUPPORT (W) MAIN YAW BRG SUPPORT MOD-0A 200 kW WIND TURBINE GEN.
1015F31	1	CF758897	1	A	(NASA) YAW DRIVE BRG HOUSING (W) YAW DRIVE BRG HOUSING MOD-0A 200 kW WIND TURBINE GEN.
1015F32	1	CF758898	1	-	(NASA) YAW DRIVE SHAFT (W) YAW DRIVE SHAFT MOD-0A 200 kW WIND TURBINE GENERATOR
1015F33	1	CF758899	1	-	(NASA) YAW BRG RETAINER & SEAL (W) YAW-BRG RETAINERS MOD-0A 200 kW WIND TURBINE GENERATOR
1015F34	1	CD758900	1	A	(NASA) INTER. YAW DRIVE SHAFT (W) INTERMEDIATE YAW DRIVE SHAFT MOD-0A 200 kW WTG
1015F35	1	CD758901	1	B	(NASA) YAW DRIVE MOUNTING (W) YAW DRIVE MOUNTING PLATE MOD-0A 200 kW WIND TUR. GEN.
1015F36	1	CD758902	1	C	(NASA) SHEAR KEY & THRUST BUTTON (W) SHEAR KEY & THRUST BUTTON MOD-0A 200 kW WIND TUR. GEN.
1015F37	1	CD758903	1	B	(NASA) MAIN SLIP RING SUPPORT HORIZ. (W) MAIN SLIP RING SUPPORT (HORIZ.) MOD-0A 200 kW WTG

* All Westinghouse Drawings are Revision -

Sheet 3

TABLE 1 (Cont'd.)
LIST OF DRAWINGS FOR THE MOD-OA 200 kW WIND TURBINE GENERATOR
CORRELATION OF WESTINGHOUSE DRAWINGS TO NASA LEWIS RESEARCH CENTER DRAWINGS

WESTINGHOUSE DRAWING NUMBER	NUMBER OF SHTS.	NASA LEWIS DRAWING NUMBER	NUMBER OF SHTS.	REV.	TITLE OF DRAWING
1015F38	2	CF758904	1	C	(NASA) BREAK PRESS. SYST. (W) PIPING SCHEMATIC & PANEL LAYOUT BREAK CHAMBER & PRESSURIZING SYSTEM MOD-OA 200 kW WIND TURBINE GENERATOR
1015F39	1	CC758905 CC758907 CC758931	1 1 1	- - A	(NASA) LIFTING BOOM (NASA) "U" BOLT - BOTTLE HOLD DOWN (NASA) WIND SPEED MOUNTING BRACKET (W) LIFTING BOOM, U-BOLT & WIND SPEED & DIRECTIONAL MOUNT- BRACKET MOD-OA 200 kW WIND TURBINE GENERATOR
1015F40	1	CD758906	1	-	(NASA) HYD PACK SUPPORT BED (W) HYDRAULIC PACKAGE SUPPORT BED MOD-OA 200 kW WTG
1015F41	1	CD758909	1	B	(NASA) LIFTING BEAM & SLING ASSEMBLY (W) LIFTING BEAM & SLING ASSEMBLY MOD-OA 200 kW WTG
1015F42	1	CD758908	1	A	(NASA) HYD. PACK FAN SHROUD (W) HYDRAULIC PACKAGE FAN SHROUD MOD-OA 200 kW WTG
1015F43	3	CR758975 CR758976	1 1	A C	(NASA) SENSOR LOCATION (PLAN VIEW) (NASA) SENSOR LOCATION (ELEVATION VIEW) (W) SENSOR LOCATIONS & CONDUIT ROUTING MOD-OA 200 kW WTG
1015F44	1	CF758910	1	B	(NASA) DETAILS (W) HIGH SPEED BRAKE DETAILS MOD-OA 200 kW WIND TURB. GEN.
1015F45	1	CF758912	1	A	(NASA) ROTARY COUPLING SUPPORT (W) DEUBLIN CPLG SUPPORT BRACKET MOD-OA 200 kW WTG
1015F46	1	CD758913	1	B	(NASA) LADDER (W) LADDER WELDED ASSEMBLY MOD-OA 200 kW WIND TURB. GEN.
1015F47	1	CF758914	1	-	(NASA) REAR PROP CONE SUPPORTS (W) REAR PROP CONE SUPPORT MOD-OA 200 kW WIND TURBINE GEN.
1015F48	1	CD758915	1	A	(NASA) HYD SUPPLY CLAMP & SUPPORTS (W) HYDRAULIC SUPPLY CLAMP & SUPPORT MOD-OA 200 kW WTG

* All Westinghouse Drawings are Revision -

Sheet 4

TABLE 1 (Cont'd.)

LIST OF DRAWINGS FOR THE MOD-OA 200 kW WIND TURBINE GENERATOR
CORRELATION OF WESTINGHOUSE DRAWINGS TO NASA LEWIS RESEARCH CENTER DRAWINGS

WESTINGHOUSE DRAWING NUMBER	NUMBER OF SHTS.	NASA LEWIS DRAWING NUMBER	NUMBER OF SHTS.	REV.	TITLE OF DRAWING
1015F49	2	CF758916	1	C	(NASA) CO AXIAL FLOW LINE ASSEMBLY (W) CO AXIAL FLOW LINE - ASSEMBLY & DETAIL MOD-OA 200 kW WIND TURBINE GENERATOR
1015F50	1	CD758919	1	A	(NASA) SPINNER RAIN GUARD (W) SPINNER RAIN GUARD MOD-OA 200 kW WIND TURBINE GENERATOR
1015F51	1	CF758920	1	A	(NASA) SLIP RING ANTI-ROTATION SUPPORT & BRKT. (W) SLIP RING ANTI-ROTATION SUPPORT & BRKT. MOD-OA 200 kW WIND TURBINE GENERATOR
1015F52	3	CF758921 CF758922 CF758923	1 1 1	A A -	(NASA) HYDRAULIC PUMP PACKAGE ASSEMBLY (W) HYDRAULIC PUMP PACKAGE ASSY MOD-OA 200 kW WTG
1015F53	2	CF758924	1	-	(NASA) DETAILS (W) HYDRAULIC PUMP PACKAGE ASSY MOD-OA 200 kW WTG
1015F54	1	CR758926	1	-	(NASA) DETAILS (W) HYDRAULIC PUMP DETAILS MOD-OA 200 kW WIND TURB. GEN.
1015F55	4	CR758926	1	B	(NASA) ACTUATOR ASSEMBLY (W) ACTUATOR ASSEMBLY MOD-OA 200 kW WIND TURB. GEN.
1015F56	1	CF758927	1	A	(NASA) DETAILS (W) ACTUATOR ASSY DETAILS MOD-OA 200 kW WIND TURB. GEN.
1015F57	1	CF758928	1	A	(NASA) DETAILS (W) ACTUATOR ASSY DETAILS MOD-OA 200 kW WIND TURB. GEN.
1015F58	1	CF758929 CF758929	1	B -	(NASA) HYDRAULIC SCHEMATIC DIAGRAM (NASA) OPERATIONAL REQUIREMENTS & PARTS LIST (W) CONTROL SCHEMATIC DIAGRAM MOD-OA 200 kW WTG
1015F59	1	CF758930	1	B	(NASA) INTERFACE-METAL BLADE TO PITCH CONTROL HUB (W) INTERFACE-BLADE TO HUB MOD-OA 200 kW WIND TURBINE GEN.
1015F60	1	None			(NASA) NONE (W) DETAILS MOD-OA 200 kW WTG

All Westinghouse Drawings are Revision -

Sheet 5

TABLE 1 (Cont'd.)
LIST OF DRAWINGS FOR THE MOD-OA 200 kW WIND TURBINE GENERATOR
CORRELATION OF WESTINGHOUSE DRAWINGS TO NASA LEWIS RESEARCH CENTER DRAWINGS

WESTINGHOUSE DRAWING NUMBER	NUMBER OF SHTS.	NASA LEWIS DRAWING NUMBER	NUMBER OF SHTS.	* REV.	TITLE OF DRAWING
1015F61	1	CD758932	1	A	(NASA) UPPER BRAKE SUPPORT (W) UPPER BRAKE SUPPORT MOD-OA 200 kW WIND TURBINE GEN.
1015F62	1	CD758933	1	-	(NASA) TURNTABLE BEARING & GEAR ASSY (W) TURNTABLE BRG & GEAR ASSY MOD-OA 200 kW WIND TURB. GEN.
1015F63	1	CD758934	1	C	(NASA) LIFTING BEAM (W) LIFTING BEAM DETAILS MOD-OA 200 kW WIND TURBINE GEN.
1015F64	1	CF758936	1	A	(NASA) EXTERIOR FINISH-FIBERGLAS HOUSING (W) EXTERIOR FINISH-FIBERGLAS HOUSING MOD-OA 200 kW WTG
1015F65	1	CB758490 CC758937	1 1	A B	(NASA) BUTTRES RING RETAINER (NASA) TRANSFORMER BRACKETS (W) TRANSFORMER ANTI-ROTATION BRACKET & BUTTRES RING RETAINER DETAILS MOD-OA 200 kW WIND TURBINE GENERATOR
1015F66	1	CD758938	1	-	(NASA) OUTPUT SHAFT CONFIGURATION FOR DOUBLE REDUCTION WORM GEAR UNIT (W) DOUBLE REDUCTION WORM GEAR UNIT YAW DRIVE MOD-OA 200 kW WIND TURBINE GENERATOR
1015F67	1	CF758939	1	A	(NASA) TOWER SLIP RING ANTI-ROTATION ASSEMBLY (W) TOWER SLIP RING ANTI-ROTATION ASSY MOD-OA 200 kW WTG
1015F68	1	CC758871 CC758945	1 1	A A	(NASA) DETAILS (NASA) BUTTRES RING (W) DETAIL MOD-OA 200 kW WIND TURBINE GENERATOR
1015F69	1	CF758946	1	B	(NASA) MOD OA WIND TURBINE GENERATOR SITE PLAN & GENERAL ASSY (W) SITE PLAN & GENERAL ASSY MOD-OA 200 kW WIND TURBINE GEN.
1015F70	4	CF758948 CF758949 CF758950	1 1 1	B A A	(NASA) STRUCTURAL-TOWER ELEVATION & DETAILS (NASA) STRUCTURAL-TOWER PLANS & DETAILS (NASA) STRUCTURAL-TOWER DETAILS (W) TOWER ELEVATIONS, PLAN & DETAILS MOD-OA 200 kW WTG
1015F71	2	CF758952	1	-	(NASA) STRUCTURAL-ASSEMBLY STAND PLAN & DETAILS (W) ASSY STAND PLAN & DETAILS MOD-OA 200 kW WIND TURB. GEN.

* All Westinghouse Drawings are Revision -

Sheet 6

TABLE 1 (Cont'd.)
LIST OF DRAWINGS FOR THE MOD-OA 200 kW WIND TURBINE GENERATOR
CORRELATION OF WESTINGHOUSE DRAWINGS TO NASA LEWIS RESEARCH CENTER DRAWINGS

WESTINGHOUSE DRAWING NUMBER	NUMBER OF SHTS.	NASA LEWIS DRAWING NUMBER	NUMBER OF SHTS.	* REV.	TITLE OF DRAWING
1015F72	1	CD758957	1	B	(NASA) SPEED INCREASER-DIMENSIONAL REQUIREMENTS (W) SPECIAL SPEED INCREASER MOD-OA 200 kW WIND TURBINE
1015F73	1	CD758972	1	A	(NASA) GEAR BOX SLIP RING ASSEMBLY (W) GEAR BOX SLIP RING ASSEMBLY-ELECTRICAL MOD-OA 200 kW WIND TURBINE GENERATOR
1015F74	1	CF758973	1	A	(NASA) TOWER SLIP RING ASSY-ELECTRICAL (W) TOWER SLIP RING ASSY (ELEC) MOD-OA 200 kW WTG
1015F75	1	CF758974	1	B	(NASA) TOWER SLIP RING ASSY-ELECTRICAL (W) TOWER SLIP RING ASSY (ELEC) MOD-OA 200 kW WTG
1015F76	2	CF758981	1	B	(NASA) ELECTRICAL-EQUIPMENT LAYOUT, LIGHTING, GROUNDING & DETAILS (W) ELECTRICAL-EQUIPMENT LAYOUT, LIGHTING, GROUNDING & DETAILS MOD-OA 200 kW WIND TURBINE GENERATOR
1015F77	2	CF758982	1	B	(NASA) ELECTRICAL-POWER CONTROL & INSTRUMENTATION TERMINAL BOXES & DETAILS (W) ELECTRICAL-POWER CONTROL & INSTRUMENTATION TERMINAL BOXES & DETAILS MOD-OA 200 kW WIND TURBINE GENERATOR
1015F78	1	CD758999	1	-	(NASA) INTERMEDIATE SHAFT (W) HIGH SPEED SHAFT ASSEMBLY MOD-OA 200 kW WIND TURB. GEN.
1015F79	1	CF758973 CF758974	1 1	A B	(NASA) TOWER SLIP RING ASSY-ELECTRICAL (NASA) TOWER SLIP RING ASSY-ELECTRICAL (W) TOWER SLIP RING ASSY MOD-OA 200 kW WIND TURBINE GEN.
1015F80	3	CF759019 CF760485	1 1	G A	(NASA) HYDRAULIC SCHEMATIC YAW BRAKE (NASA) HYDRAULIC SYSTEM PANEL YAW BRAKE (W) YAW BRAKE HYDRAULIC SYSTEM PANEL & SCHEMATIC MOD-OA 200 kW WIND TURBINE GENERATOR
1015F81	1	CC759020 CC760504	1 1	- B	(NASA) SPACERS YAW COUPLINGS (NASA) HUB SEAL HOLDER (W) DETAILS MOD-OA 200 kW WIND TURBINE GENERATOR

* All Westinghouse Drawings are Revision -

TABLE 1 (Cont'd.)
LIST OF DRAWINGS FOR THE MOD-OA 200 kW WIND TURBINE GENERATOR
CORRELATION OF WESTINGHOUSE DRAWINGS TO NASA LEWIS RESEARCH CENTER DRAWINGS

WESTINGHOUSE DRAWING NUMBER	NUMBER OF SHTS.	NASA LEWIS DRAWING NUMBER	NUMBER OF SHTS.	* REV.	TITLE OF DRAWING
1015F82	1	CF759021	1	-	(NASA) PULLEY BEARING SUPPORT (W) PULLEY BEARING SUPPORT MOD-OA 200 kW WIND TURB. GEN.
1015F83	1	CD759023	1	A	(NASA) DETAILS FOR HYDRAULIC ACTUATOR (W) DETAILS FOR HYDRAULIC ACTUATOR MOD-OA 200 kW MTG
1015F84	1	CF759024	1	A	(NASA) DETAILS FOR PUMP PACKAGE (W) PUMP PACKAGE DETAILS MOD-OA 200 kW WIND TURBINE GEN.
1015F85	2	CF760271	1	A	(NASA) STRUCTURAL-ASSY STAND PLAN & DETAILS (W) ASSY STAND PLAN & DETAILS MOD-OA 200 kW WIND TURB. GEN.
1015F86	2	CF760300	1	-	(NASA) STRUCTURAL-TOWER & ASSY STAND-FOUNDATIONS & DETAILS- CLAYTON N.M. (W) TOWER & ASSY STAND FOUNDATION & DETAILS MOD-OA 200 kW WIND TURBINE GENERATOR
1015F87	1	CC760476	1	-	(NASA) GREASE & PRESSURE FITTINGS (W) GREASE & PRESSURE FITTINGS MOD-OA 200 kW MTG
1015F88	1	CD760477	1	-	(NASA) HUB COUNTER WEIGHTS (W) HUB COUNTER WEIGHTS MOD-OA 200 kW WIND TURBINE GEN.
1015F89	1	CF760478	1	-	(NASA) DETAILS (W) DETAILS MOD-OA 200 kW WIND TURBINE GENERATOR
1015F90	1	CF760484	1	A	(NASA) HYDRAULIC SYSTEM PANEL YAW BRAKE (W) HYDRAULICS COMPONENTS MTG PANEL MOD-OA 200 kW MTG
1015F91	1	CF760484	1	A	(NASA) HYDRAULIC SYSTEM PANEL YAW BRAKE (W) HYDRAULIC SYSTEM PANEL YAW BRAKE-STRUCTURAL SUPPORT MOD-OA 200 kW WIND TURBINE GENERATOR
1015F92	1	CD760486	1	A	(NASA) AIR BOTTLE GAGE BRACKET (W) AIR BOTTLE GAGE BRACKET DETAILS MOD-OA 200 kW MTG

* All Westinghouse Drawings are Revision -

Sheet 8

Table 1 (Cont'd)

LIST OF DRAWINGS FOR THE MOD-OA 200 kW WIND TURBINE GENERATOR					CORRELATION OF WESTINGHOUSE DRAWINGS TO NASA LEWIS RESEARCH CENTER DRAWINGS	
WESTINGHOUSE DRAWING NUMBER	NUMBER OF SHTS.	NASA LEWIS DRAWING NUMBER	NUMBER OF SHTS.	*REV.	TITLE OF DRAWING	
1015F93	1	CC759000 CC760487	1	A -	(NASA) FLUID COUPLER ADAPTER (NASA) GEAR ALT. LOW SPEED SHAFT (W) DETAILS MOD-OA 200 kW WIND TURBINE GENERATOR	
1015F94	1	CC760488 CC760500	1	A -	(NASA) DUBLIN MOUNT (NASA) SLIP RING COVER (W) DUBLIN MOUNT & SLIP RING DUST COVER MOD-OA 200 kW WTG	
1015F95	2	CF760506 CF760520	1	-	(NASA) ELECTRICAL-LOW SPEED SHAFT STRAIN GAGE LOCATION CONNECTION DIAGRAM & INSTALLATION (NASA) ELECTRICAL-LOW SPEED SHAFT STRAIN GAGE LOCATION (W) ELECTRICAL-LOW SPEED SHAFT STRAIN GAGE LOCATION MOD-OA 200 kW WIND TURBINE GENERATOR	
1015F96	1	CF760491	1	-	(NASA) YAW BRAKE ASSEMBLY (W) YAW BRAKE ASSY MOD-OA 200 kW WIND TURBINE GENERATOR	
1015F97	1	C0760492	1	-	(NASA) YAW BRAKE DETAILS (W) YAW BRAKE DETAIL MOD-OA 200 kW WIND TURBINE GENERATOR	
1015F98	1	C0760493	1	-	(NASA) YAW BRAKE DETAILS (W) YAW BRAKE DETAIL MOD-OA 200 kW WIND TURBINE GENERATOR	
1015F99	1	CC760512 C0760513	1	-	(NASA) FIXTURE FOR SEAL INSTALLATION (NASA) SEAL INSTALLATION INSTRUCTIONS (W) FIXTURES FOR SEAL INSTALLATION MOD-OA 200 kW WTG	
1017F02	1	NONE			(NASA) NONE (W) GENERATOR TACH MOUNT ASSY WITH KEYS & DETAILS MOD-OA 200 kW WIND TURBINE GENERATOR	
1017F03	2	NONE			(NASA) NONE (W) DETAILS MOD-OA 200 kW WIND TURBINE GENERATOR	

*All Westinghouse Drawings are Revision -

Sheet 9

TABLE 1 (Cont'd.)

LIST OF DRAWINGS FOR THE MOD-OA 200 kW WIND TURBINE GENERATOR
CORRELATION OF WESTINGHOUSE DRAWINGS TO NASA LEWIS RESEARCH CENTER DRAWINGS

WESTINGHOUSE DRAWING NUMBER	NUMBER OF SHTS.	NASA LEWIS DRAWING NUMBER	NUMBER OF SHTS.	REV.	TITLE OF DRAWING
1017F04	1	NONE			(NASA) NONE (W) DETAILS MOD-OA 200 kW WIND TURBINE GENERATOR
1017F05	1	NONE			(NASA) NONE (W) HYDRAULIC FITTINGS MOD-OA 200 kW WIND TURBINE GENERATOR
1016F01	4	CF758968 CF758969 CF758970	1 1 1	C E C	(NASA) ELECTRICAL-INSTRUMENTATION SENSOR WIRING LIST (NASA) ELECTRICAL-INSTRUMENTATION SENSOR WIRING LIST (NASA) ELECTRICAL-INSTRUMENTATION SENSOR WIRING LIST (W) INSTRUMENTATION SENSOR WIRING LIST MOD-OA 200 kW WTG
1016F02	1	CF758971	1	E	(NASA) ELECTRICAL-POWER ONE LINE CONNECTION DIAGRAM & SCHEDULE OF DNG. (W) POWER ONE LINE CONNECTION DIAGRAM SCHEDULE OF DNG'S MOD-OA 200 kW WIND TURBINE
1016F03	1	CF758977	1	C	(NASA) ELECTRICAL-AUXILIARY ELECTRONIC PACKAGE CONNECTION & INTERCONNECTION DIAGRAM (W) AUXILIARY ELECTRONIC PACKAGE CONNECTION & INTERCONNECTION DIAGRAM MOD-OA 200 kW WIND TURBINE
1016F04	2	CF758978	1	D	(NASA) ELECTRICAL-SENSOR IDENTIFICATION LIST (CLAYTON) (W) SENSOR IDENTIFICATION LIST MOD-OA 200 kW WIND TURBINE
1016F05	1	CF758979	1	F	(NASA) ELECTRICAL-CABLE INTERCONNECTION (W) ELECTRICAL-CABLE INTERCONNECTION MOD-OA 200 kW WTG
1016F06	1	CF758980	1	-	(NASA) ELECTRICAL-INSTRUMENTATION INTERCONNECTION DIAGRAM PHASE I TEST (W) INSTRUMENTATION INTERCONNECTION DIAGRAM LERC-ERB CM 72 PHASE I TEST MOD-OA 200 kW WIND TURBINE GENERATOR
1016F07	1	CF758983	1	C	(NASA) ELECTRICAL-GEAR BOX SLIP RING CONNECTION DIAGRAM (W) GEAR BOX SLIP RING CONNECTION DIAGRAM MOD-OA 200 kW WTG
1016F08	1	CF758984	1	G	(NASA) ELECTRICAL-TOWER SLIP RING CONNECTION DIAGRAM (W) TOWER SLP RING CONNECTION DIAGRAM MOD-OA 200 kW WTG

* All Westinghouse Drawings are Revision -

Sheet 10

TABLE 1 (Cont'd.)
LIST OF DRAWINGS FOR THE MOD-OA 200 kW WIND TURBINE GENERATOR
CORRELATION OF WESTINGHOUSE DRAWINGS TO NASA LEWIS RESEARCH CENTER DRAWINGS

WESTINGHOUSE DRAWING NUMBER	NUMBER OF SHTS.	NASA LEWIS DRAWING NUMBER	NUMBER OF SHTS.	REV.	TITLE OF DRAWING
1016F09	1	CF758985	1	A	(NASA) ELECTRICAL-STATIC SHAFT TEST INTERCONNECTION DIAGRAM (W) PHASE 1 TEST (W) STATIC SHAFT TEST INTERCONNECTION DIAGRAM LERC-ERB CW 22 PHASE 1 TEST MOD-OA 200 kW WIND TURBINE GENERATOR
1016F10	1	CF759025	1	C	(NASA) ELECTRICAL-TOWER SENSOR LOCATION PLAN, DETAILS, PIN LAYOUT & ELECTRICAL CONNECTION DIAGRAM (W) TOWER SENSOR LOCATION PLAN DETAILS, PIN LAYOUT & ELECTRICAL CONNECTION DIAG. MOD-OA 200 kW WIND TURBINE
1016F11	2	CF759026	1	E	(NASA) ELECTRICAL SAFETY SHUTDOWN-ELEMENTARY DIAGRAM (W) ELECTRICAL SAFETY SHUTDOWN-ELEMENTARY DIAGRAM MOD-OA 200 kW WIND TURBINE GENERATOR
1016F12	2	CF759027	1	F	(NASA) ELECTRICAL-CONTROL ELEMENTARY DIAGRAM (W) CONTROL ELEMENTARY DIAGRAM MOD-OA 200 kW MTG
1016F13	1	CF759028	1	D	(NASA) ELECTRICAL-YAW CONTROLLER CONNECTION DIAGRAM (W) YAW CONTROLLER CONNECTION DIAGRAM MOD-OA 200 kW MTG
1016F14	1	CF759029	1	A	(NASA) ELECTRICAL-MICRO PROCESSOR FLOW DIAGRAM (W) MICRO PROCESSOR FLOW DIAGRAM MOD-OA 200 kW MTG
1016F15	1	CF759030	1	C	(NASA) ELECTRICAL-CONNECTION DIAGRAM FOR PITCH CONTROLLER (W) ELECTRICAL CONNECTION DIAGRAM PITCH CONTROLLER MOD-OA 200 kW WIND TURBINE GENERATOR
1016F16	1	CF759031	1	E	(NASA) ELECTRICAL-MICRO PROCESSOR BLOCK DIAGRAM (W) MICROPROCESSOR BLOCK DIAGRAM MOD-OA 200 kW MTG
1016F17	1	CF759032	1	E	(NASA) ELECTRICAL-SUPERVISORY CONTROLLER INTERCONNECTION CENTRAL & REMOTE (W) SUPERVISORY CONTROLLER INTERCONNECT CENTRAL & REMOTES STATIONS & DETAIL "A" MOD-OA 200 kW WIND TURBINE GENERATOR
1016F18	2	CF759033	1	E	(NASA) ELECTRICAL-PITCH CONTROLLER SCHEMATIC (W) PITCH CONTROLLER SCHEMATIC MOD-OA 200 kW WIND TURBIN

* A: Westinghouse Drawings are Revision -

Sheet 11

TABLE 1 (Cont'd.)
LIST OF DRAWINGS FOR THE MOD-OA 200 kW WIND TURBINE GENERATOR
CORRELATION OF WESTINGHOUSE DRAWINGS TO NASA LEWIS RESEARCH CENTER DRAWINGS

WESTINGHOUSE DRAWING NUMBER	NUMBER OF SHTS.	NASA LEWIS DRAWING NUMBER	NUMBER OF SHTS.	REV.	TITLE OF DRAWING
1016F19	2	CF759034	1	F	(NASA) ELECTRICAL-CONTROL PANEL LAYOUTS & RELAY PANEL CONNECTION DIAGRAMS (W) CONTROL PANEL LAYOUTS & RELAY PANEL CONNECTION DIAGRAMS MOD-OA 200 kW MTG
1016F20	7	CF759035 CF759036 CF759037 CF759038 CF759039	1 1 1 1 1	C E F E F	(NASA) ELECTRICAL-480 V SWITCHGEAR ONE LINE DIAGRAM (NASA) ELECTRICAL-480 V SWITCHGEAR-ELEMENTARY 3 LINE DIAGRAM (NASA) ELECTRICAL-480 V SWITCHGEAR-UNIT NO. 1 CONNECTION DIA. (NASA) ELECTRICAL-480 V SWITCHGEAR-UNIT NO. 2 CONNECTION DIA. (NASA) ELECTRICAL-480 V SWITCHGEAR-UNIT NO. 3 CONNECTION DIA. (W) 480 V SWITCHGEAR WIRING DIAGRAM UNIT NOS. 1, 2 & 3 MOD-OA 200 kW MTG
1016F21	3	CF759040 CF759041 CF759042	1 1 1	D E D	(NASA) ELECTRICAL-CONNECTION DIAGRAM FOR TERMINAL BOXES 2B & 3B (NASA) ELECTRICAL-CONNECTION DIAGRAM FOR TERMINAL BOXES 2A & 2B (NASA) ELECTRICAL-CONNECTION DIAGRAM FOR TERMINAL BOXES NO. 4 (W) CONNECTION DIAGRAMS FOR TERMINAL BOXES, 2B, 3B, 2A, 3A & NO. 4 MOD-OA 200 kW MTG
1016F22	1	CF759043	1	F	(NASA) ELECTRICAL-ELECTRICAL CONNECTION DIAGRAM SAFETY SHUTDOWN PANEL (W) ELECTRICAL CONNECTION DIAGRAM SAFETY SHUTDOWN PANEL MOD-OA 200 kW MTG
1016F23	1	CF759044	1	E	(NASA) ELECTRICAL-YAW BRAKE ELEMENTARY & CONNECTION DIAGRAM (W) YAW BRAKE ELEMENTARY & CONNECTION DIAGRAM MOD-OA 200 kW MTG
1016F24	1	CF759045	1	C	(NASA) ELECTRICAL-MICRO PROCESSOR CIRCUIT CARD LOCATOR RACK A & RACK B (W) MICRO PROCESSOR CIRCUIT CARD LOCATION, RACK A & RACK B MOD-OA 200 kW MTG
1016F25	1	CF759047	1	D	(NASA) ELECTRICAL-YAW CONTROL PANEL LAYOUT (W) YAW CONTROL PANEL LAYOUT MOD-OA 200 kW MTG

* All Westinghouse Drawings are Revision -

Sheet 12

Table 1 (Cont'd)

LIST OF DRAWINGS FOR THE MOD-0A 200 KW WIND TURBINE GENERATOR
CORRELATION OF WESTINGHOUSE DRAWINGS TO NASA LEWIS RESEARCH CENTER DRAWINGS

WESTINGHOUSE DRAWING NUMBER	NUMBER OF SHTS.	NASA LEWIS DRAWING NUMBER	NUMBER OF SHTS.	*REV.	TITLE OF DRAWING
1016F26	1	CF759048	1	D	(NASA) ELECTRICAL-CONTROL RACK ANALOG TERMINAL STRIP INTERCONNECTION (W) CONTROL RACK ANALOG TERMINAL STRIP INTERCONNECTION MOD-0A 200 KW WIND TURBINE GENERATOR
1016F27	1	CF759049	1	E	(NASA) ELECTRICAL-ELECTRICAL CONNECTION DIAGRAM AMPLIFIER PANEL (W) ELECTRICAL CONNECTION DIAGRAM AMPLIFIER PANEL MOD-0A KW WIND TURBINE GENERATOR
1016F28	4	CF760480	3	-	(NASA) ELECTRICAL-INTRUSION ALARM (W) INTRUSION ALARM SYSTEM ALARM SYSTEM & ELEC. ELEMENTARY CONNECTION DIAGRAM & INSTALLATION DETAIL MOD-0A 200 KW WTG
1016F30	1	CD760481 CD760482	1 1	B -	(NASA) ELECTRICAL-MICROPROCESSOR TIMER-CARD SCHEMATIC (NASA) ELECTRICAL-MICROPROCESSOR RELAY-CARD SCHEMATIC (W) MICROPROCESSOR TIMER-CARD AND RELAY-CARD SCHEMATIC MOD-0A 200 KW WTG
1016F31	1	CF760494	1	B	(NASA) ELECTRICAL-ELAPSE TIME PANEL (W) ELAPSE TIME PANEL MOD-0A 200 KW WIND TURBINE GENERATOR
1016F32	1	CF760495	1	C	(NASA) ELECTRICAL-RECLOSER & CIRCUIT BREAKER NO. 2 ELEMENTARY & WIRING DIAGRAMS (W) RECLOSER & CIRCUIT BREAKER NO. 2 ELEMENTARY & WIRING DIAGRAMS MOD-0A 200 KW WIND TURBINE GENERATOR
1016F33	1	CF760496	1	D	(NASA) ELECTRICAL-CLIMATRONICS & REFERENCE PANEL CONNECTION DIAGRAM (W) ELECTRICAL CONNECTION DIAGRAM CLIMATRONICS & REFERENCE PANEL MOD-0A 200 KW WIND TURBINE GENERATOR
1016F34	1	CF760497	1	B	(NASA) ELECTRICAL-PITCH CONTROLLER INTERNAL TERMINATIONS (W) PITCH CONTROLLER INTERNAL TERMINATIONS MOD-0A 200 KW WTG

*All Westinghouse Drawings are Revision -

Sheet 13

Table 1 (Cont'd)

LIST OF DRAWINGS FOR THE MOD-OA 200 kW WIND TURBINE GENERATOR
CORRELATION OF WESTINGHOUSE DRAWINGS TO NASA LEWIS RESEARCH CENTER DRAWINGS

WESTINGHOUSE DRAWING NUMBER	NUMBER OF SHTS.	NASA LEWIS DRAWING NUMBER	NUMBER OF SHTS.	*REV.	TITLE OF DRAWING
1016F35	1	CF760546	1	-	(NASA) ELECTRICAL-SYNCHRO-D.C. CONVERTER-AEROVANE TRANSLATER SCHEMATIC (W) SYNCHRO-D.C. CONVERTER AEROVANE TRANSLATOR SCHEMATIC MOD-OA 200 kW WIND TURBINE GENERATOR
1016F36	1	CF760552	1	-	(NASA) DAYTRONICS CONNECTION DIAGRAM-ELECTRICAL (W) DAYTRONICS CONNECTION DIAGRAM MOD-OA 200 kW WTG

*All Westinghouse Drawings are Revision -

Sheet 14 of 14

TABLE 2
LIST OF DRAWINGS FOR THE MOD-OA 200 KW WIND TURBINE GENERATOR
CORRELATION OF NASA LEWIS RESEARCH CENTER DRAWINGS TO WESTINGHOUSE DRAWINGS

NASA LEWIS DRAWING NUMBER	NUMBER OF SHTS.	*REV	WESTINGHOUSE DRAWING NUMBER	NUMBER OF SHTS.	TITLE OF DRAWING
CD758836	1	A	1015F02	1	(NASA) HUB FORGING (W) HUB PITCH FORGING MOD OA-200 KW WIND TURBINE GENERATOR
CR758862	1	F	1015F01	11	(NASA) MOD-OA 200 KW WIND TURBINE GENERATOR ASSEMBLY (W) ASSEMBLY MOD-OA 200 KW WIND TURBINE GENERATOR
CR758863	1	G	1015F01	11	(NASA) MOD-OA 200 KW WIND TURBINE GENERATOR ASSEMBLY (W) ASSEMBLY MOD-OA 200 KW WIND TURBINE GENERATOR
CR758864	1	D	1015F03	4	(NASA) ASSEMBLY-GEAR TYPE PITCH CONTROL HUB (W) PITCH CONTROL HUB ASS'Y MOD-OA 200 KW WIND TURB. GEN.
CF758865	1	B	1015F04	1	(NASA) ASSEMBLY-GEAR TYPE PITCH CONTROL HUB - DETAIL 1 (W) HUB PITCH DETAIL MOD-OA 200 KW WIND TURBINE GENERATOR
CD758866	1	A	1015F05	1	(NASA) ASSEMBLY-GEAR TYPE PITCH CONTROL HUB - DETAIL 2 (W) BLADE SPINDLE SLEEVE MOD-OA 200 KW WIND TURBINE GEN.
CD758867	1	D	1015F06	1	(NASA) ASSEMBLY-GEAR TYPE PITCH CONTROL HUB - DETAIL 3 (W) BLADE SPINDLE HOUSING MOD-OA 200 KW WIND TURBINE GEN.
CD758868	1	C	1015F07	1	(NASA) ASSEMBLY-GEAR TYPE PITCH CONTROL HUB - DETAIL 4 (W) DRIVE SHAFT BEARING RETAINER MOD-OA 200 KW WTG
CD758869	1	B	1015F08	1	(NASA) ASS'Y-GEAR TYPE PITCH CONTROL HUB-DETAILS 5 THRU 11 (W) HUB PITCH DETAILS MOD-OA 200 KW WIND TURBINE GENERATOR
CD758870	1	A	1015F09	1	(NASA) ASSEMBLY-GEAR TYPE PITCH CONTROL HUB - DETAIL 12 (W) HUB PITCH DRIVE SHAFT MOD-OA 200 KW WIND TURBINE GEN.
CC758871	1	A	1015F68	1	(NASA) DETAILS (W) HUB PITCH DETAILS MOD-OA 200 KW WIND TURBINE GENERATOR

*All Westinghouse Drawings are Revision - (i.e., Unrevised)

Sheet 1 of 17

TABLE 2 (Cont'd.)
LIST OF DRAWINGS FOR THE MOO-OA 200 kW WIND TURBINE GENERATOR
CORRELATION OF NASA LEWIS RESEARCH CENTER DRAWINGS TO WESTINGHOUSE DRAWINGS

ASA LEWIS DRAWING NUMBER	NUMBER OF SHTS.	REV	WESTINGHOUSE DRAWING NUMBER	NUMBER OF SHTS.	TITLE OF DRAWING
CD758872	1	C	1015F10	1	(NASA) ASSEMBLY-GEAR TYPE PITCH CONTROL HUB - DETAIL 15 (W) HUB PITCH BEVEL PINION GEAR MOO-OA 200 kW WTG
CD758873	1	C	1015F11	1	(NASA) ASSEMBLY-GEAR TYPE PITCH CONTROL HUB - DETAIL 16 (W) HUB PITCH BEVEL GEAR SECTOR MOO-OA 200 kW WTG.
CF758874	1	C	1015F12	1	(NASA) ASS'Y-GEAR TYPE PITCH CONTROL HUB-DETAILS 17 THRU 25 (W) HUB PITCH DETAILS MOO-OA 200 kW WIND TURBINE GENERATOR
CD758875	1	C	1015F03	4	(NASA) SUB-ASSEMBLY BEARING & GEAR ADJUSTMENT (W) PITCH CONTROL HUB ASS'Y MOO-OA 200 kW WIND TURB. GEN.
CR758877	1	E	1015F14	6	(NASA) BEDPLATE (W) BEDPLATE MOO-OA 200 kW WIND TURBINE GENERATOR
CR758878	1	D	1015F15	3	(NASA) FWD CENTER SHROUD (W) FORWARD CENTER SHROUD MOO-OA 200 kW WIND TURBINE GEN.
CR758879	1	E	1015F16	4	(NASA) REAR CENTER SHROUD (W) REAR CENTER SHROUD MOO-OA 200 kW WIND TURB. GENERATOR
CF758880	1	A	1015F17	1	(NASA) NOSE CONE (W) NOSE CONE MOO-OA 200 kW WIND TURBINE GENERATOR
CF758881	1	C	1015F18	1	(NASA) PROP CONE (W) PROP CONE (SPINNER) MOO-OA 200 kW WIND TURBINE GEN.
CD758882	1	B	1015F19	1	(NASA) PROP HUB & CONE COVER PLATE (W) BLADE OPENING COVERS MOO-OA 200 kW WIND TURBINE GEN.
CD758883	1	-	1015F20	1	(NASA) CONE SUPPORT DETAILS (W) CONE SUPPORT DETAILS MOO-OA 200 kW WIND TURBINE GEN.
CD758884	1	A	1015F21	1	(NASA) FRONT HUB SUPPORT (W) MOUNTING PANEL-PROP CONE MOO-OA 200 kW WIND TURB. GEN.

* All Westinghouse Drawings are Revision -

Sheet 2

TABLE 2 (Cont'd.)
LIST OF DRAWINGS FOR THE MOD-0A 200 KW WIND TURBINE GENERATOR
CORRELATION OF NASA LEWIS RESEARCH CENTER DRAWINGS TO WESTINGHOUSE DRAWINGS

ASA LEWIS WING NUMBER	NUMBER OF SHTS.	REV	WESTINGHOUSE DRAWING NUMBER	NUMBER OF SHTS.	TITLE OF DRAWING
C0758885	1	-	1015F22	1	(NASA) REAR HUB SUPPORT (W) SUPPORT-PROP CONE MOD-0A 200 KW WIND TURBINE GENERATOR
CF758885	1	C	1015F23	2	(NASA) WALKWAYS (W) WALKWAYS MOD-0A 200 KW WIND TURBINE GENERATOR
CF758887	1	A	1015F24	1	(NASA) ADJ. GENERATOR BOTTOM PLATE (W) BOTTOM PLATE-GENERATOR ADJUSTMENT MOD-0A 200 KW WTG
CF758888	1	A	1015F25	1	(NASA) ADJ. GEN. TOP & LOCK BAR (W) GENERATOR ADJUSTMENT DETAILS
CF758889	1	C	1015F26	1	(NASA) DETAILS (W) DETAILS MOD-0A 200 KW WIND TURBINE GENERATOR
CF758890	1	C	1015F27	1	(NASA) MAIN DRIVE SHAFT (W) MAIN DRIVE SHAFT MOD-0A 200 KW WIND TURBINE GENERATOR
C0758892	1	-	1015F28	1	(NASA) BRAKE SUPPORT (W) BRAKE SUPPORT MOD-0A 200 KW WIND TURBINE GENERATOR.
C0758895	1	-	1015F29	1	(NASA) PULLEY DRIVE SHAFT (W) PULLEY DRIVE SHAFT MOD-0A 200 KW WIND TURB. GENERATOR
CR758896	1	E	1015F30	2	(NASA) MAIN YAW BRG SUPPORT (W) MAIN YAW BRG SUPPORT MOD-0A 200 KW WIND TURBINE GEN.
CF758897	1	A	1015F31	1	(NASA) YAW DRIVE BRG HOUSING (W) YAW DRIVE BRG HOUSING MOD-0A 200 KW WIND TURBINE GEN.
CF758898	1	-	1015F32	1	(NASA) YAW DRIVE SHAFT (W) YAW DRIVE SHAFT MOD-0A 200 KW WIND TURBINE GENERATOR
CF758899	1	-	1015F33	1	(NASA) YAW BRG RETAINER & SEAL (W) YAW-BRG RETAINERS MOD-0 200 KW WIND TURBINE GENERATOR
C0758900	1	A	1015F34	1	(NASA) INTER. YAW DRIVE SHAFT (W) INTERMEDIATE YAW DRIVE SHAFT MOD-0A 200 KW WTG

* All Westinghouse Drawings are Revision -

Sheet 3

TABLE 2 (Cont'd.)
LIST OF DRAWINGS FOR THE MOD-OA 200 KW WIND TURBINE GENERATOR
CORRELATION OF NASA LEWIS RESEARCH CENTER DRAWINGS TO WESTINGHOUSE DRAWINGS

SA LEWIS ING NUMBER	NUMBER OF SHTS.	REV	WESTINGHOUSE DRAWING NUMBER	NUMBER OF SHTS.	TITLE OF DRAWING
CD758901	1	B	1015F35	1	(NASA) YAW DRIVE MOUNTING (W) YAW DRIVE MOUNTING PLATE MOD-OA 200 KW WIND TUR. GEN.
CD758902	1	C	1015F36	1	(NASA) SHEAR KEY & THRUST BUTTOM (W) SHEAR KEY & THRUST BUTTOM MOD-OA 200 KW WIND TUR. GEN.
CD758903	1	B	1015F37	1	(NASA) MAIN SLIP RING SUPPORT HORIZ. (W) MAIN SLIP RING SUPPORT (HORIZ.) MOD-OA 200 KW WTG
CF758904	1	C	1015F38	2	(NASA) BREAK PRESS. SYST. (W) PIPING SCHEMATIC & PANEL LAYOUT BRAKE CHAMBER & & PRESSURIZING SYSTEM MOD-OA 200 KW WIND TURBINE GEN.
CD758905	1	-	1015F39	1	(NASA) LIFTING BOOM (W) LIFTING BOOM, U-BOLT & WIND SPEED & DIRECTIONAL MOUNT. BRACKET MOD-OA 200 KW WIND TURBINE GENERATOR
CD758906	1	-	1015F40	1	(NASA) HYD PACK SUPPORT BED (W) HYDRAULIC PACKAGE SUPPORT BED MOD-OA 200 KW WTG
CD758907	1	-	1015F39	1	(NASA) "U" BOLT - BOTTLE HOLD DOWN (W) LIFTING BOOM, U-BOLT & WIND SPEED & DIRECTIONAL MOUNT. BRACKET MOD-OA 200 KW WIND TURBINE GENERATOR
CD758908	1	A	1015F42	1	(NASA) HYD PACK FAN SHROUD (W) HYDRAULIC PACKAGE FAN SHROUD MOD-OA 200 KW WTG
CD758909	1	B	1015F41	1	(NASA) LIFTING BEAM & SLING ASSEMBLY (W) LIFTING BEAM & SLING ASSEMBLY MOD-OA 200 KW WTG
CF758910	1	B	1015F44	1	(NASA) DETAILS (W) HIGH SPEED BRADE DETAILS MOD-OA 200 KW WIND TURB. GEN.

* All Westinghouse Drawings are Revision -

Sheet 4 of

TABLE 2 (Cont'd.)
LIST OF DRAWINGS FOR THE MOD-0A 200 kW WIND TURBINE GENERATOR
CORRELATION OF NASA LEWIS RESEARCH CENTER DRAWINGS TO WESTINGHOUSE DRAWINGS

SA LEWIS ING NUMBER	NUMBER OF SHTS.	REV	WESTINGHOUSE DRAWING NUMBER	NUMBER OF SHTS.	TITLE OF DRAWING
CF758912	1	A	1015F45	1	(NASA) ROTARY COUPLING SUPPORT (W) DEUBLIN CPLG SUPPORT BRACKET MOD-0A 200 kW MTG
C0758913	1	B	1015F46	1	(NASA) LADDER (W) LADDER WELDED ASSEMBLY MOD-0A 200 kW MTG
C0758914	1	-	1015F47	1	(NASA) REAR PROP CONE SUPPORTS (W) REAR PROP CONE SUPPORT MOD-0A 200 kW MTG
C0758915	1	A	1015F48	1	(NASA) HYD SUPPLY CLAMP & SUPPORTS (W) HYDRAULIC SUPPLY CLAMP & SUPPORT MOD-0A 200 kW MTG
C0758916	1	C	1015F49	1	(NASA) CO AXIAL FLOW LINE ASSEMBLY (W) CO AXIAL FLOW LINE - ASSEMBLY & DETAIL MOD-0A 200 kW MTG
C0758919	1	A	1015F50	1	(NASA) SPINNER RAIN GUARD (W) SPINNER RAIN GUARD MOD-0A 200 kW MTG
CF758920	1	A	1015F51	1	(NASA) SLIP RING ANTI-ROTATION & BRKT. (W) SLIP RING ANTI-ROTATION SUPPORT & BRKT. MOD-0A 200 kW MTG
CF758921	1	A	1015F52	3	(NASA) HYDRAULIC PUMP PACKAGE ASSEMBLY (W) HYDRAULIC PUMP PACKAGE ASSY MOD-0A 200 kW MTG
CF758922	1	A	1015F52	3	(NASA) HYDRAULIC PUMP PACKAGE ASSEMBLY (W) HYDRAULIC PUMP PACKAGE ASSY MOD-0A 200 kW MTG
CF758923	1	-	1015F52	3	(NASA) HYDRAULIC PUMP PACKAGE ASSEMBLY (W) HYDRAULIC PUMP PACKAGE ASSY MOD-0A 200 kW MTG
CF758924	1	-	1015F53	2	(NASA) DETAILS (W) HYDRAULIC PUMP PACKAGED ASSY MOD-0A 200 kW MTG

* All Westinghouse Drawings are Revision -

Sheet 5

TABLE 2 (Cont'd.)

LIST OF DRAWINGS FOR THE MOD-OA 200 KW WIND TURBINE GENERATOR
CORRELATION OF WESTINGHOUSE DRAWINGS TO NASA LEWIS RESEARCH CENTER DRAWINGS

ASA LEWIS DRAWING NUMBER	NUMBER OF SHTS.	REV	WESTINGHOUSE DRAWING NUMBER	NUMBER OF SHTS.	TITLE OF DRAWING
CF758925	1	-	1015F54	1	(NASA) DETAILS (W) HYDRAULIC PUMP DETAILS MOD-OA 200 KW WIND TURB. GEN.
OR758926	1	B	1015F55	4	(NASA) ACTUATOR ASSEMBLY (W) ACTUATOR ASSEMBLY MOD-OA 200 KW WIND TURB. GEN.
CF758927	1	A	1015F56	1	(NASA) DETAILS (W) ACTUATOR ASSY DETAILS MOD-OA 200 KW WIND TURB. GEN.
CF758928	1	A	1015F57	1	(NASA) DETAILS (W) ACTUATOR ASSY DETAILS MOD-OA 200 KW WIND TURB. GEN.
CF758929	1	B	1015F58	1	(NASA) HYDRAULIC SCHEMATIC DIAGRAM (W) CONTROL SCHEMATIC DIAGRAM MOD-OA 200 KW WTG
CF758929	7	-	1015F58	1	(NASA) OPERATIONAL REQUIREMENTS & PARTS LIST (W) CONTROL SCHEMATIC DIAGRAM MOD-OA 200 KW WTG
CF758930	1	B	1015F59	1	(NASA) INTERFACE-METAL BLADE TO PITCH CONTROL HUB (W) INTERFACE-BLADE TO HUB MOD-OA 200 KW WIND TURBINE GEN.
CC758931	1	A	1015F39	1	(NASA) WIND SPEED MOUNTING BRK'D (W) LIFTING BOOM, U-BOLT & WIND SPEED & DIRECTIONAL MOUNT- BRACKET MOD-OA 200 KW WIND TURBINE GENERATOR
CD758932	1	A	1015F61	1	(NASA) UPPER BRAKE SUPPORT (W) UPPER BRAKE SUPPORT MOD OA-200 KW WIND TURBINE GEN.
CD758933	1	-	1015F62	1	(NASA) TURNTABLE BEARING & GEAR ASSY. (W) TURNTABLE BRG. & GEAR ASSY MOD-OA 200 KW WTG

* All Westinghouse Drawings are Revision -

Sheet 6

TABLE 2 (Cont'd.)
LIST OF DRAWINGS FOR THE MOD-OA 200 kW WIND TURBINE GENERATOR
CORRELATION OF NASA LEWIS RESEARCH CENTER DRAWINGS TO WESTINGHOUSE DRAWINGS

SA LEWIS ING NUMBER	NUMBER OF SHTS.	* REV	WESTINGHOUSE DRAWING NUMBER	NUMBER OF SHTS.	TITLE OF DRAWING
CD758934	1	C	1015F63	1	(NASA) LIFTING BEAM (W) LIFTING BEAM DETAILS MOD-OA 200 kW WIND TURBINE GEN.
CF758936	1	A	1015F64	1	(NASA) EXTERIOR FINISH - FIBERGLASS HOUSING (W) EXTERIOR FINISH-FIBERGLAS HOUSING MOD-OA 200 kW MTG
CC758937	1	B	1015F65	1	(NASA) TRANSFORMER BRACKETS (W) TRANSFORMER ANTI-ROTATION BRACKET & BUTTRES RING RETAINER DETAILS MOD-OA 200 kW WIND TURBINE GENERATOR
CD758938	1	-	1015F66	1	(NASA) OUTPUT SHAFT CONFIGURATION FOR DOUBLE REDUCTION WORM GEAR UNIT (W) DOUBLE REDUCTION WORM GEAR UNIT YAW DRIVE MOD-OA 200 kW WIND TURBINE GENERATOR
CF758939	1	A	1015F67	1	(NASA) TOWER SLIP RING ANTI-ROTATION ASSEMBLY (W) TOWER SLIP RING ANTI-ROTATION ASSY MOD-OA 200 kW MTG
CC758945	1	A	1015F68	1	(NASA) BUTTRES RING (W) DETAIL MOD-OA 200 kW WIND TURBINE GENERATOR
CF758946	1	B	1015F69	1	(NASA) MOD OA WIND TURBINE GENERATOR SITE PLAN & GENERAL ASSY (W) SITE PLAN & GENERAL ASSY MOD-OA 200 kW WIND TURBINE GEN.
CF758948	1	B	1015F70	4	(NASA) STRUCTURAL-TOWER ELEVATION & DETAILS (W) TOWER ELEVATIONS, PLAN & DETAILS MOD-OA 200 kW MTG
CF758949	1	A	1015F90	4	(NASA) STRUCTURAL-TOWER PLANS & DETAILS (W) TOWER ELEVATIONS, PLAN & DETAILS MOD-OA 200 kW MTG

* All Westinghouse Drawings are Revision -

Sheet 7

TABLE 2 (Cont'd.)
LIST OF DRAWINGS FOR THE MOD-OA 200 kW WIND TURBINE GENERATOR
CORRELATION OF NASA LEWIS RESEARCH CENTER DRAWINGS TO WESTINGHOUSE DRAWINGS

ASA LEWIS WING NUMBER	NUMBER OF SHTS.	REV	WESTINGHOUSE DRAWING NUMBER	NUMBER OF SHTS.	TITLE OF DRAWING
CF758950	1	A	1015F70	4	(NASA) STRUCTURAL-TOWER DETAILS (W) TOWER ELEVATIONS, PLAN & DETAILS MOD-OA 200 kW MTG
CF758952	1	-	1015F71	2	(NASA) STRUCTURAL-ASSEMBLY STAND PLAN & DETAILS (W) ASSY STAND PLAN & DETAILS MOD-OA 200 kW WIND TURB. GEN.
CD758957	1	B	1015F72	1	(NASA) SPEED INCREASER-DIMENSIONAL REQUIREMENTS (W) SPECIAL SPEED INCREASER MOD-OA 200 kW WIND TURBINE GEN.
CF758968	1	C	1016F01	4	(NASA) ELECTRICAL-INSTRUMENTATION SENSOR WIRING LIST (W) INSTRUMENTATION SENSOR WIRING LIST MOD-OA 200 kW MTG
CF758969	1	E	1016F01	4	(NASA) ELECTRICAL-INSTRUMENTATION SENSOR WIRING LIST (W) INSTRUMENTATION SENSOR WIRING LIST MOD-OA 200 kW MTG
CF758970	1	C	1016F01	4	(NASA) ELECTRICAL-INSTRUMENTATION SENSOR WIRING LIST (W) INSTRUMENTATION SENSOR WIRING LIST MOD-OA 200 kW MTG
CF758971	1	E	1015F02	1	(NASA) ELECTRICAL-POWER ONE LINE CONNECTION DIAGRAM & SCHEDULE OF DMG. (W) POWER ONE LINE CONNECTION DIAGRAM SCHEDULE OF DMG'S MOD-OA 200 kW WIND TURBINE GENERATOR
CC758972	1	A	1015F73	1	(NASA) GEAR BOX SLIP RING ASSEMBLY (W) GEAR BOX SLIP RING ASSY-ELECTRICAL MOD-OA 200 kW MTG
CF758973	1	A	1015F74 1015F79	1	(NASA) TOWER SLIP RING ASSY-ELECTRICAL (W) TOWER SLIP RING ASSY (ELEC) MOD-OA 200 kW MTG

All Westinghouse Drawings are Revision 1-

Sheet 8

TABLE 2 (Cont'd.)
LIST OF DRAWINGS FOR THE MOD-OA 200 kW WIND TURBINE GENERATOR
CORRELATION OF NASA LEWIS RESEARCH CENTER DRAWINGS TO WESTINGHOUSE DRAWINGS

ASA LEWIS DRAWING NUMBER	NUMBER OF SHTS.	REV	WESTINGHOUSE DRAWING NUMBER	NUMBER OF SHTS.	TITLE OF DRAWING
CF758974	1	B	1015F75 1015F79	1	(NASA) TOWER SLIP RING ASSY-ELECTRICAL (W) TOWER SLIP RING ASSY MOD-OA 200 kW WIND TURBINE GEN.
CR758975	1	A	1015F43	3	(NASA) SENSOR LOCATION (PLAN VIEW) (W) SENSOR LOCATION & CONDUIT ROUTING MOD-OA 200 kW WTG
CR758976	1	C	1015F43	3	(NASA) SENSOR LOCATION (ELEVATION VIEW) (W) ELECTRICAL SENSOR LOCATIONS MOD-OA 200 kW WTG
CF758977	1	C	1016F03	1	(NASA) ELECTRICAL-AUXILIARY ELECTRONIC PACKAGE CONNECTION & INTERCONNECTION DIAGRAM (W) AUXILIARY ELECTRONIC PACKAGE CONNECTION & INTERCONNECTION DIAGRAM MOD-OA 200 kW WIND TURBINE
CF758978	1	D	1016F04	2	(NASA) ELECTRICAL-SENSOR IDENTIFICATION LIST (CLAYTON) (W) SENSOR IDENTIFICATION LIST MOD-OA 200 kW WTG
CF758979	1	F	1016F05	1	(NASA) ELECTRICAL-CABLE INTERCONNECTION (W) ELECTRICAL-CABLE INTERCONNECTION MOD-OA 200 kW WTG
CF758980	1	-	1016F06	1	(NASA) ELECTRICAL-INSTRUMENTATION INTERCONNECTION DIAGRAM PHASE I TEST (W) INSTRUMENTATION INTERCONNECTION DIAGRAM LERC-ERB CW 22 PHASE I TEST MOD-OA 200 kW WIND TURBINE
CF758981	1	B	1015F76	2	(NASA) ELECTRICAL-EQUIPMENT LAYOUT, LIGHTING, GROUNDING & DETA (W) ELECTRICAL-EQUIPMENT LAYOUT, LIGHTING, GROUNDING DETAILS MOD-OA 200 kW WTG
CF758982	1	B	1015F77	2	(NASA) ELECTRICAL-POWER CONTROL & INSTRUMENTATION TERMINAL BOXES & DETAILS (W) ELECTRICAL-POWER CONTROL & INSTRUMENTATION TERMINAL BOXES MOD-OA 200 kW WTG

* All Westinghouse Drawings are Revision -

Sheet 9

TABLE 2 (Cont'd.)
LIST OF DRAWINGS FOR THE MOD-OA 200 kW WIND TURBINE GENERATOR
CORRELATION OF NASA LEWIS RESEARCH CENTER DRAWINGS TO WESTINGHOUSE DRAWINGS

ASA LEWIS WING NUMBER	NUMBER OF SHTS.	* REV	WESTINGHOUSE DRAWING NUMBER	NUMBER OF SHTS.	TITLE OF DRAWING
CF758983	1	C	1016F07	1	(NASA) ELECTRICAL-GEAR BOX SLIP RING CONNECTION DIAGRAM (W) GEAR BOX SLIP RING CONNECTION DIAGRAM MOD-OA 200 kW WTG
CF758984	1	G	1016F08	1	(NASA) ELECTRICAL-TOWER SLIP RING CONNECTION DIAGRAM (W) TOWER SLIP RING CONNECTION DIAGRAM MOD-OA 200 kW WTG
CF758985	1	A	1016F09	1	(NASA) ELECTRICAL-STATIC SHAFT TEST INTERCONNECTION DIAGRAM PHASE I TEST (W) STATIC SHAFT TEST INTERCONNECTION DIAGRAM LERC-ERB CW 22 PHASE I TEST MOD-OA 200 kW WIND TURBINE GENERATOR
CD758999	1	-	1015F78	1	(NASA) INTERMEDIATE SHAFT (W) HIGH SPEED SHAFT ASSEMBLY MOD-OA 200 kW WIND TURB. GEN.
CC759000	1	A	1015F93	1	(NASA) FLUID COUPLER ADAPTER (W) DETAILS MOD-OA 200 kW WIND TURBINE GENERATOR
CF759019	1	G	1015F80	3	(NASA) HYDRAULIC SCHEMATIC YAW BRAKE (W) YAW BRAKE HYDRAULIC SYSTEM PANEL & SCHEMATIC MOD-OA 200 kW WIND TURBINE GENERATOR
CC759020	1	-	1015F81	1	(NASA) SPACERS YAW COUPLINGS (W) DETAILS MOD-OA 200 kW WIND TURBINE GENERATOR
CF759021	1	-	1015F82	1	(NASA) PULLEY BEARING SUPPORT (W) PULLEY BEARING SUPPORT MOD-OA 200 kW WIND TURB. GEN.
CD759023	1	A	1015F83	1	(NASA) DETAILS FOR HYDRAULIC ACTUATOR (W) DETAILS FOR HYDRAULIC ACTUATOR MOD-OA 200 kW WTG
CF759024	1	A	1015F84	1	(NASA) DETAILS FOR PUMP PACKAGE (W) PUMP PACKAGE DETAILS MOD-OA 200 kW WIND TURBINE GEN.

* All Westinghouse Drawings are Revision -

Sheet 10

TABLE 2 (Cont'd.)
LIST OF DRAWINGS FOR THE MOD-OA 200 kW WIND TURBINE GENERATOR
CORRELATION OF NASA LEWIS RESEARCH CENTER DRAWINGS TO WESTINGHOUSE DRAWINGS

ASA LEWIS DRAWING NUMBER	NUMBER OF SHTS.	REV	WESTINGHOUSE DRAWING NUMBER	NUMBER OF SHTS.	TITLE OF DRAWING
CF759025	1	C	1016F10	1	(NASA) ELECTRICAL-TOWER SENSOR LOCATION PLAN, DETAILS, PIN LAYOUT & ELECTRICAL CONNECTION DIAGRAM (W) TOWER SENSOR LOCATION PLAN DETAILS, PIN LAYOUT & ELECTRICAL CONNECTION DIAG. MOD-OA 200 kW WTG
CF759026	1	E	1016F11	2	(NASA) ELECTRICAL SAFETY SHUTDOWN-ELEMENTARY DIAGRAM (W) ELECTRICAL SAFETY SHUTDOWN-ELEMENTARY DIAGRAM MOD-OA 200 kW WIND TURBINE GENERATOR
CF759027	1	F	1016F12	2	(NASA) ELECTRICAL-CONTROL ELEMENTARY DIAGRAM (W) CONTROL ELEMENTARY DIAGRAM MOD-OA 200 kW WTG
CF759028	1	D	1016F13	1	(NASA) ELECTRICAL-YAW CONTROLLER CONNECTION DIAGRAM (W) YAW CONTROLLER CONNECTION DIAGRAM MOD-OA 200 kW WTG
CF759029	1	A	1016F14	1	(NASA) ELECTRICAL-MICROPROCESSOR FLOW DIAGRAM (W) MICROPROCESSOR FLOW DIAGRAM MOD-OA 200 kW WTG
CF759030	1	C	1016F15	1	(NASA) ELECTRICAL-CONNECTION DIAGRAM FOR PITCH CONTROLLER (W) ELECTRICAL CONNECTION DIAGRAM PITCH CONTROLLER MOD-OA 200 kW WIND TURBINE GENERATOR
CF759031	1	E	1016F16	1	(NASA) ELECTRICAL-MICROPROCESSOR BLOCK DIAGRAM (W) MICROPROCESSOR BLOCK DIAGRAM MOD-OA 200 kW WTG
CF759032	1	E	1016F17	1	(NASA) ELECTRICAL-SUPERVISORY CONTROLLER INTERCONNECTION CENTRAL & REMOTE (W) SUPERVISORY CONTROLLER INTERCONNECT CENTRAL & REMOTES STATIONS & DETAIL "A" MOD-OA 200 kW WIND TURBINE GENERATOR
CF759033	1	E	1016F18	2	(NASA) ELECTRICAL-PITCH CONTROLLER SCHEMATIC (W) PITCH CONTROLLER SCHEMATIC MOD-OA 200 kW WTG

* All Westinghouse Drawings are Revision -

Sheet 11

TABLE 2 (Cont'd.)

LIST OF DRAWINGS FOR THE MOD-OA 200 kW WIND TURBINE GENERATOR
CORRELATION OF NASA LEWIS RESEARCH CENTER DRAWINGS TO WESTINGHOUSE DRAWINGS

NASA LEWIS DRAWING NUMBER	NUMBER OF SHTS.	REV	WESTINGHOUSE DRAWING NUMBER	NUMBER OF SHTS.	TITLE OF DRAWING
CF759034	1	F	1016F19	2	(NASA) ELECTRICAL-CONTROL PANEL LAYOUTS & RELAY PANEL CONNECTION DIAGRAMS (W) CONTROL PANEL LAYOUTS & RELAY PANEL CONNECTION DIAGRAMS MOD-OA 200 kW WIND TURBINE GENERATOR
CF759035	1	C	1016F20	7	(NASA) ELECTRICAL-480 V SWITCHGEAR ONE LINE DIAGRAM (W) 480 V SWITCHGEAR WIRING DIAGRAM UNIT NOS. 1, 2 & 3 MOD-OA 200 kW WIND TURBINE GENERATOR
CF759036	1	E	1016F20	7	(W) 480 V SWITCHGEAR WIRING DIAGRAM UNIT NOS. 1, 2 & 3 MOD-OA 200 kW WIND TURBINE GENERATOR
CF759037	1	F	1016F20	7	(W) 480 V SWITCHGEAR WIRING DIAGRAM UNIT NOS. 1, 2, & 3 MOD-OA 200 kW WIND TURBINE GENERATOR
CF759038	1	E	1016F20	7	(W) 480 V SWITCHGEAR WIRING DIAGRAM UNIT NOS. 1, 2, & 3 MOD-OA 200 kW WIND TURBINE GENERATOR

All Westinghouse Drawings are Revision -

Sheet 12

TABLE 2 (Cont'd.)
LIST OF DRAWINGS FOR THE MOD-OA 200 kW WIND TURBINE GENERATOR
CORRELATION OF NASA LEWIS RESEARCH CENTER DRAWINGS TO WESTINGHOUSE DRAWINGS

NASA LEWIS DRAWING NUMBER	NUMBER OF SHTS.	PEV	WESTINGHOUSE DRAWING NUMBER	NUMBER OF SHTS.	TITLE OF DRAWING
CF759039	1	F	1016F20	7	(W) 480 V SWITCHGEAR WIRING DIAGRAM UNIT NOS. 1, 2, & 3 MOD-OA 200 kW WIND TURBINE GENERATOR
CF759040	1	D	1016F21	3	(NASA) ELECTRICAL-CONNECTION DGM FOR TERMINAL BOXES 28 & 38 (W) CONNECTION DIAGRAMS FOR TERMINAL BOXES, 28, 38, 2A, 3A & NO. 4 MOD-OA 200 kW WIND TURBINE GENERATOR
CF759041	1	E	1016F21	3	(NASA) ELECTRICAL-CONNECTION DGM FOR TERMINAL BOXES 2A & 28 (W) CONNECTION DIAGRAMS FOR TERMINAL BOXES, 28, 38, 2A, 3A & NO. 4 MOD-OA 200 kW WIND TURBINE GENERATOR
CF759042	1	D	1016F21	3	(NASA) ELECTRICAL-CONNECTION DIAGRAM FOR TERMINAL BOXES NO. 4 (W) CONNECTION DIAGRAMS FOR TERMINAL BOXES, 28, 38, 2A, 3A & NO. 4 MOD-OA 200 kW WIND TURBINE GENERATOR
CF759043	1	F	1016F22	1	(NASA) ELECTRICAL-ELECTRICAL CONNECTION DIAGRAM SAFETY SHUTDOWN PANEL (W) ELECTRICAL CONNECTION DIAGRAM SAFETY SHUTDOWN PANEL MOD-OA 200 kW WIND TURBINE GENERATOR
CF759044	1	E	1016F23	1	(NASA) ELECTRICAL-YAW BRAKE ELEMENTARY & CONNECTION DIAGRAM (W) YAW BRAKE ELEMENTARY & CONNECTION DGM. MOD-OA 200 kW WTG
CF759045	1	C	1016F24	1	(NASA) ELECTRICAL-MICROPROCESSOR CIRCUIT CARD LOCATOR RACK A & RACK B (W) MICROPROCESSOR CIRCUIT CARD LOCATION, RACK A & RACK B MOD-OA 200 kW WIND TURBINE GENERATOR

All Westinghouse Drawings are Revision -

Sheet 13

Table 2 (Cont'd)

LIST OF DRAWINGS FOR THE MOD-OA 200 kW WIND TURBINE GENERATOR

CORRELATION OF NASA LEWIS RESEARCH CENTER DRAWINGS TO WESTINGHOUSE DRAWINGS

NASA LEWIS DRAWING NUMBER	NUMBER OF SHTS.	REV	WESTINGHOUSE DRAWING NUMBER	NUMBER OF SHTS.	TITLE OF DRAWING
CF759047	1	D	1016F25	1	(NASA) ELECTRICAL-YAW CONTROL PANEL LAYOUT (W) YAW CONTROL PANEL LAYOUT MOD-OA 200 kW WTG
CF759048	1	D	1016F26	1	(NASA) ELECTRICAL-CONTROL RACK ANALOG TERMINAL STRIP INTERCONNECTION (W) CONTROL RACK ANALOG TERMINAL STRIP INTERCONNECTION MOD-OA 200 kW WIND TURBINE GENERATOR
CF759049	1	E	1016F27	1	(NASA) ELECTRICAL-ELECTRICAL CONNECTION DIAGRAM AMPLIFIER PANEL (W) ELECTRICAL CONNECTION DIAGRAM AMPLIFIER PANEL MOD-OA 200 kW WIND TURBINE GENERATOR
CF760271	1	A	1015F85	2	(NASA) STRUCTURAL-ASSY STAND PLAN & DETAILS (W) ASSY STAND PLAN & DETAILS MOD-OA 200 kW WIND TURB. GEN.
CF760300	1	-	1015F86	2	(NASA) STRUCTURAL-TOWER & ASSY STAND-FOUNDATIONS & DETAILS- CLAYTON M.M. (W) TOWER & ASSY STAND FOUNDATION & DETAILS MOD-OA 200 kW WIND TURBINE GENERATOR
CC760476	1	-	1015F87	1	(NASA) GREASE & PRESSURE FITTINGS (W) GREASE & PRESSURE FITTINGS MOD-OA 200 kW WTG
CD760477	1	-	1015F88	1	(NASA) HUB COUNTER WEIGHTS (W) HUB COUNTER WEIGHTS MOD-OA 200 kW WIND TURBINE GEN.
CF760478	1	-	1015F89	1	(NASA) DETAILS (W) DETAILS MOD-OA 200 kW WIND TURBINE GENERATOR
CF760480	3	-	1016F28	4	(NASA) ELECTRICAL-INTRUSION ALARM (W) INTRUSION ALARM SYSTEM ALARM SYSTEM & ELEC. ELEMENTARY CONNECTION DIAGRAM & INSTALLATION DETAIL MOD-OA 200 kW WTG
CD760481	1	B	1016F30	1	(NASA) ELECTRICAL-MICROPROCESSOR TIMER-CARD SCHEMATIC (W) MICROPROCESSOR TIMER CARD-SCHEMATIC MOD-OA 200 kW WTG

*All Westinghouse Drawings are Revision -

Sheet 14

Table 2 (Cont'd)

LIST OF DRAWINGS FOR THE MOD-OA 200 KW WIND TURBINE GENERATOR
CORRELATION OF NASA LEWIS RESEARCH CENTER DRAWINGS TO WESTINGHOUSE DRAWINGS

NASA LEWIS DRAWING NUMBER	NUMBER OF SHTS.	*REV	WESTINGHOUSE DRAWING NUMBER	NUMBER OF SHTS.	TITLE OF DRAWING
CD760482	1	B	1016F30	1	(NASA) ELECTRICAL-MICROPROCESSOR RELAY-CARD SCHEMATIC (W) MICROPROCESSOR RELAY CARD SCHEMATIC MOD-OA 200 KW MTG
CF760484	1	A	1015F90	1	(NASA) HYDRAULIC SYSTEM PANEL YAW BRAKE (W) HYDRAULICS COMPONENTS MTG PANEL MOD-OA 200 KW MTG
CF760484	1	A	1015F91	1	(NASA) HYDRAULIC SYSTEM PANEL YAW BRAKE (W) HYDRAULIC SYSTEM PANEL YAW BRAKE-STRUCTURAL SUPPORT MOD-OA 200 KW WIND TURBINE GENERATOR
CF760485	1	A	1015F80	3	(NASA) HYDRAULIC SYSTEM PANEL YAW BRAKE (W) YAW BRAKE HYDRAULIC SYSTEM PANEL & SCHEMATIC MOD-OA 200 KW WIND TURBINE GENERATOR
CD760486	1	A	1015F92	1	(NASA) AIR BOTTLE GAGE BRACKET (W) AIR BOTTLE GAGE BRACKET DETAILS MOD-OA 200 KW MTG
CC760487	1	A	1015F93	1	(NASA) GEAR ALT. LOW SPEED SHAFT (W) DETAILS MOD-OA 200 KW WIND TURBINE GENERATOR
CC760488	1	A	1015F94	1	(NASA) DUBLIN MOUNT (W) DUBLIN MOUNT & SLIP RING DUST COVER MOD-OA 200 KW MTG
CB760490	1	A	1015F65	1	(NASA) BUTTRES RING RETAINER (W) TRANSFORMER ANTI-ROTATION BRACKET & BUTTRES RING RETAINER DETAILS MOD-OA 200 KW MTG
CF760491	1	-	1015F96	1	(NASA) YAW BRAKE ASSEMBLY (W) YAW BRAKE ASSY MOD-OA 200 KW WIND TURBINE GENERATOR
CD760492	1	-	1015F97	1	(NASA) YAW BRAKE DETAILS (W) YAW BRAKE DETAIL MOD-OA 200 KW WIND TURBINE GENERATOR
CD760493	1	-	1015F98	1	(NASA) YAW BRAKE DETAILS (W) YAW BRAKE DETAIL MOD-OA 200 KW WIND TURBINE GENERATOR

*All Westinghouse Drawings are Revision -

Sheet 15

Table 2 (Cont'd)

LIST OF DRAWINGS FOR THE MOD-OA 200 kW WIND TURBINE GENERATOR

CORRELATION OF NASA LEWIS RESEARCH CENTER DRAWINGS TO WESTINGHOUSE DRAWINGS

NASA LEWIS DRAWING NUMBER	NUMBER OF SHTS.	*REV	WESTINGHOUSE DRAWING NUMBER	NUMBER OF SHTS.	TITLE OF DRAWING
CF760494	1	B	1016F31	1	(NASA) ELECTRICAL-ELAPSE THE PANEL (W) ELAPSE TIME PANEL MOD-OA 200 kW WIND TURBINE GENERATOR
CF760495	1	C	1016F32	1	(NASA) ELECTRICAL-RECLOSER & CIRCUIT BREAKER NO. 2 ELEMENTARY & WIRING DIAGRAMS (W) RECLOSER & CIRCUIT BREAKER NO. 2 ELEMENTARY & WIRING DIAGRAMS MOD-OA 200 kW WIND TURBINE GENERATOR
CF760496	1	D	1016F33	1	(NASA) ELECTRICAL-CLIMATRONICS & REFERENCE PANEL CONNECTION DIAGRAM (W) ELECTRICAL CONNECTION DIAGRAM CLIMATRONICS & REFERENCE PANEL MOD-OA 200 kW WIND TURBINE GENERATOR
CF760497	1	B	1016F34	1	(NASA) ELECTRICAL-PITCH CONTROLLER INTERNAL TERMINATIONS (W) PITCH CONTROLLER INTERNAL TERMINATIONS MOD-OA 200 WTG
CC760500	1	-	1015F94	1	(NASA) SLIP RING COVER (W) DUBLIN MOUNT & SLIP RING DUST COVER MOD-OA 200 kW WTG
CC760504	1	B	1015F81	1	(NASA) HUB SEAL HOLDER (W) DETAILS MOD-OA 200 kW WIND TURBINE GENERATOR
CF760506	1	-	1015F95	2	(NASA) ELECTRICAL-LOW SPEED SHAFT STRAIN GAGE LOCATION CONNECTION DIAGRAM & INSTALLATION (W) ELECTRICAL-LOW SPEED SHAFT STRAIN GAGE LOCATION MOD-OA 200 kW WIND TURBINE GENERATOR
CC760512	1	-	1015F99	1	(NASA) FIXTURE FOR SEAL INSTALLATION (W) FIXTURES FOR SEAL INSTALLATION MOD-OA 200 kW WTG

All Westinghouse Drawings are Revision -

Sheet 16

Table 2 (Cont'd.)

LIST OF DRAWINGS FOR THE MOD-0A 200 KW WIND TURBINE GENERATOR
CORRELATION OF NASA LEWIS RESEARCH CENTER DRAWINGS TO WESTINGHOUSE DRAWINGS

NASA LEWIS DRAWING NUMBER	NUMBER OF SHTS.	*REV	WESTINGHOUSE DRAWING NUMBER	NUMBER OF SHTS.	TITLE OF DRAWING
CD760513	1	-	1015F99	1	(NASA) SEAL INSTALLATION INSTRUCTIONS (W) FIXTURES FOR SEAL INSTALLATION MOD-0A 200 KW WTG
CF760520	1	-	1015F95	2	(NASA) ELECTRICAL-LOW SPEED SHAFT STRAIN GAGE LOCATION (W) ELECTRICAL-LOW SPEED SHAFT STRAIN GAGE LOCATION MOD-0A 200 KW WIND TURBINE GENERATOR
CF760546	1	-	1016F35	1	(NASA) ELECTRICAL-SYNCHRO-D.C. CONVERTER-AEROVANE TRANSLATER SCHEMATIC (W) SYNCHRO-D.C. CONVERTER AEROVANE TRANSLATOR SCHEMATIC MOD-0A 200 KW WIND TURBINE GENERATOR
CF760552	1	-	1016F36	1	(NASA) DAYTRONICS CONNECTION DIAGRAM-ELECTRICAL (W) DAYTRONICS CONNECTION DIAGRAM MOD-0A 200 KW WTG

*All Westinghouse Drawings are Revision -


Sheet 17


10	11	12	
100	
100	
84

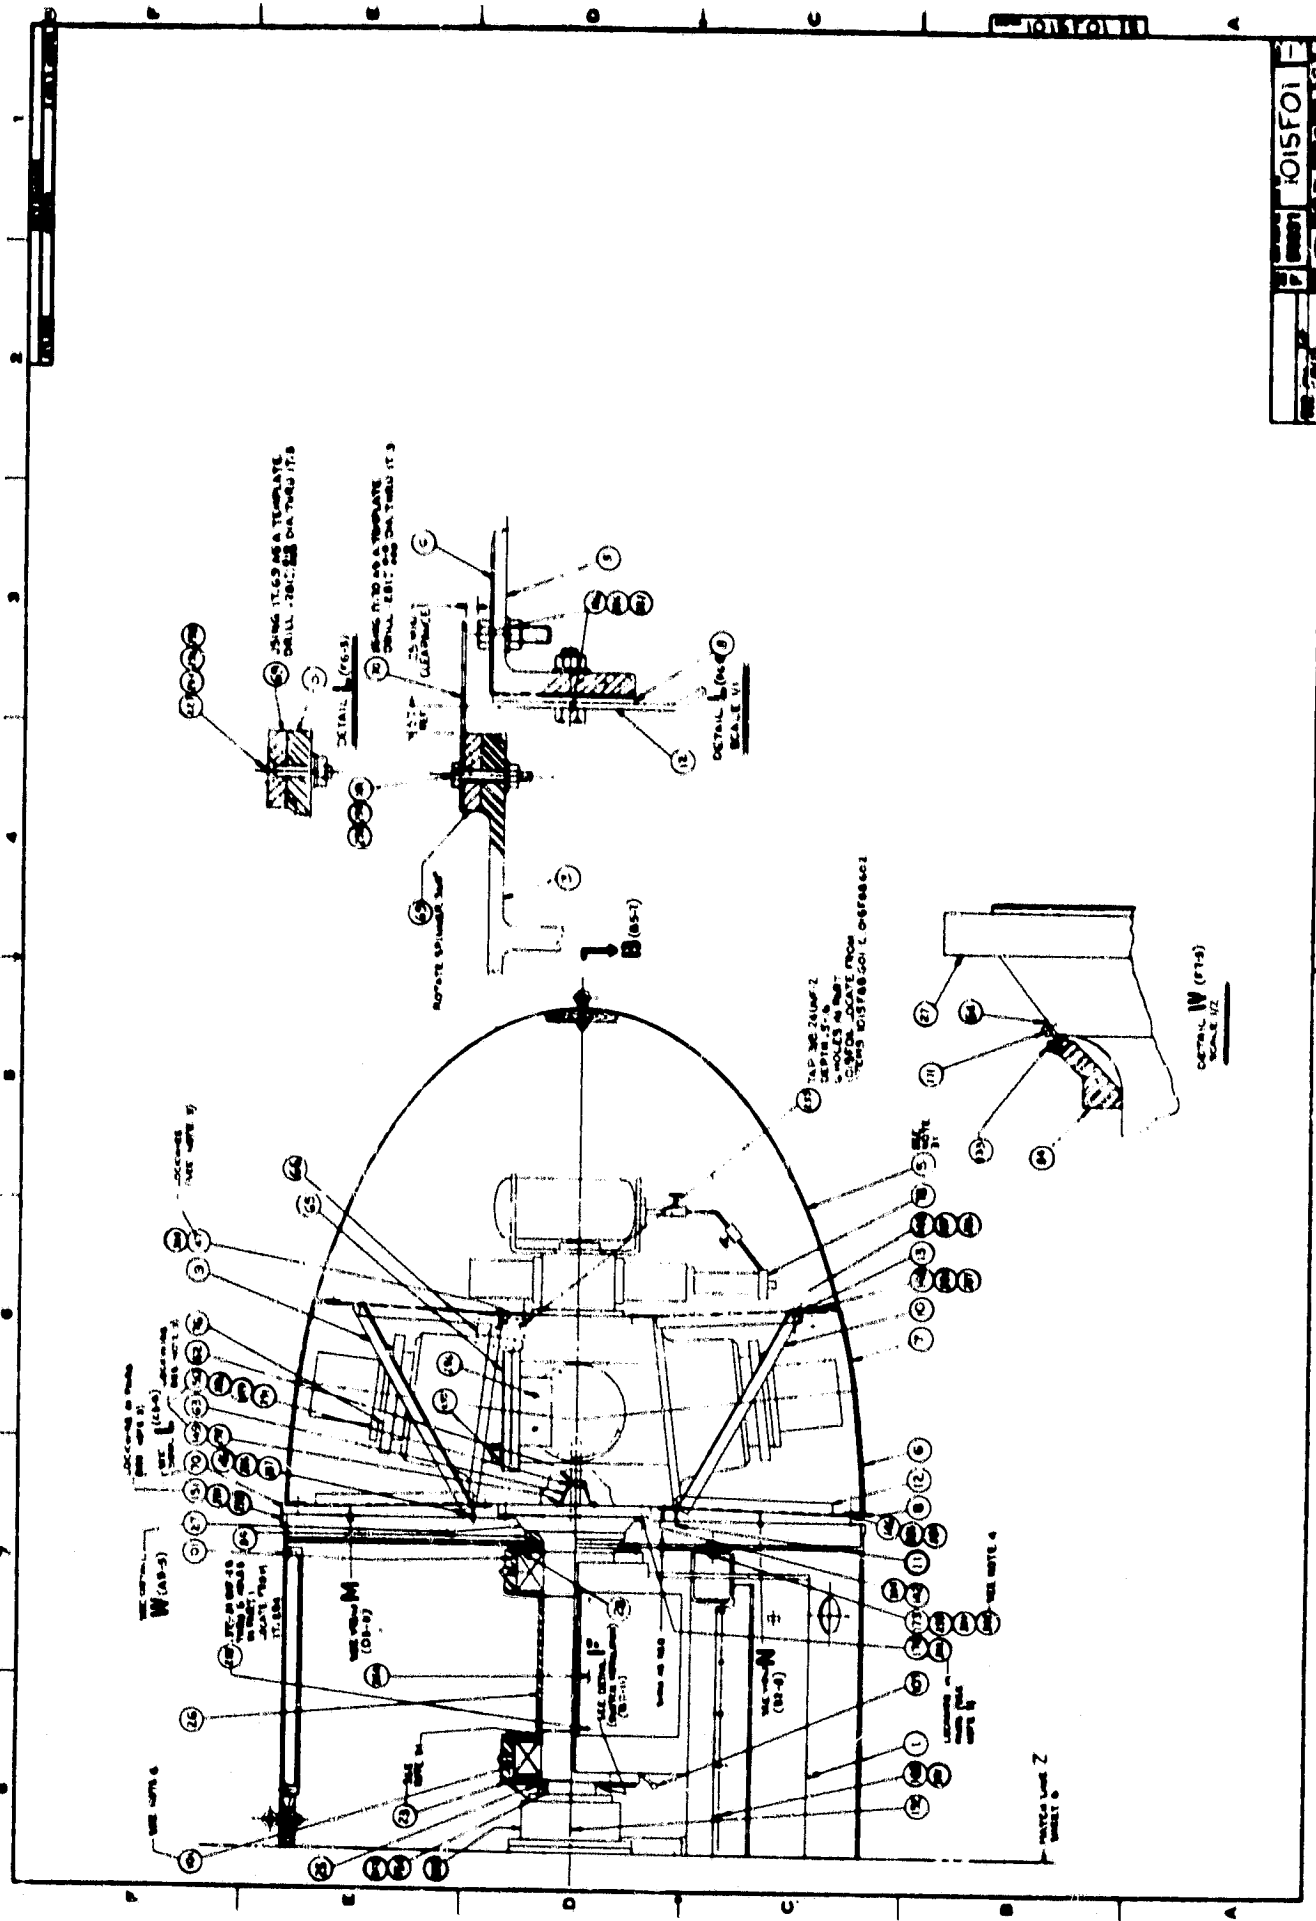

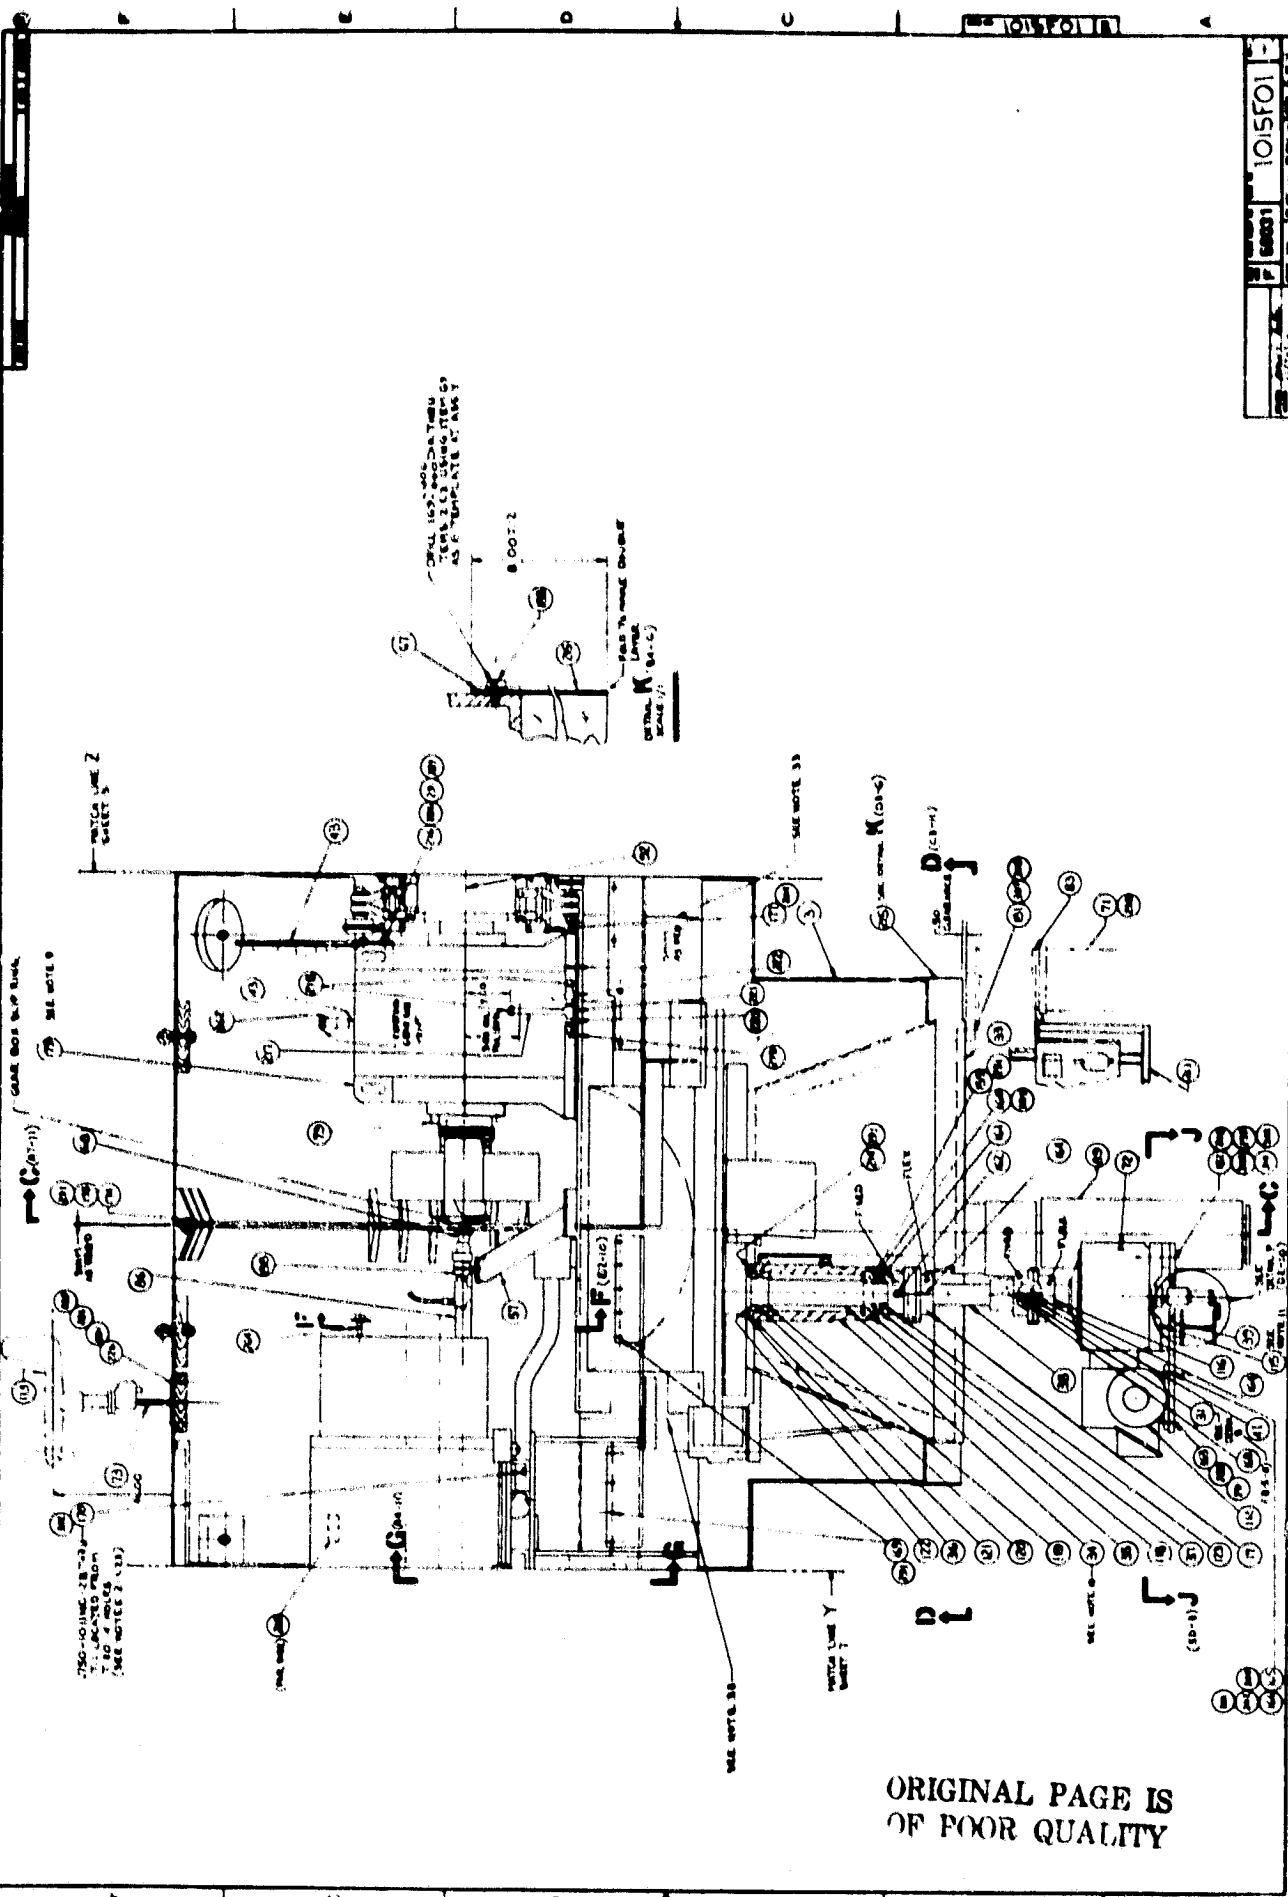


ORIGINAL PAGE IS
OF POOR QUALITY

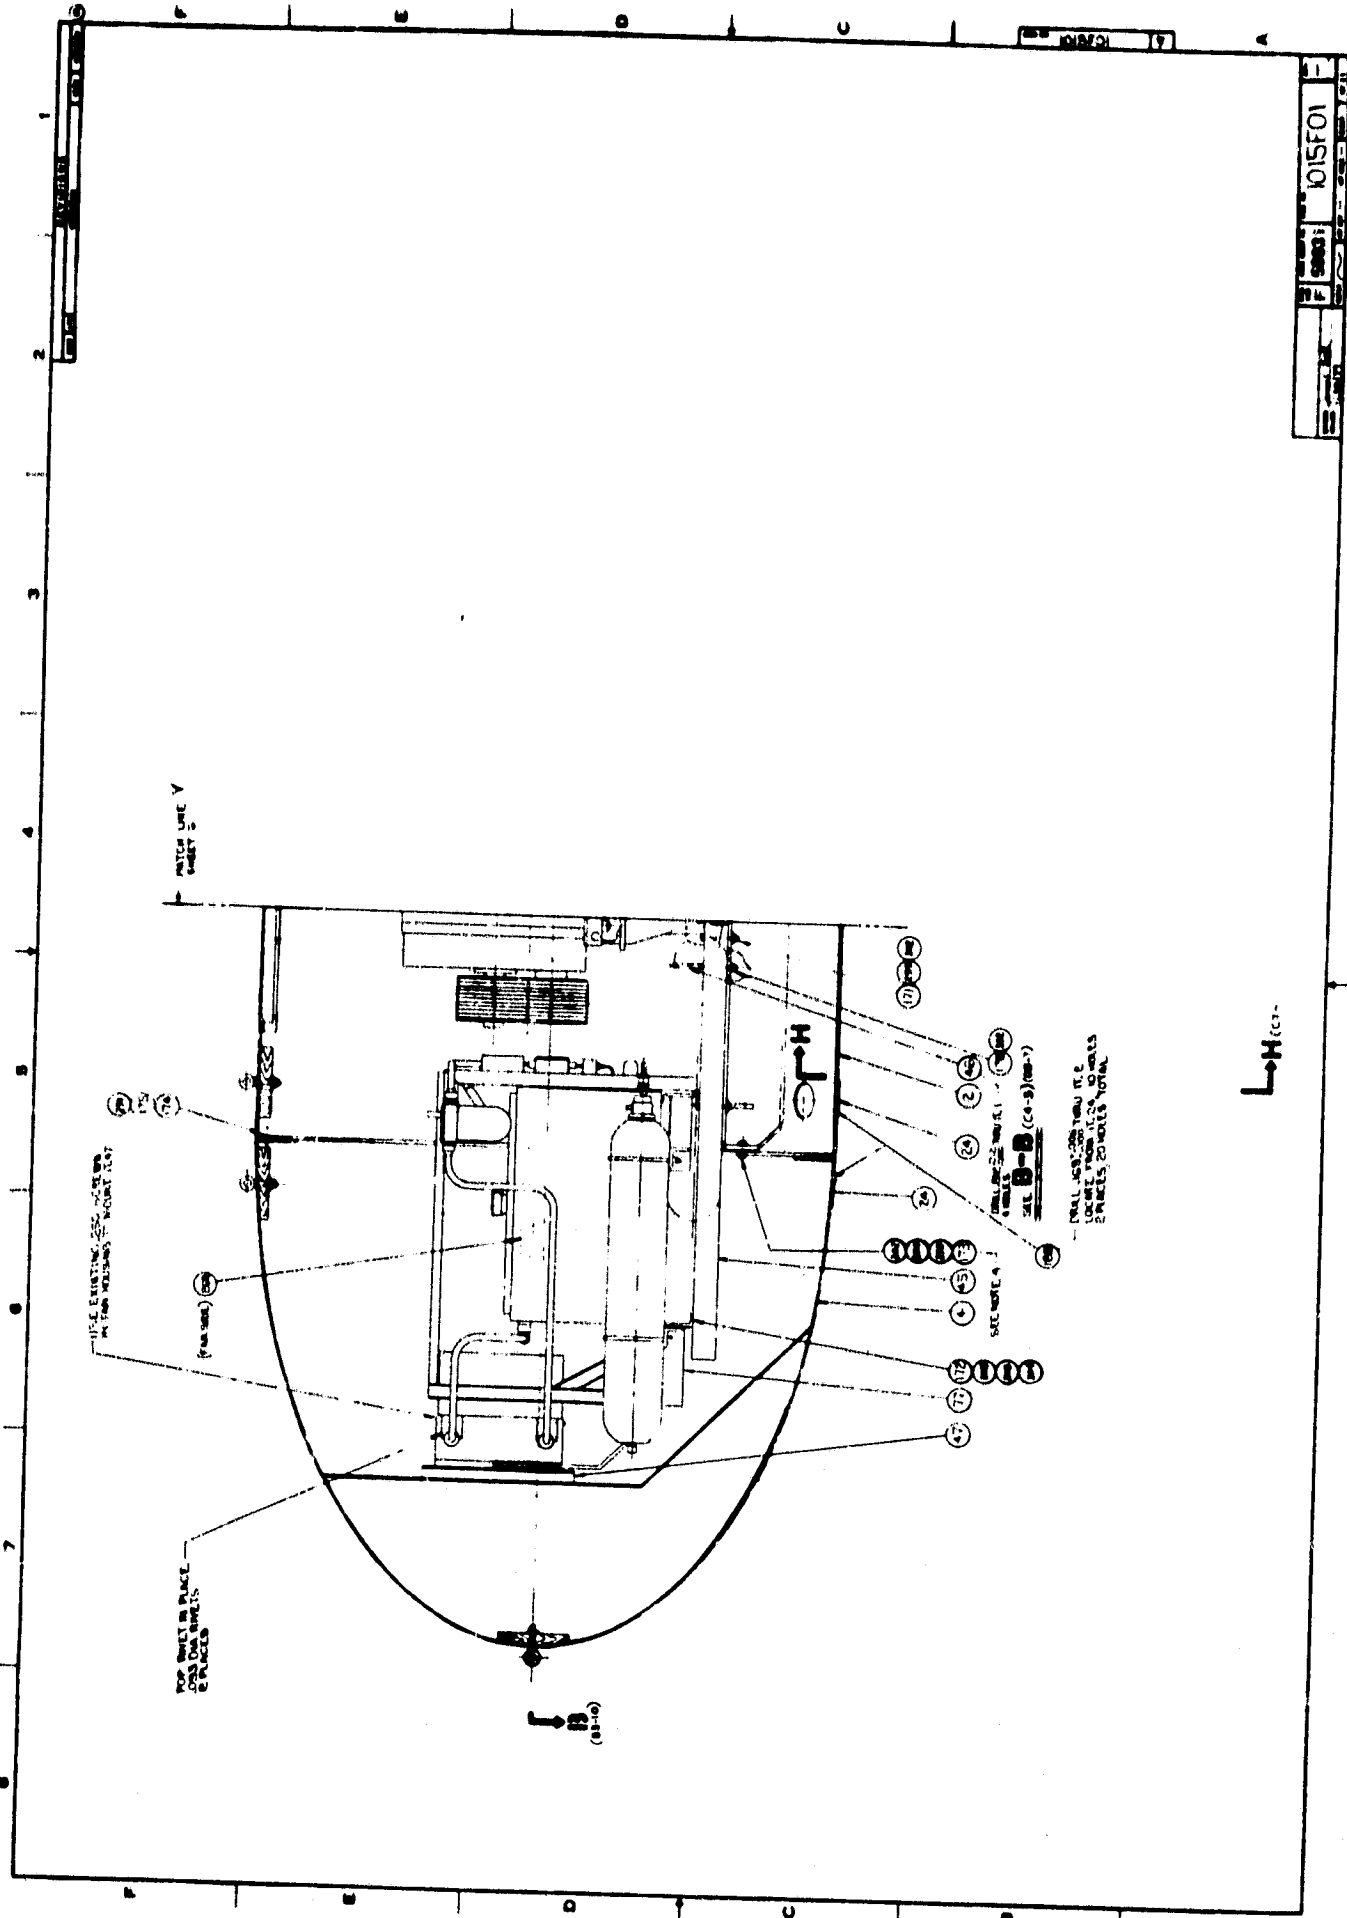


L-H (C1)


1 2 3 4 5 6 7 8

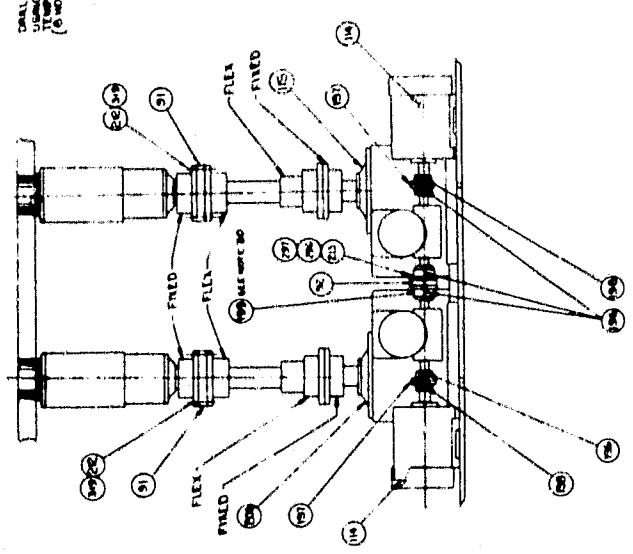

H-H (15-7)

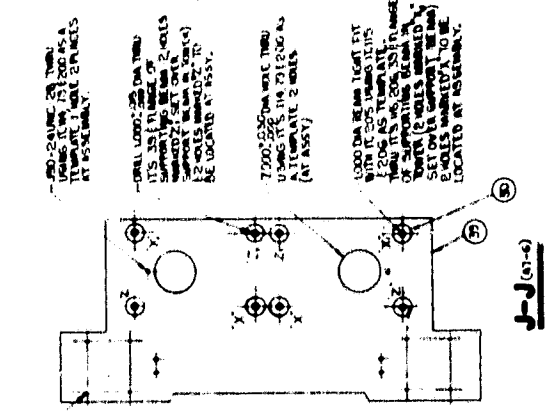


J-J (17-6)

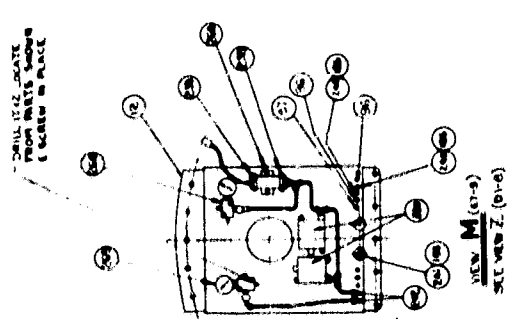


M (17-9)
SEE VIEW Z (11-6)


VIEW Z (11-6)
HUB LUBRICATION SYSTEM

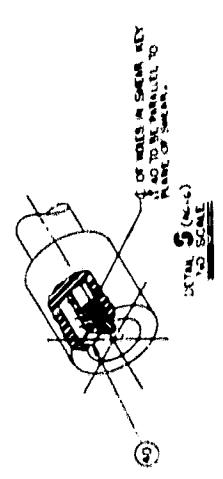

VIEW 5 (14-6)
NO SCALE

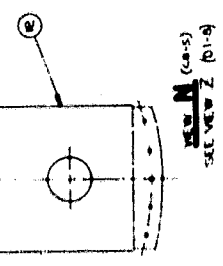


VIEW N (14-5)
SEE VIEW Z (11-6)

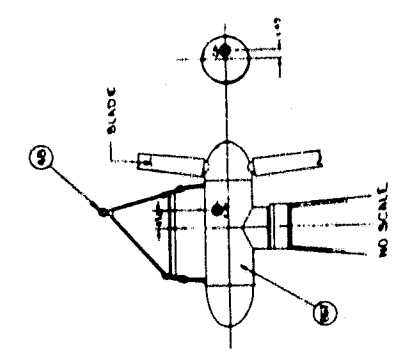


NO SCALE





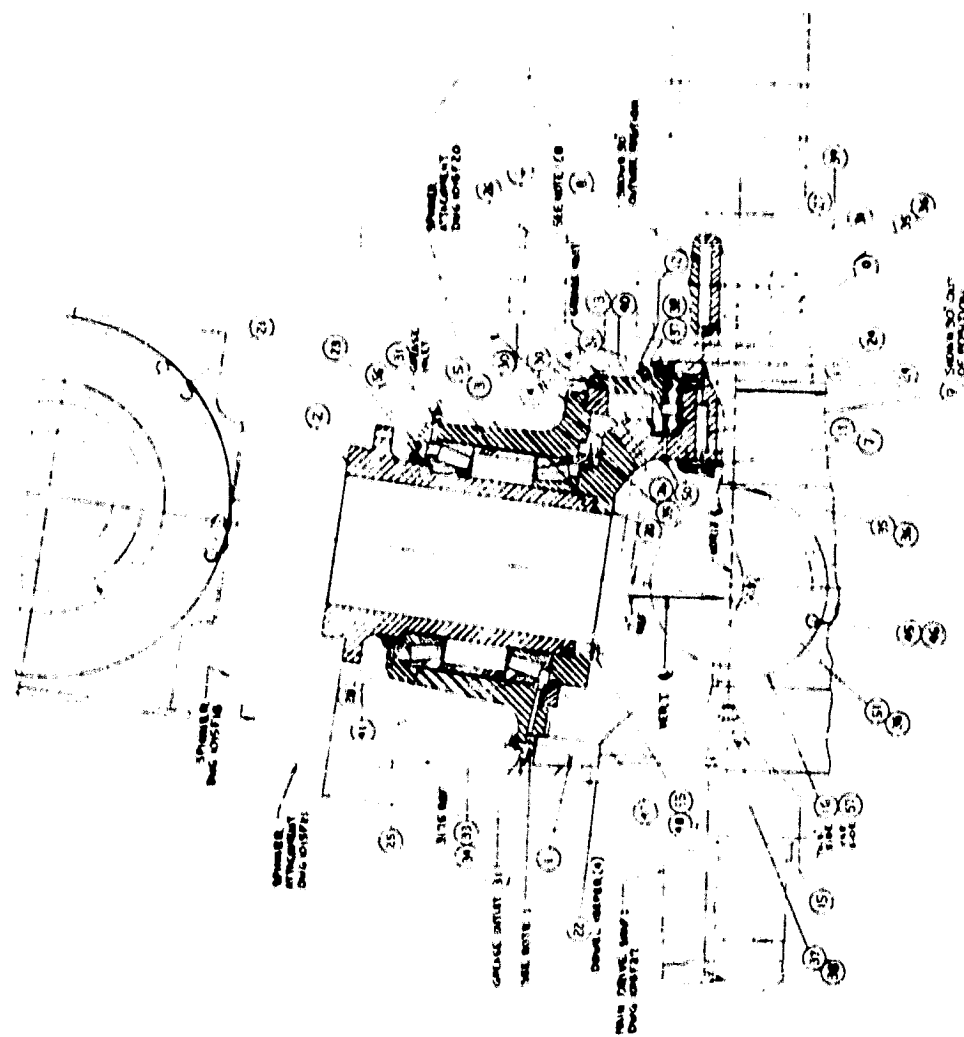


VIEW A-A (see 2)

ORIGINAL PAGE IS
OF POOR QUALITY

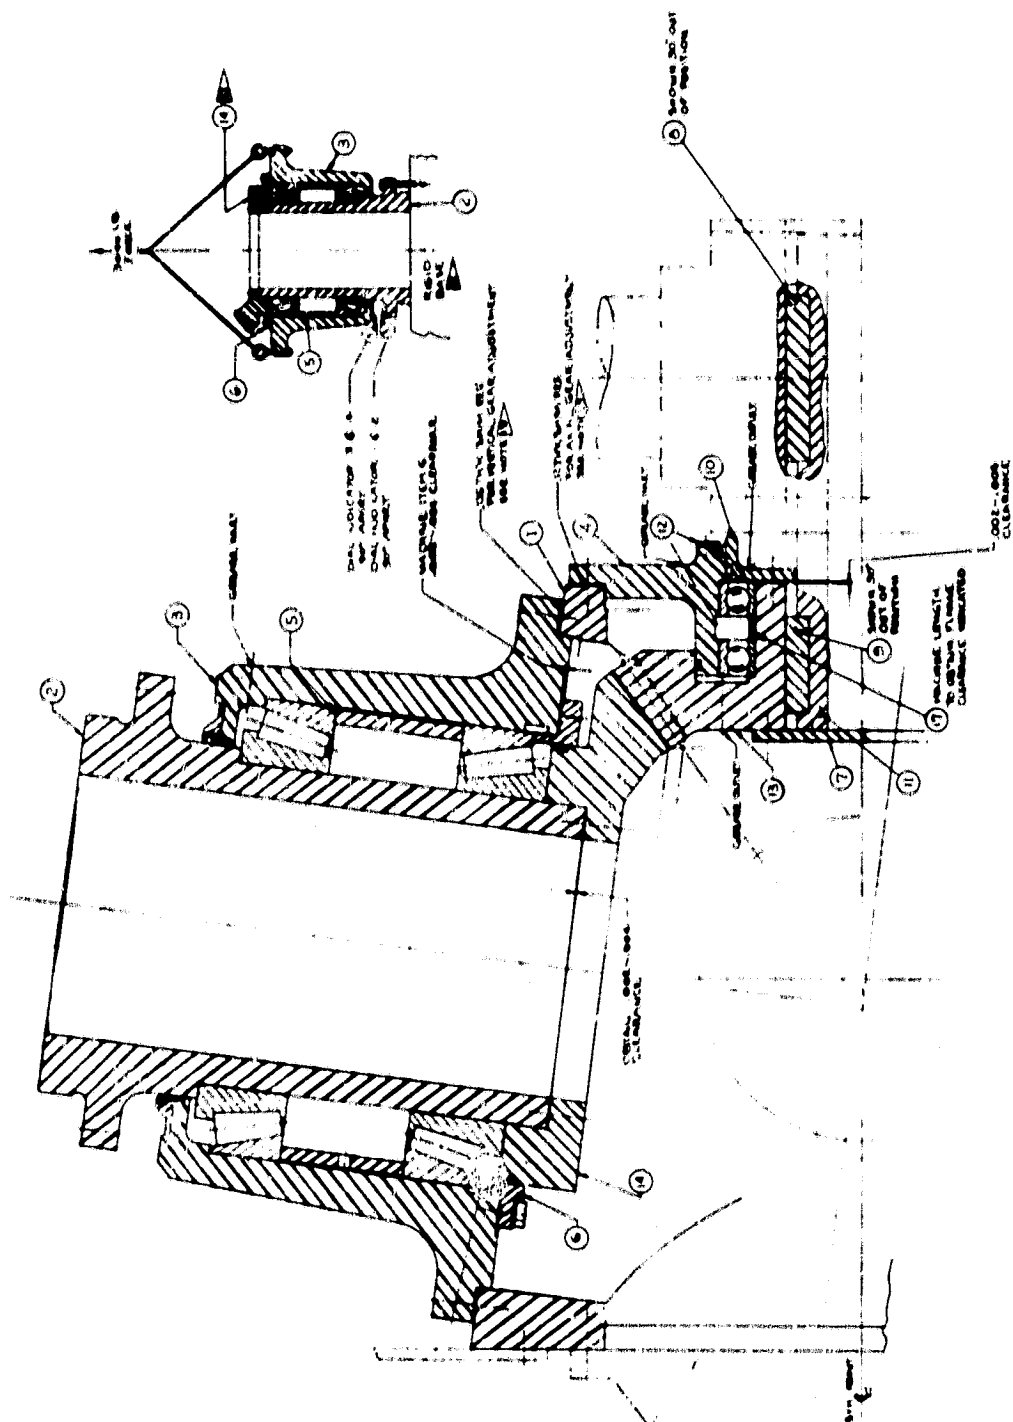

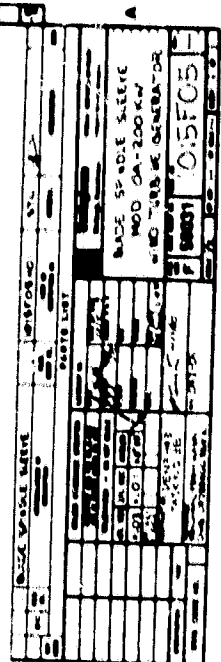

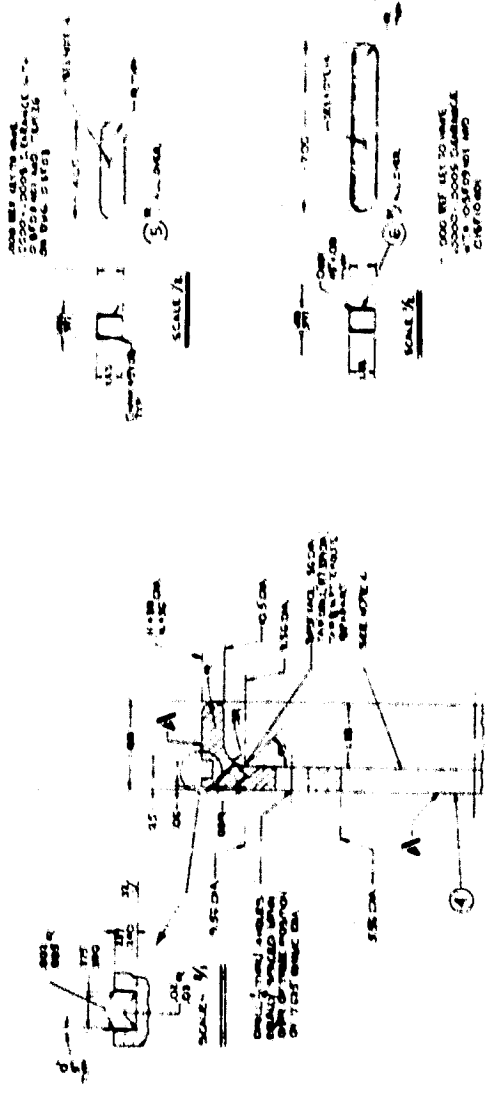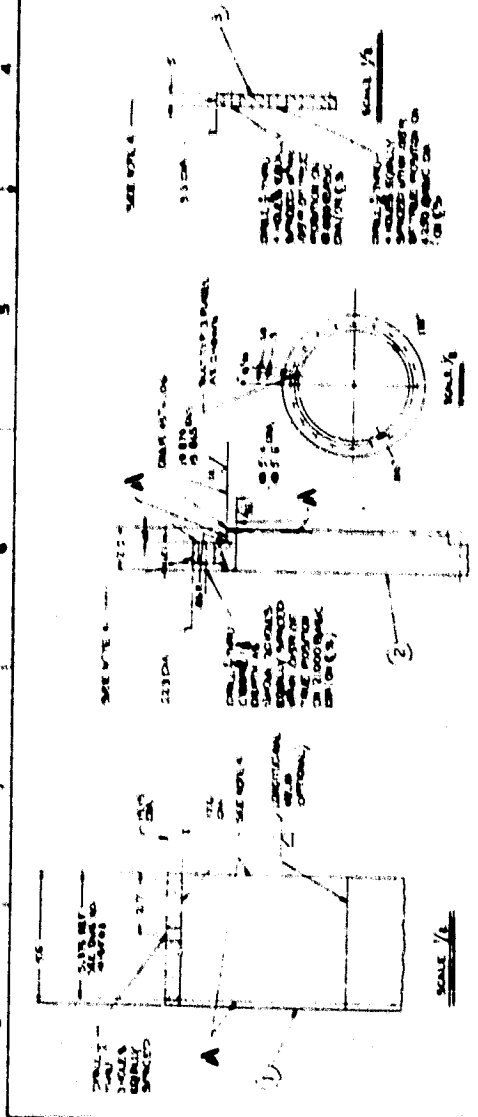

1015 F08	
1	1015 F08
2	1015 F08
1	2	
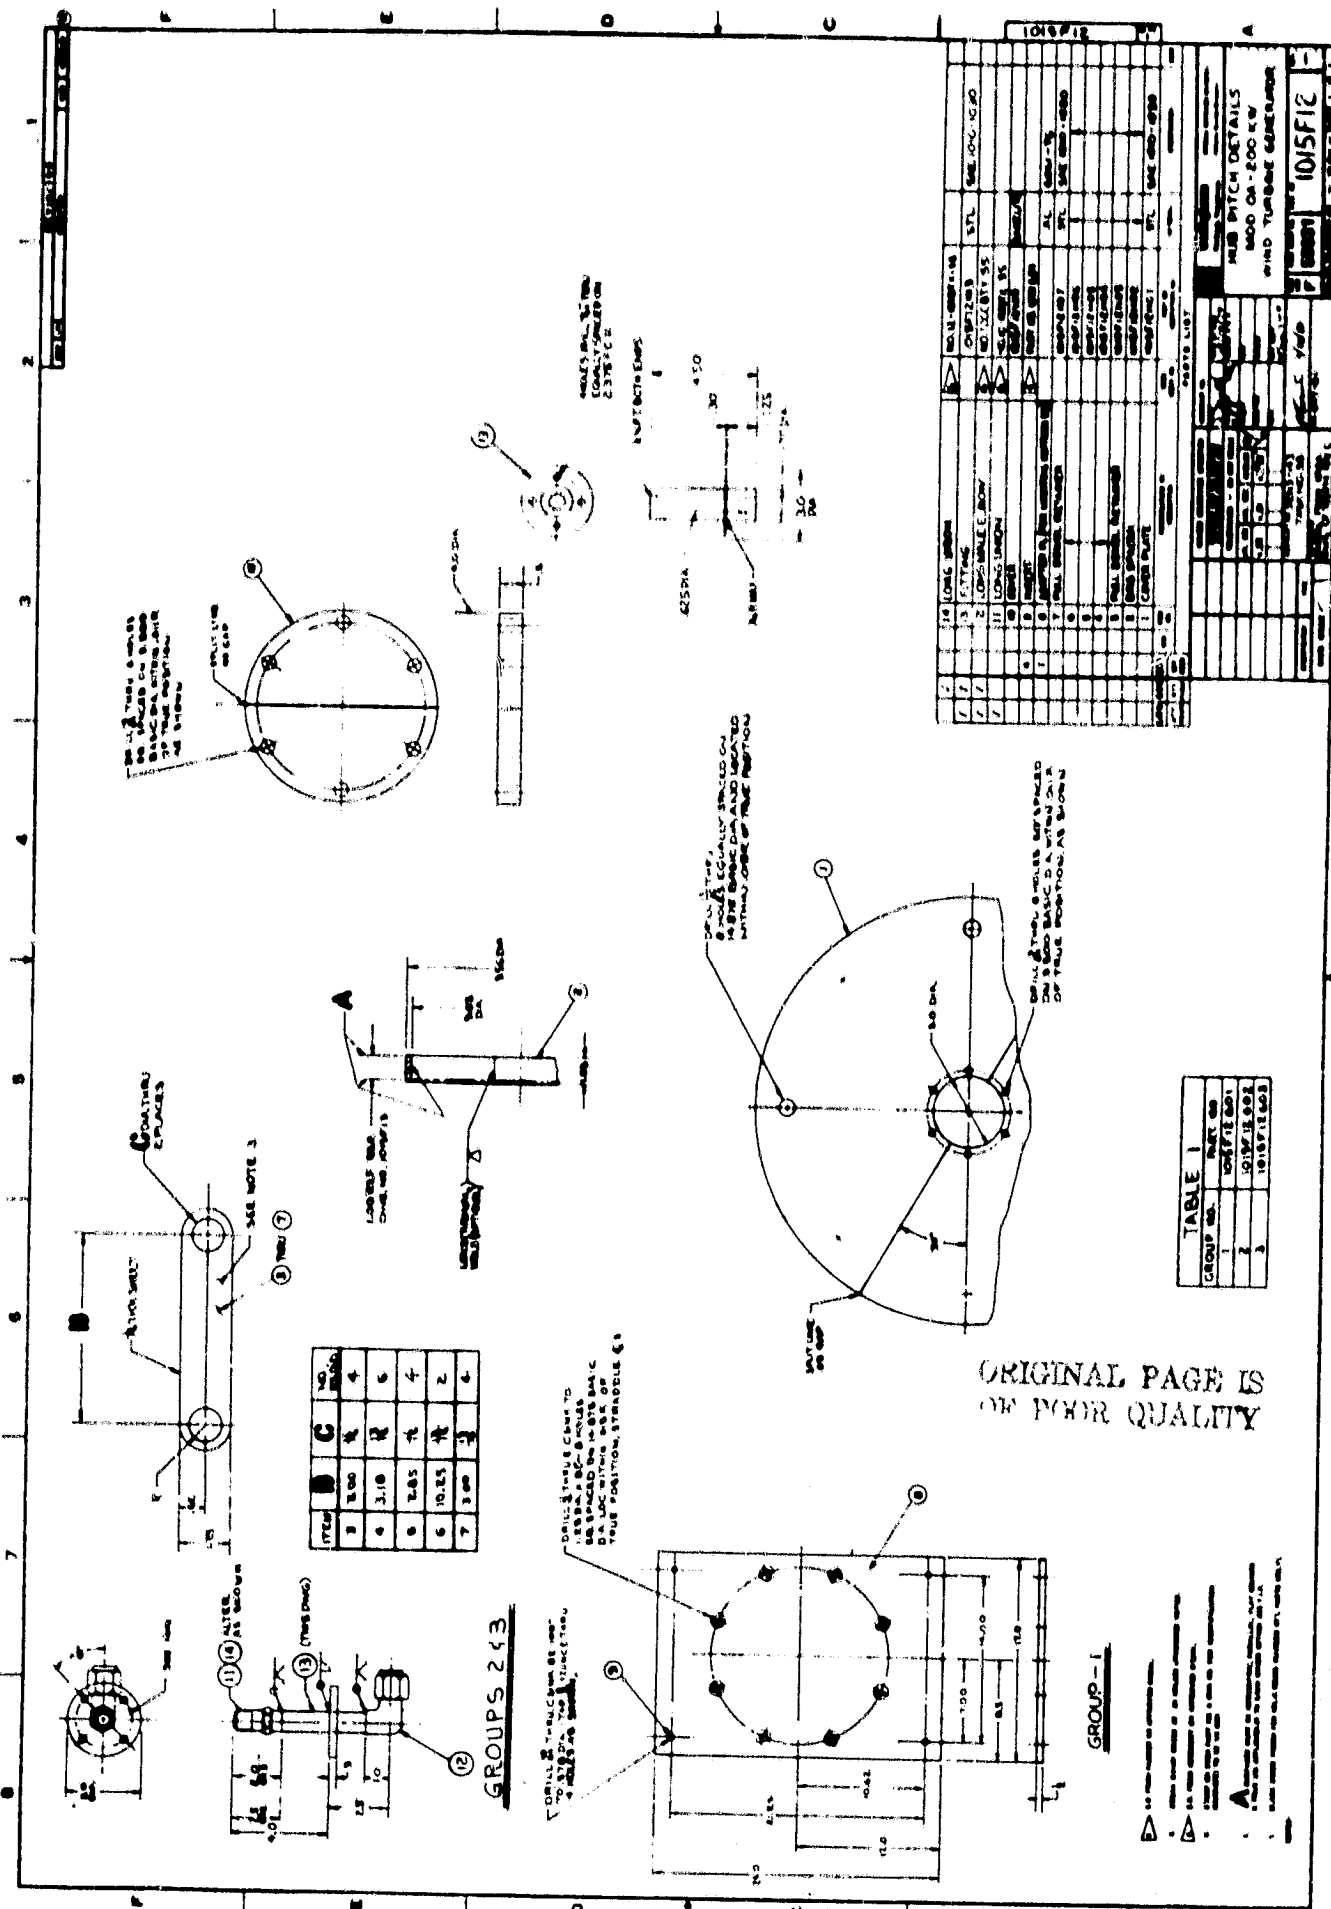

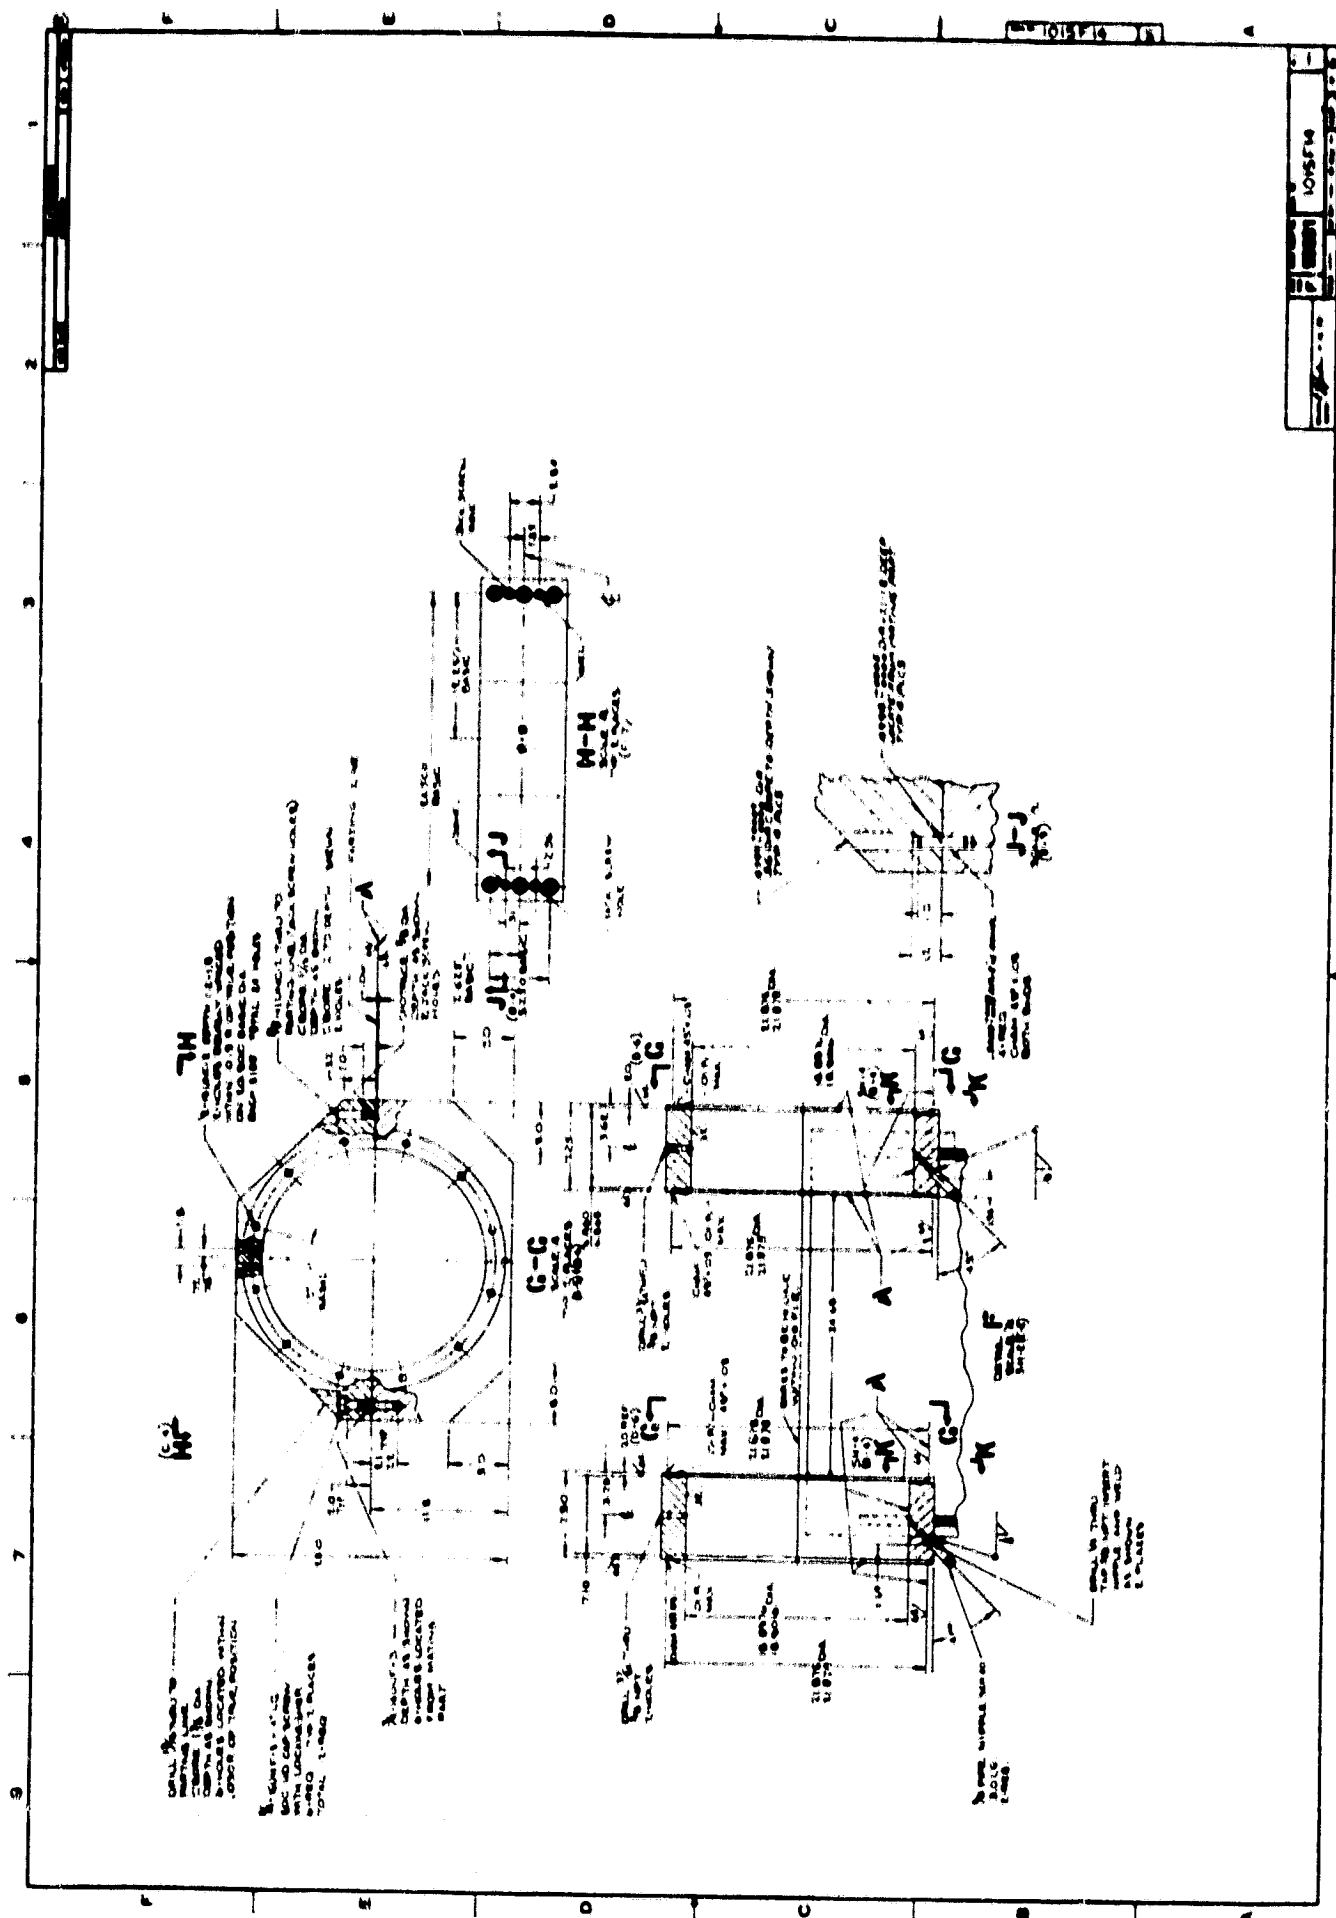


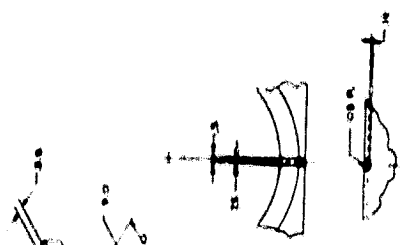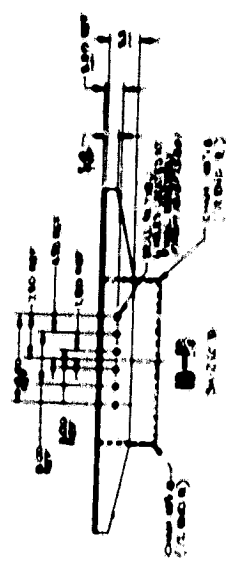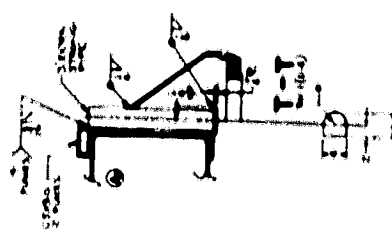


R-K
SCALE 1/4"
TYPICAL 1 PLATE

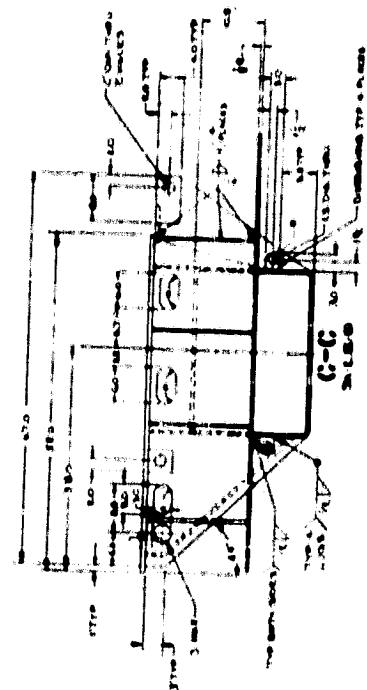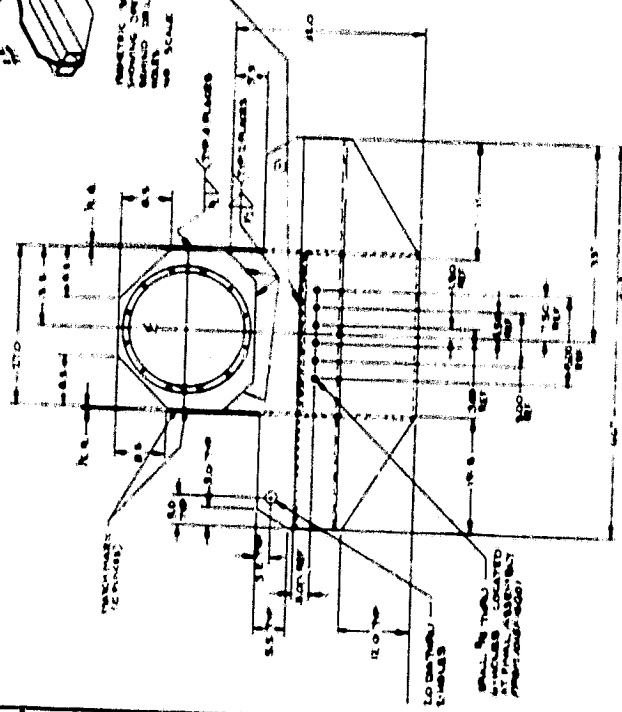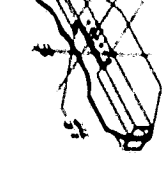

VIEW 1
SECTION

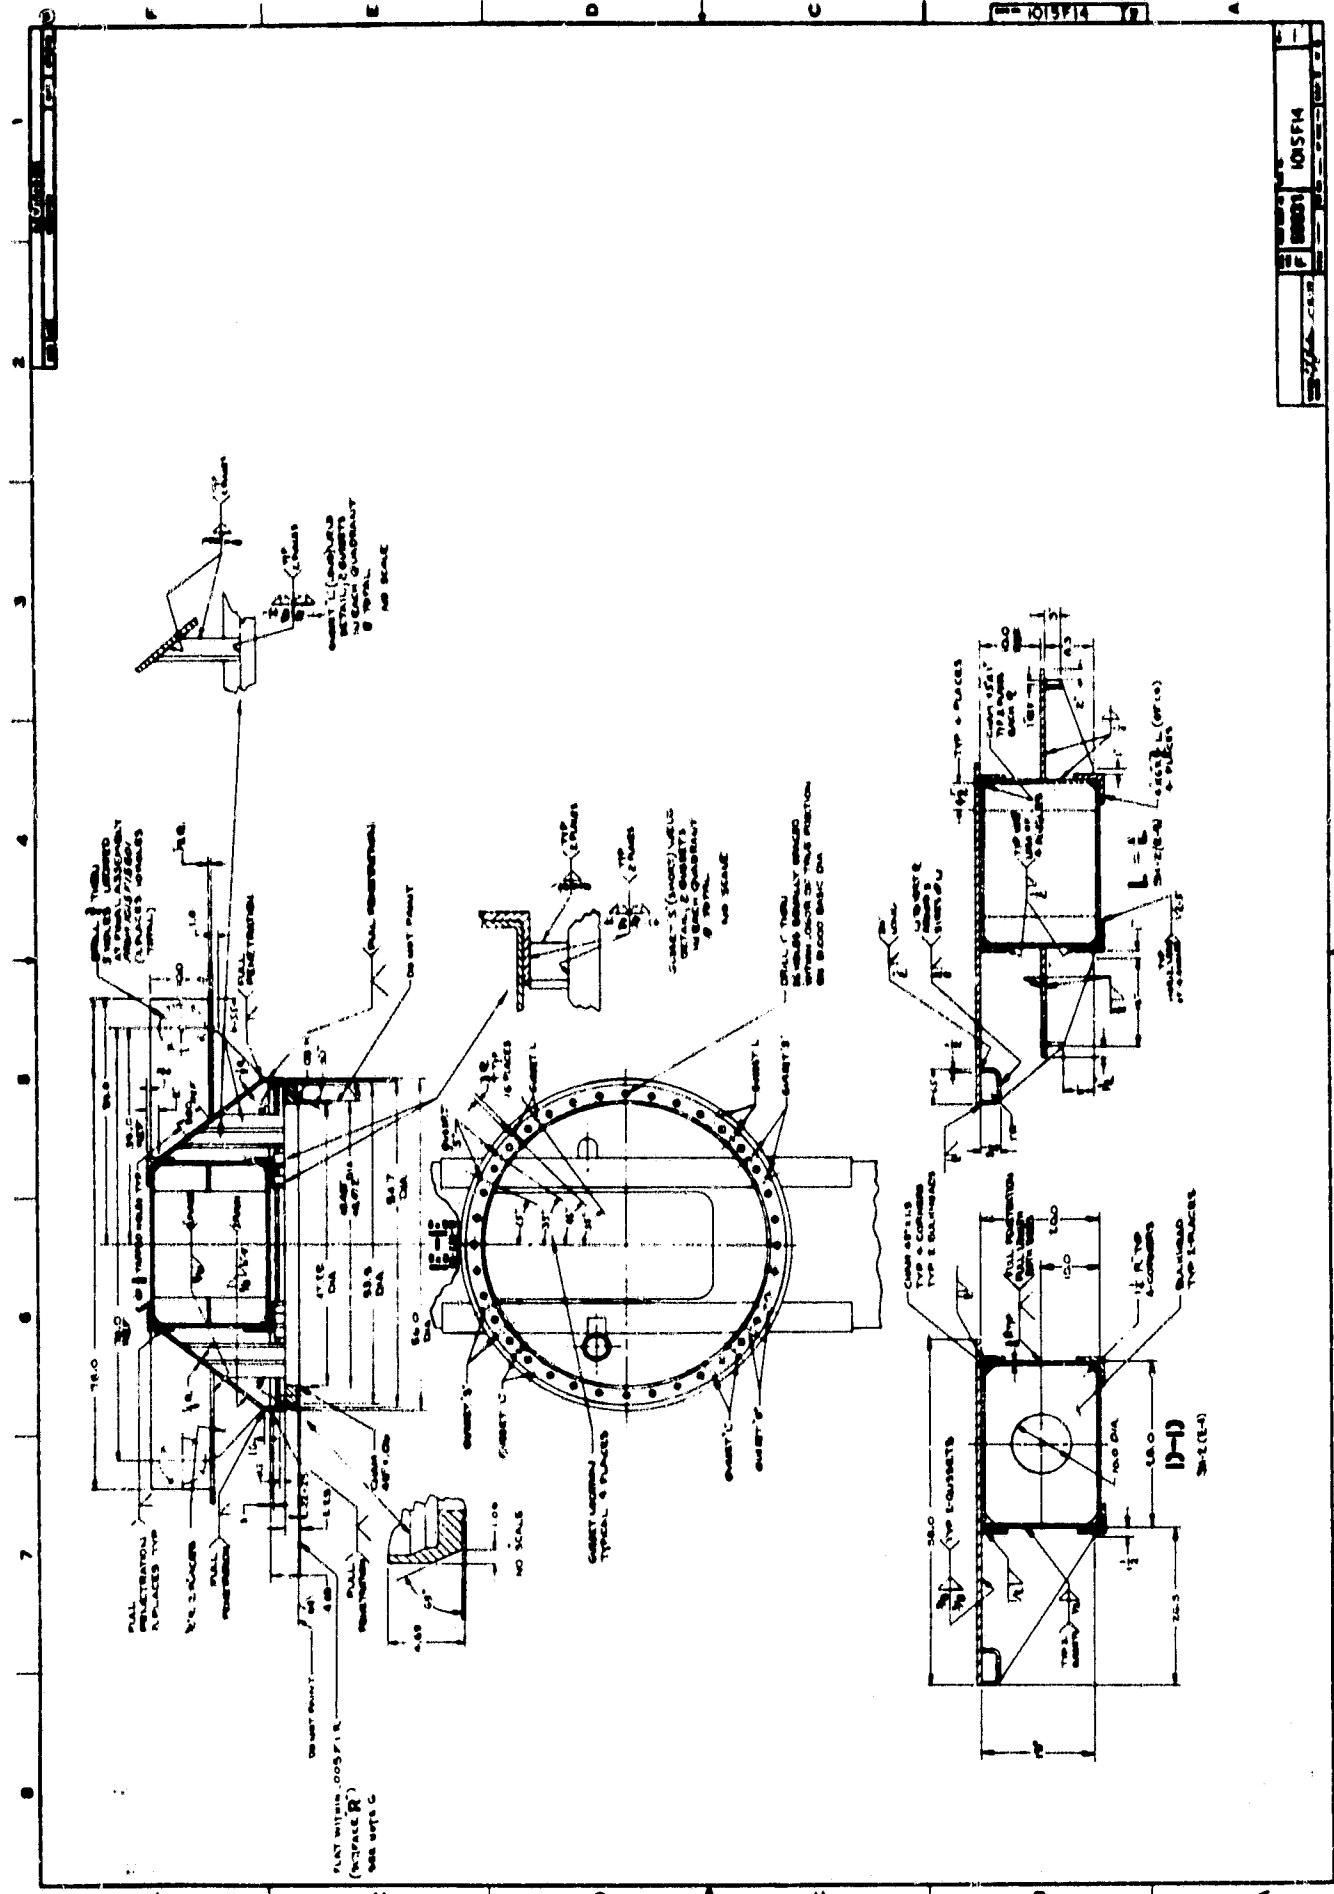

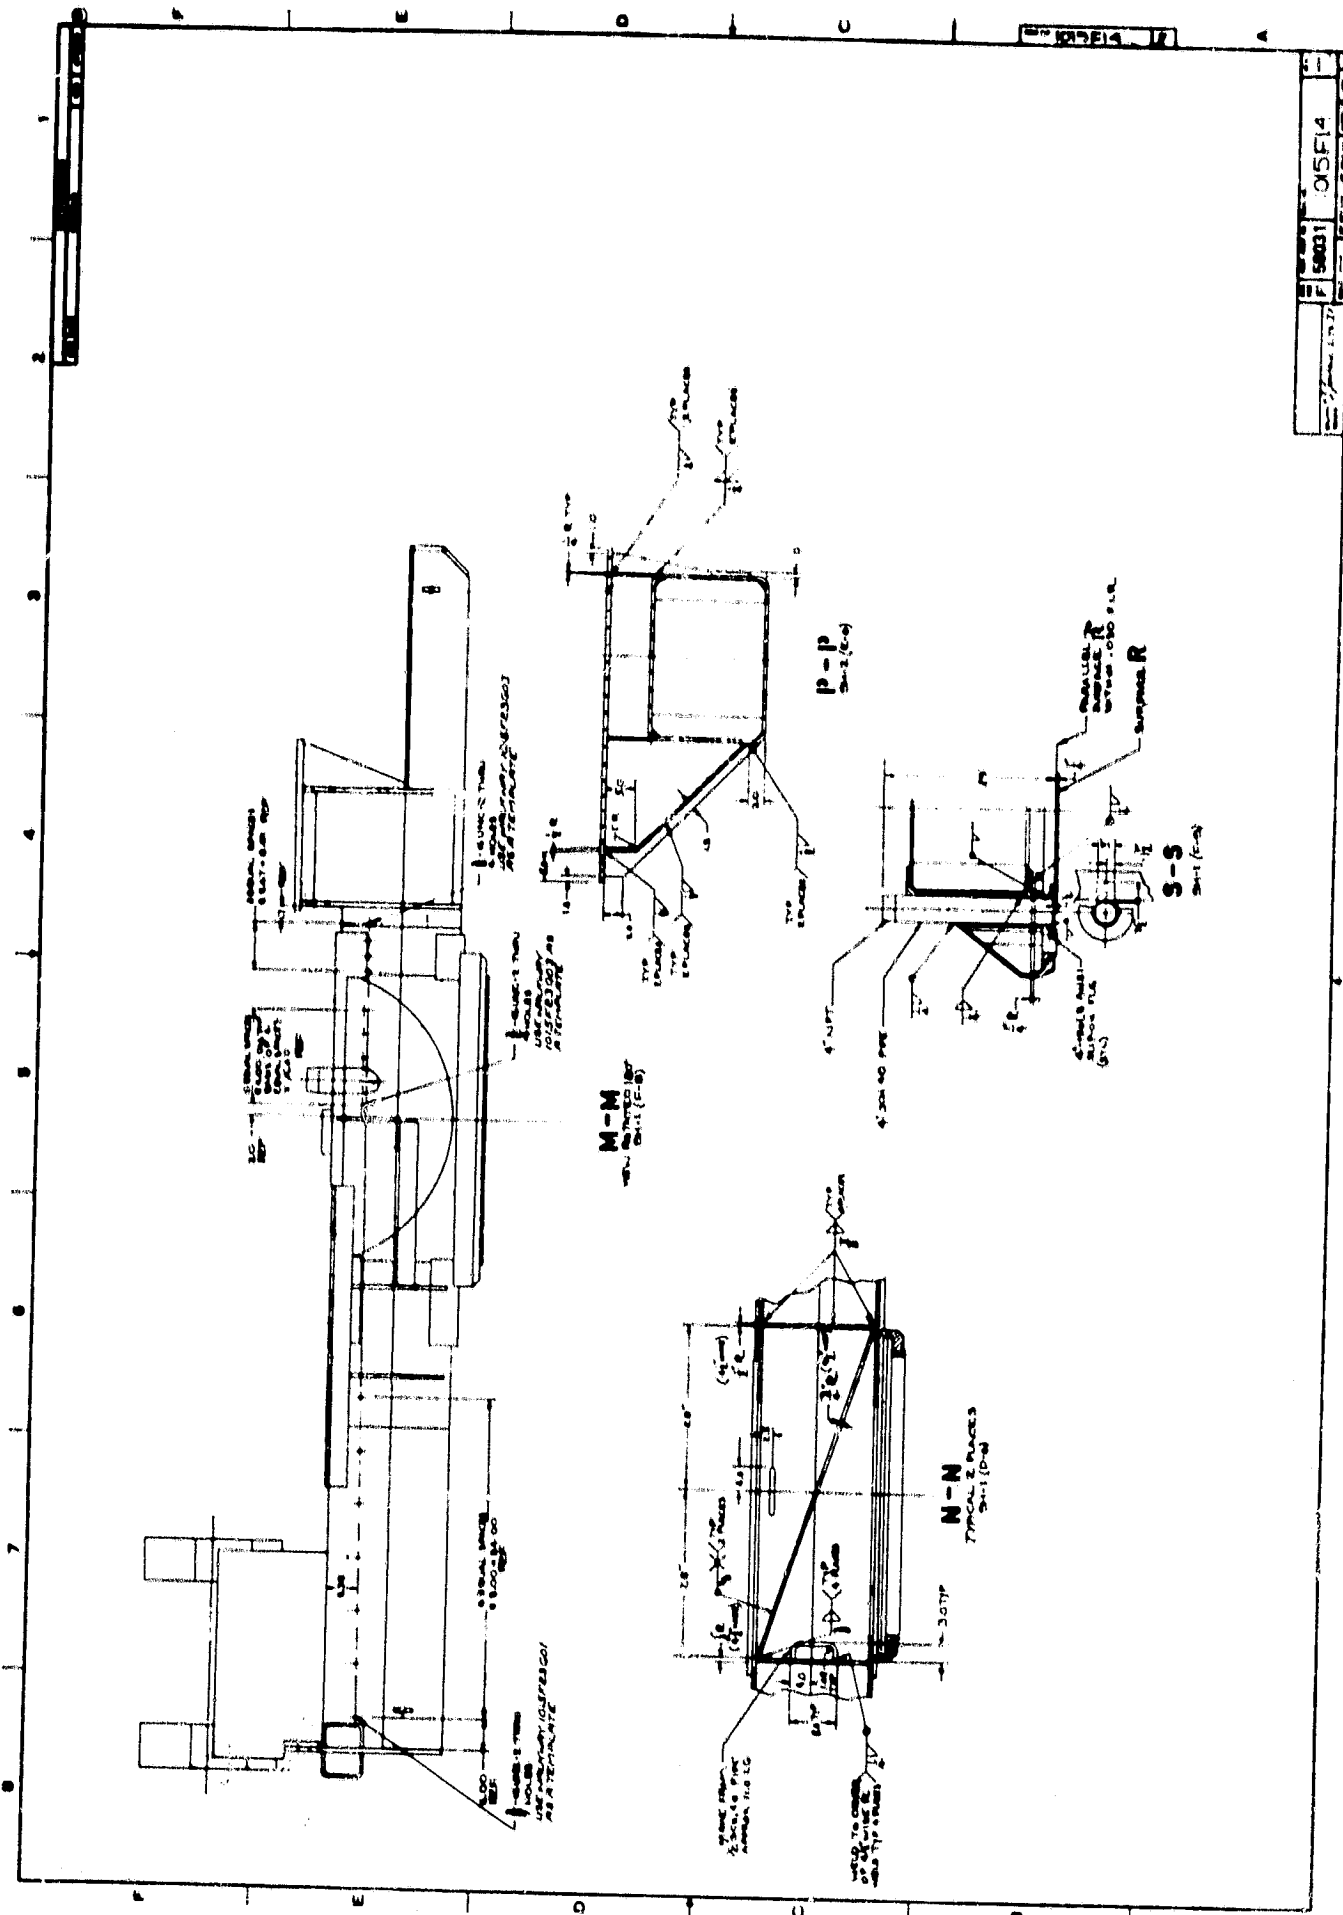

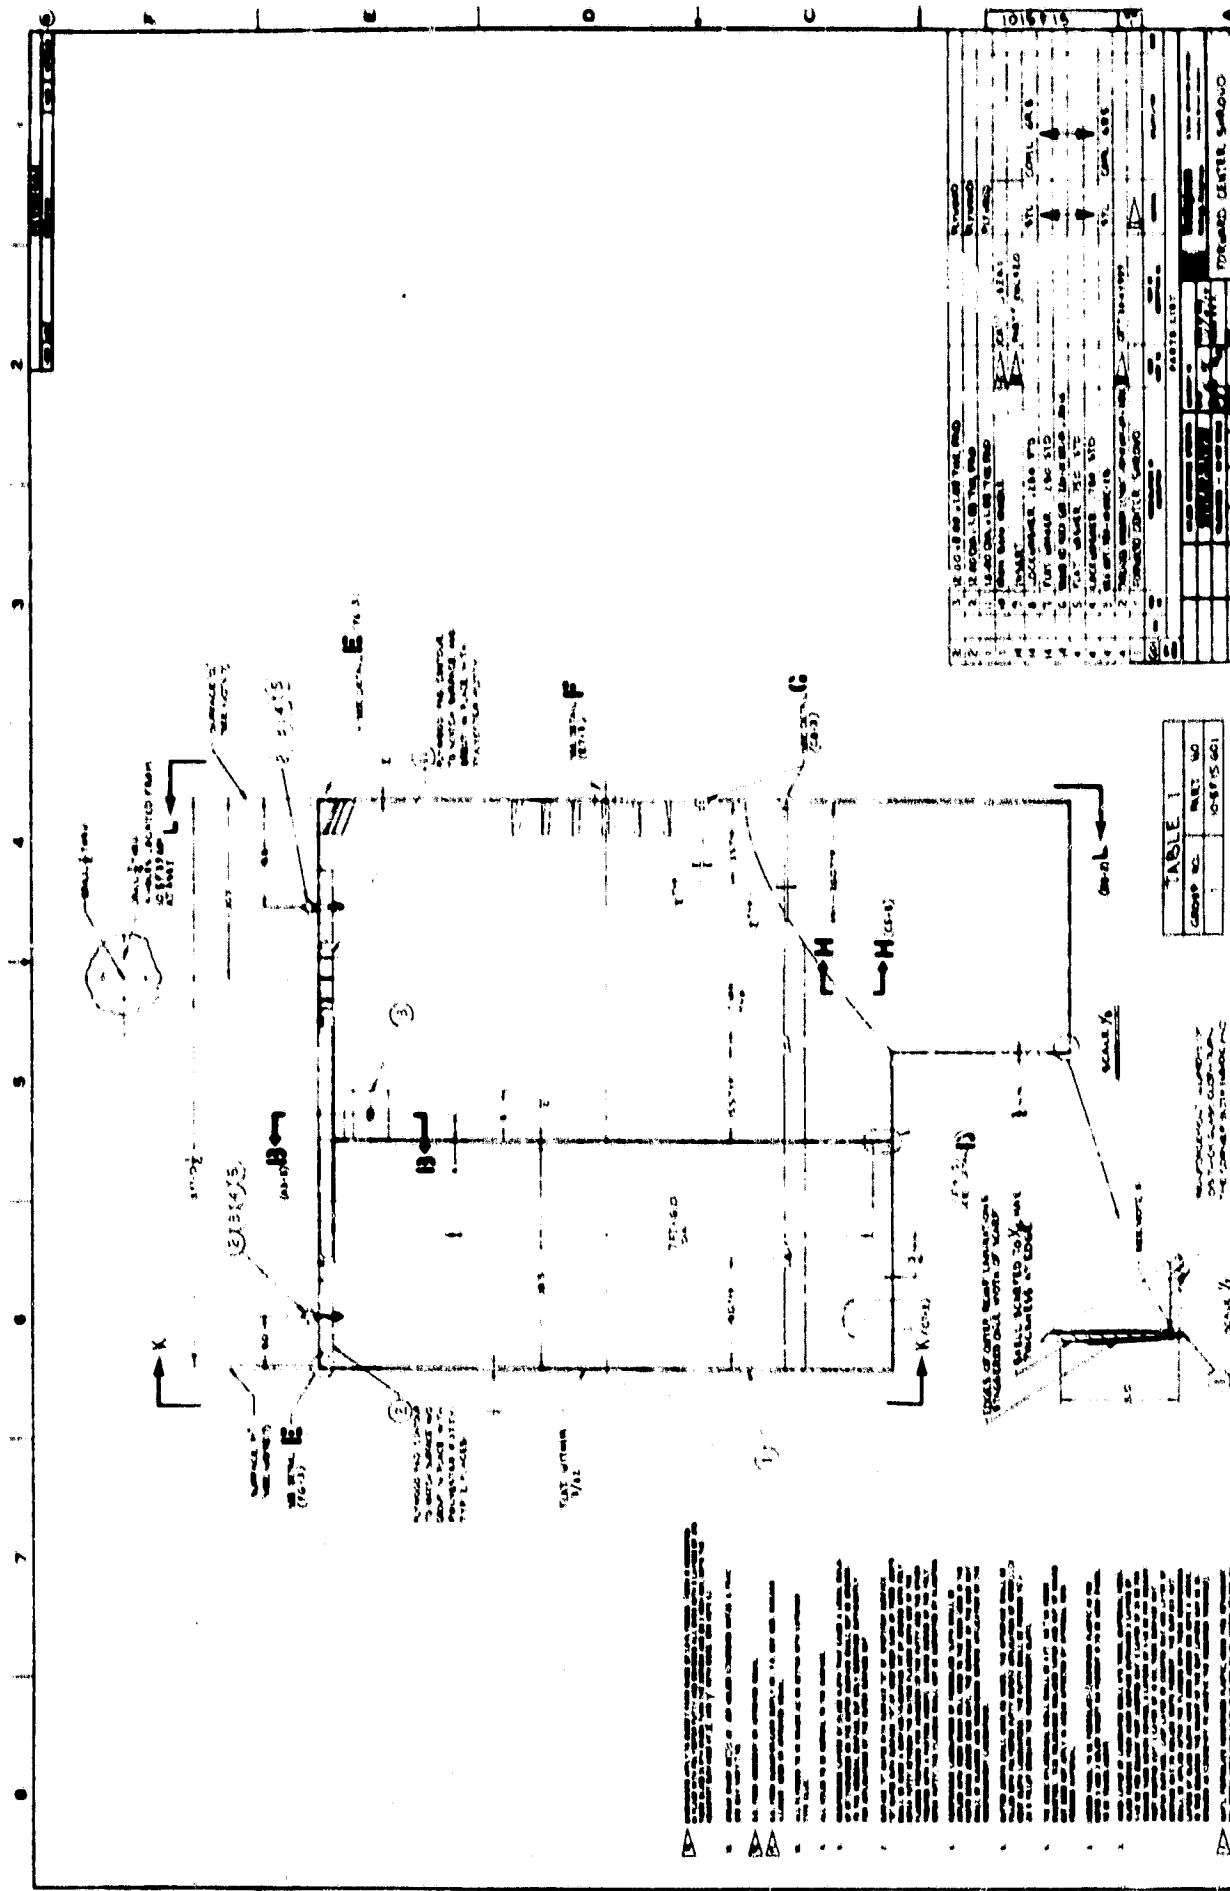



TABLE 1




1015F15

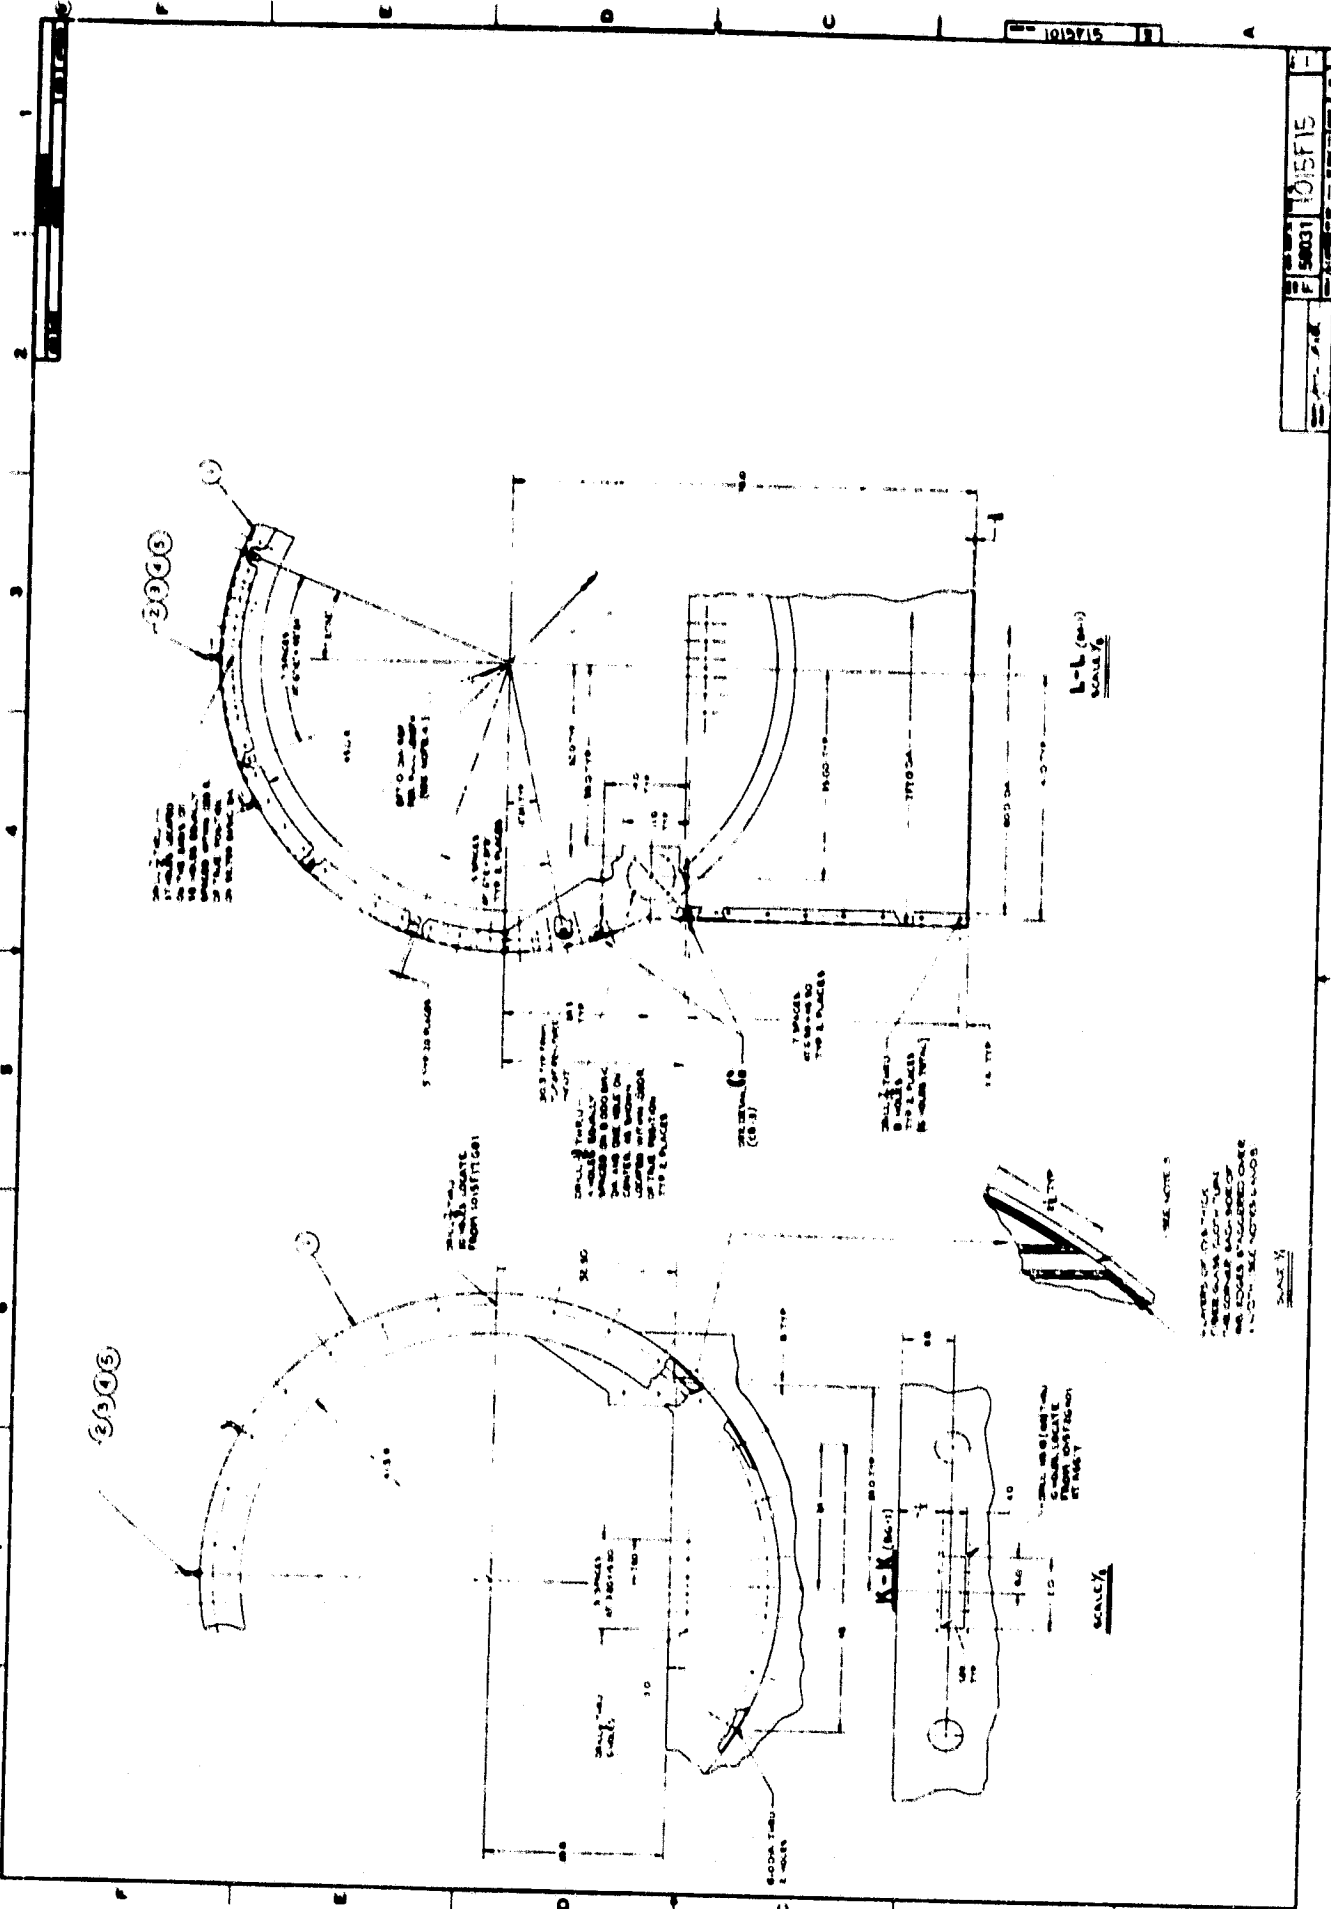

SEE NOTE 5

1-1 (sec.)
 SCALE 1/4"

SCALE 1/4"

K-K (sec.)

SECTION







2945

2995

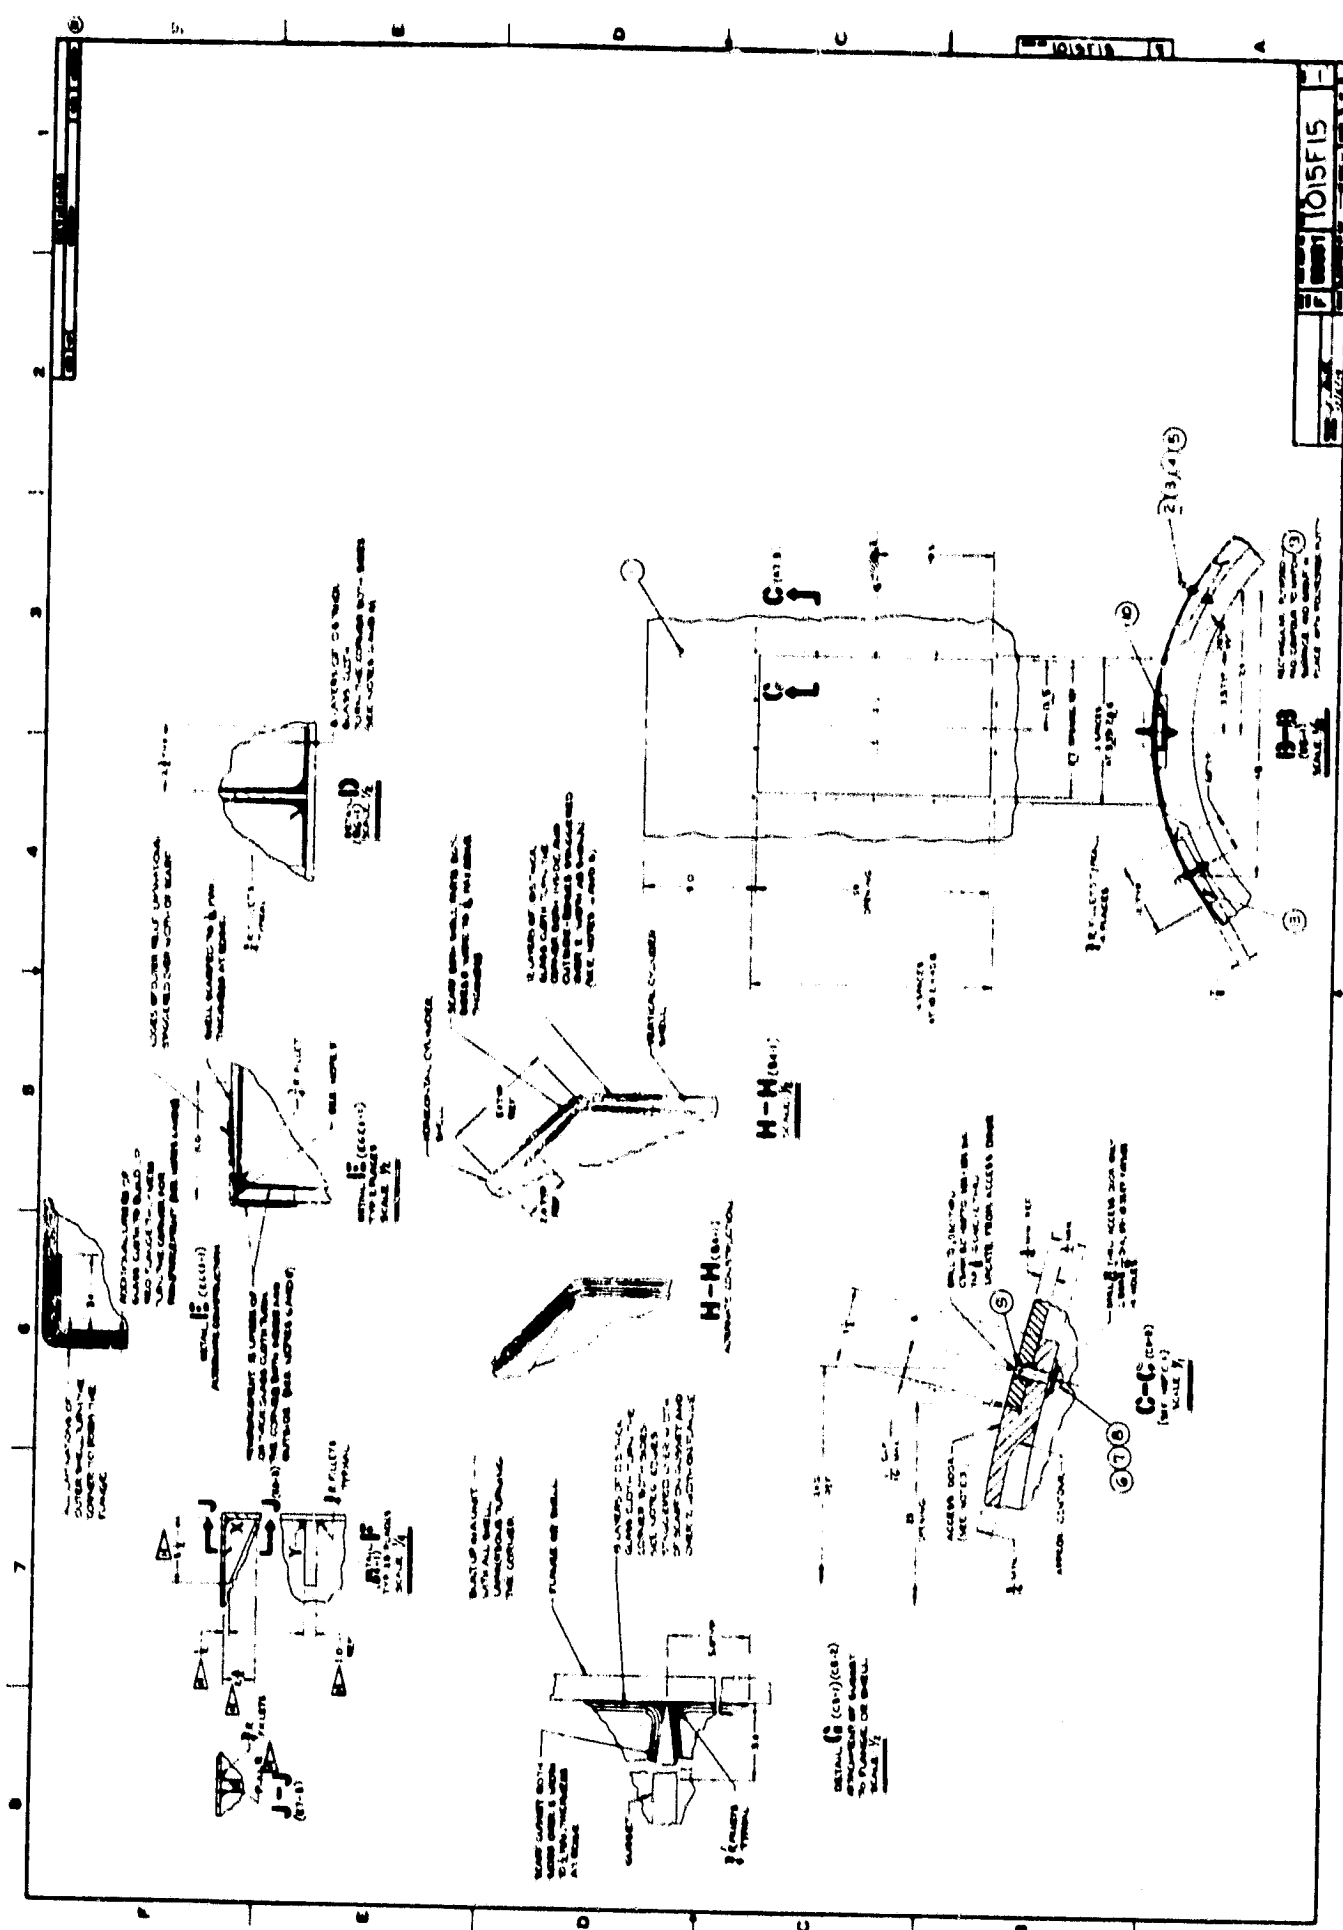

[illegible]

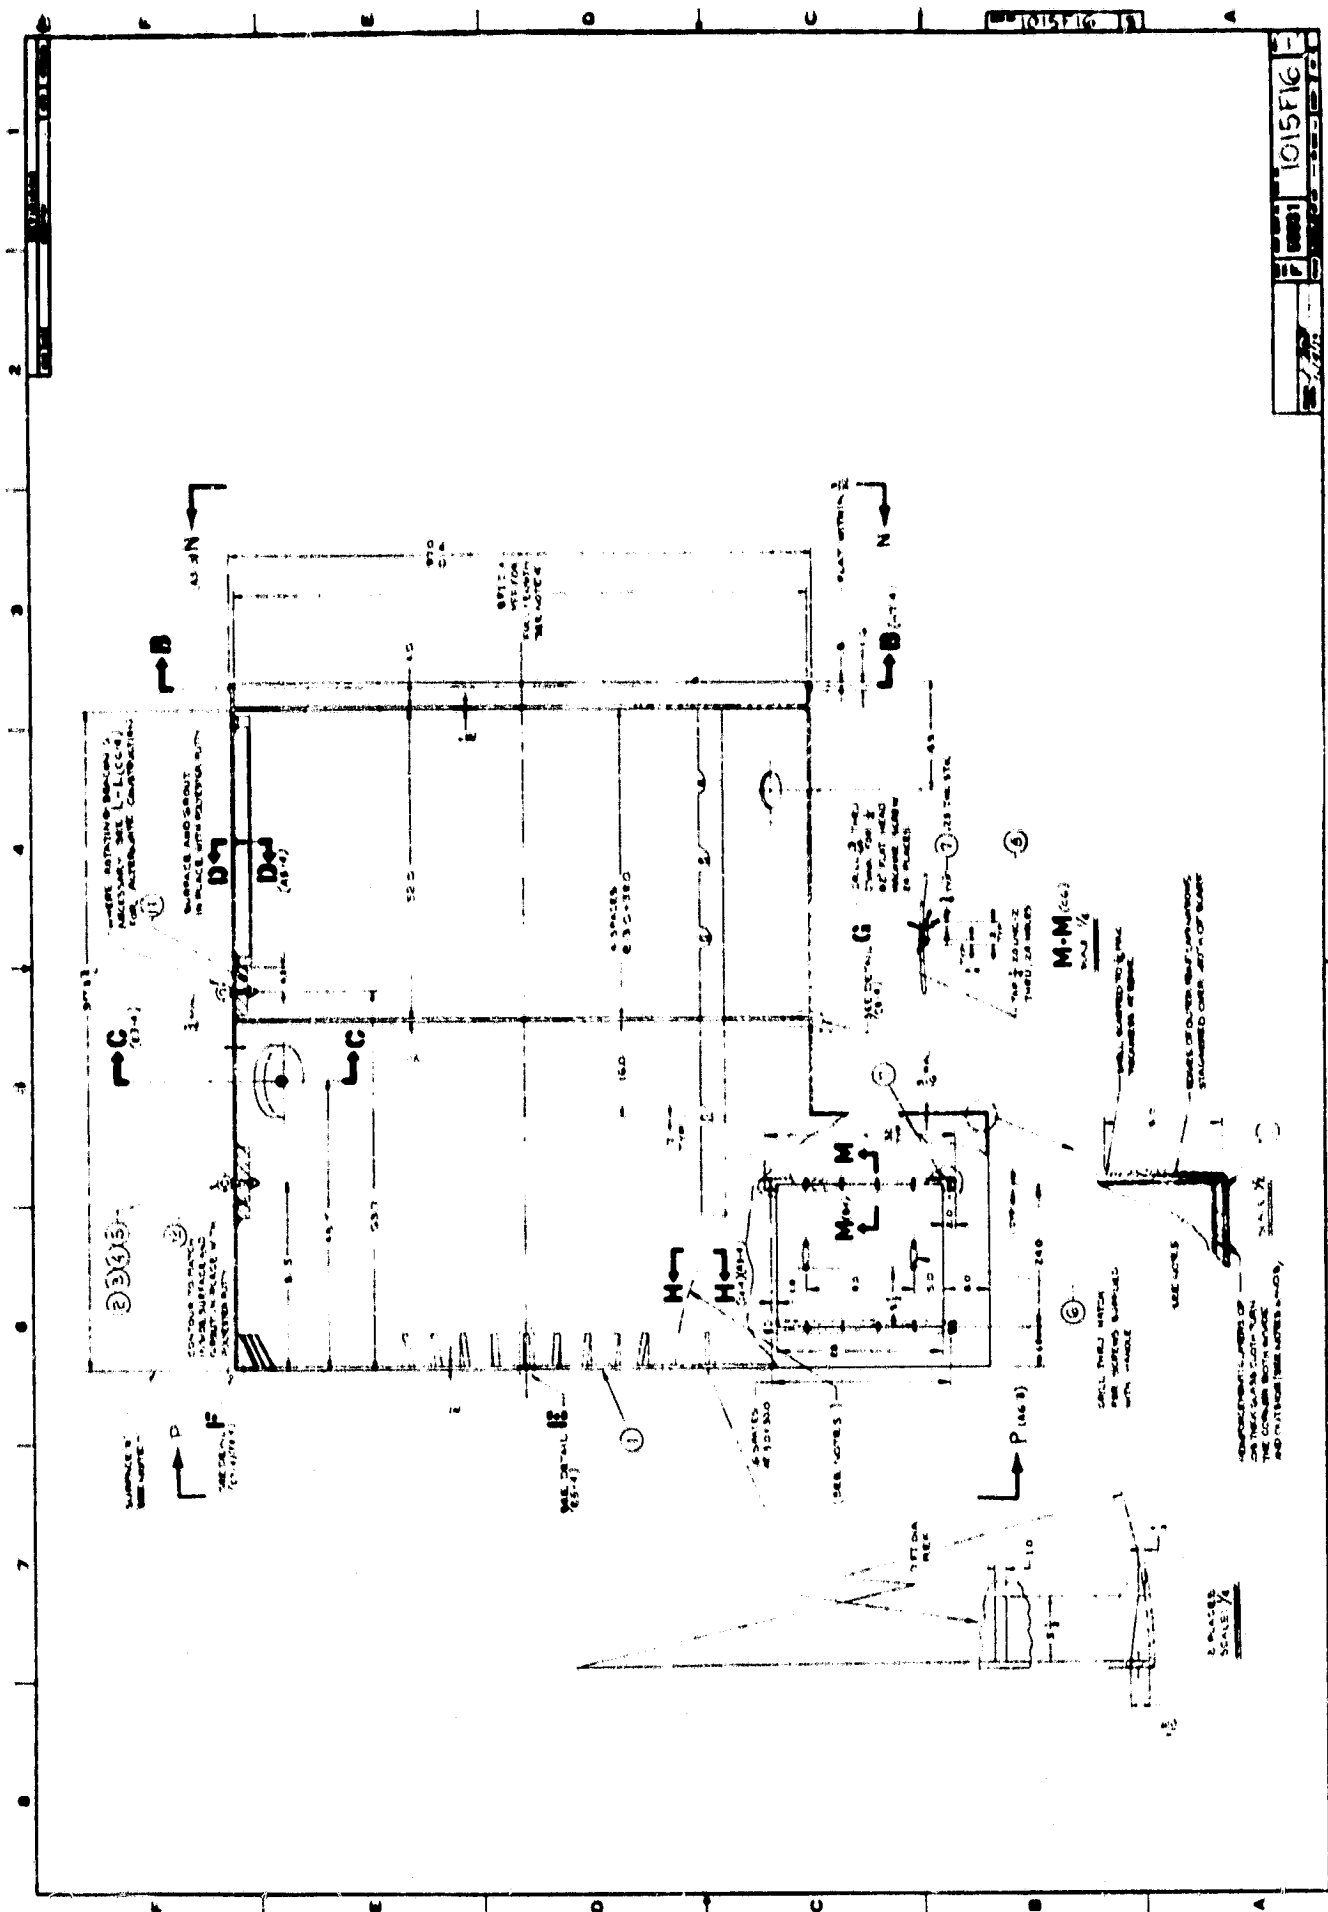

SCALE 1/4"


SEE NOTES

M-M (cc)



















H-H


D-D

B-B

M-M


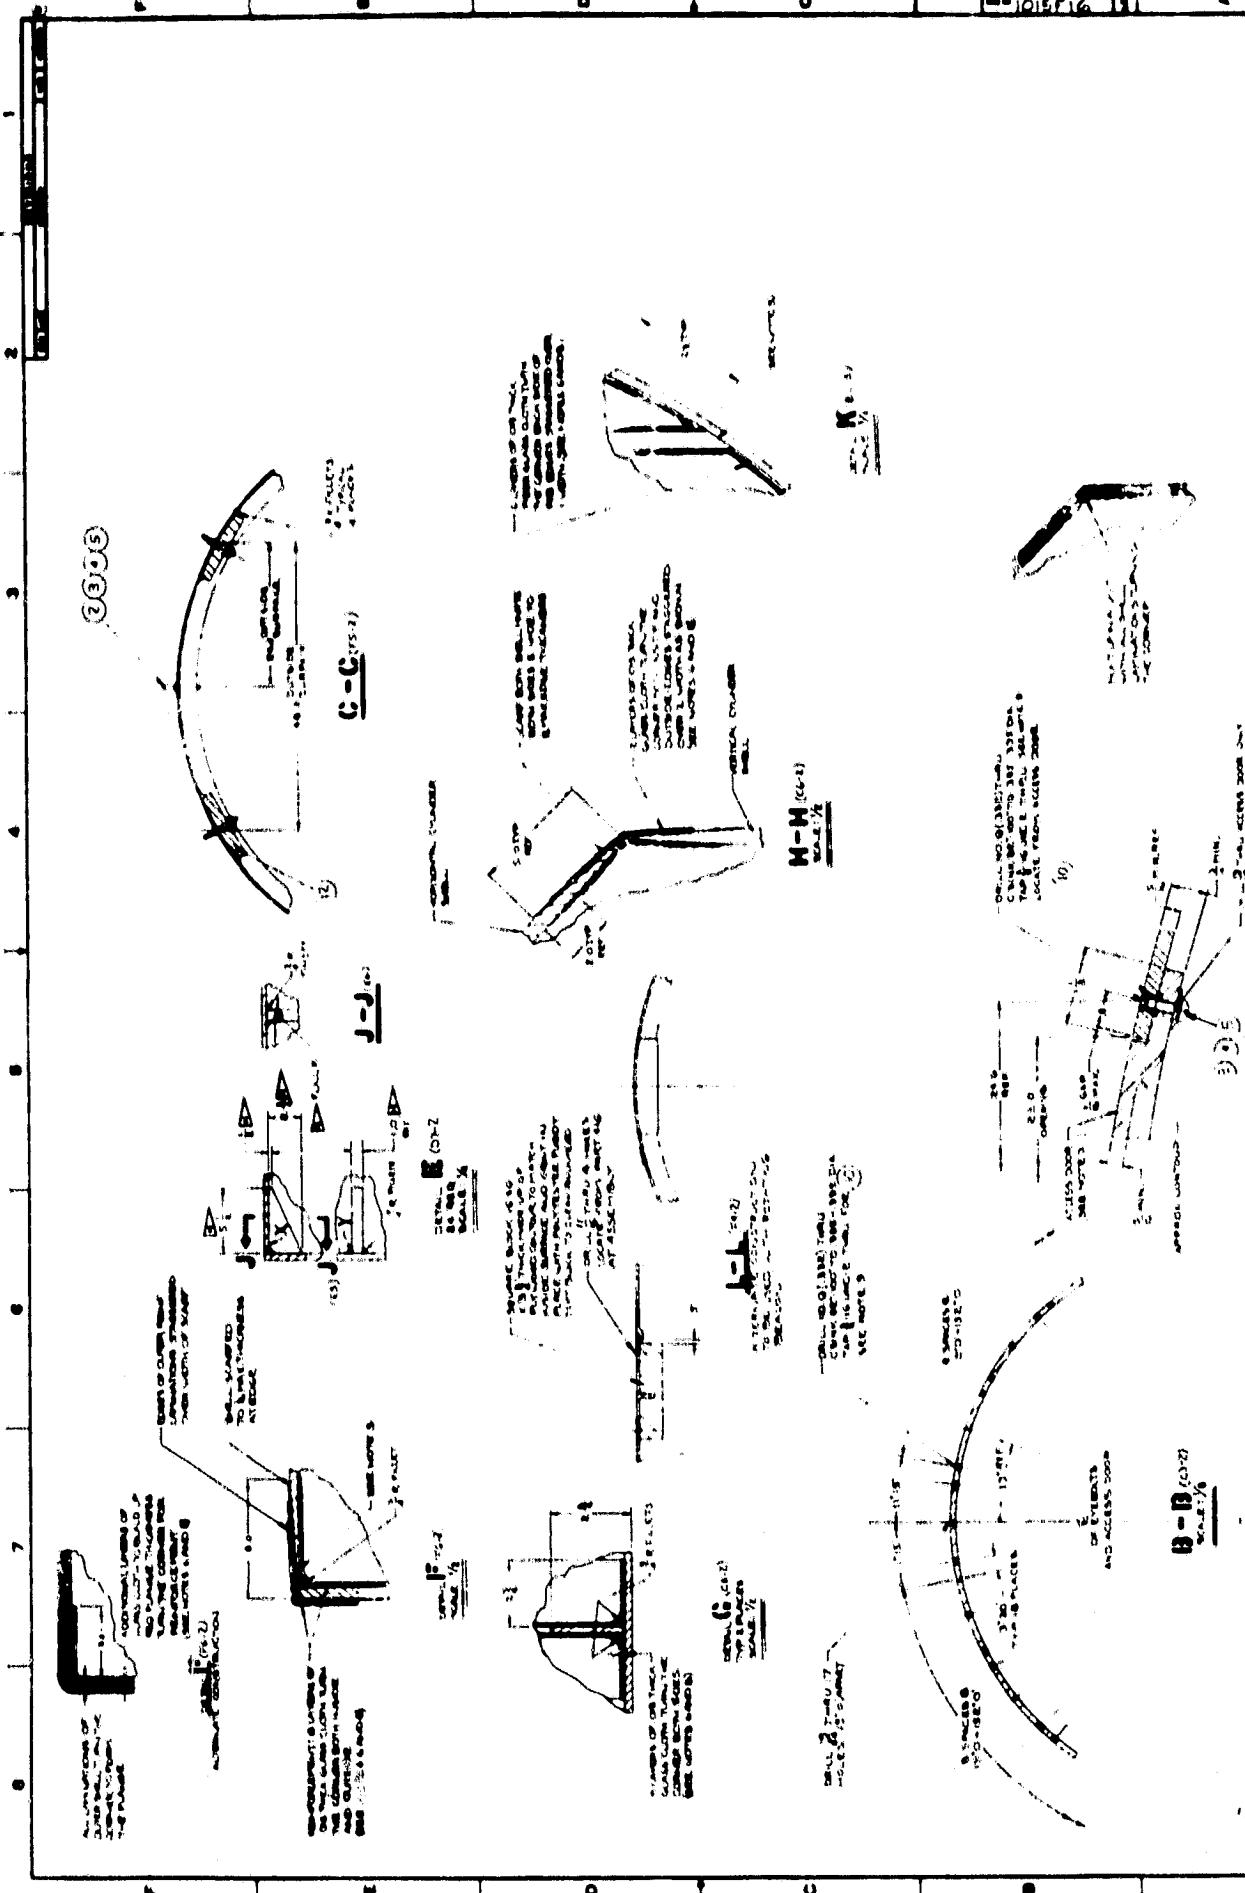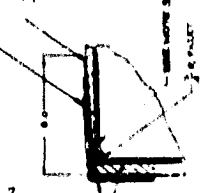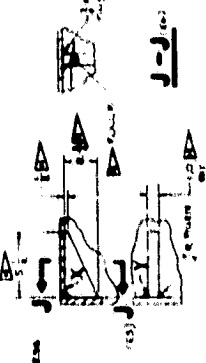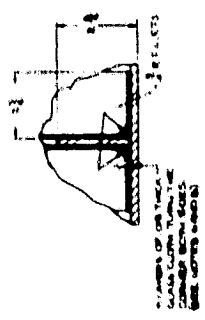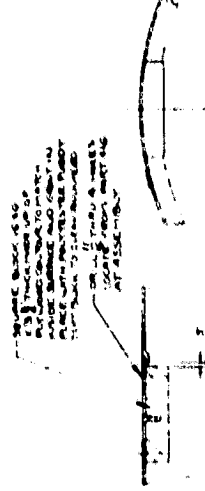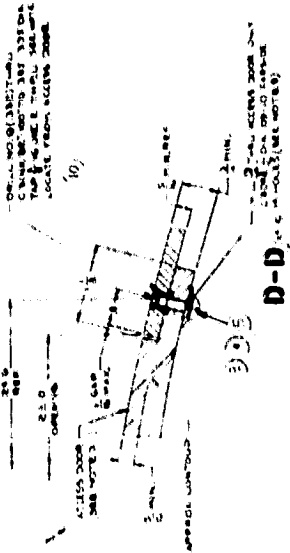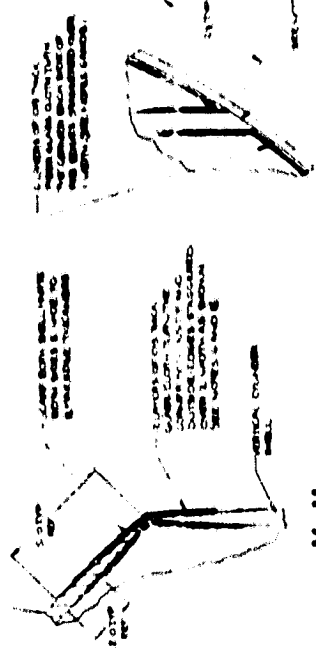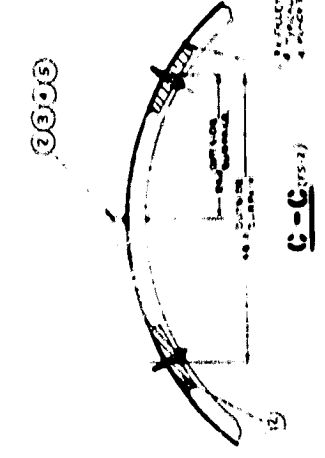

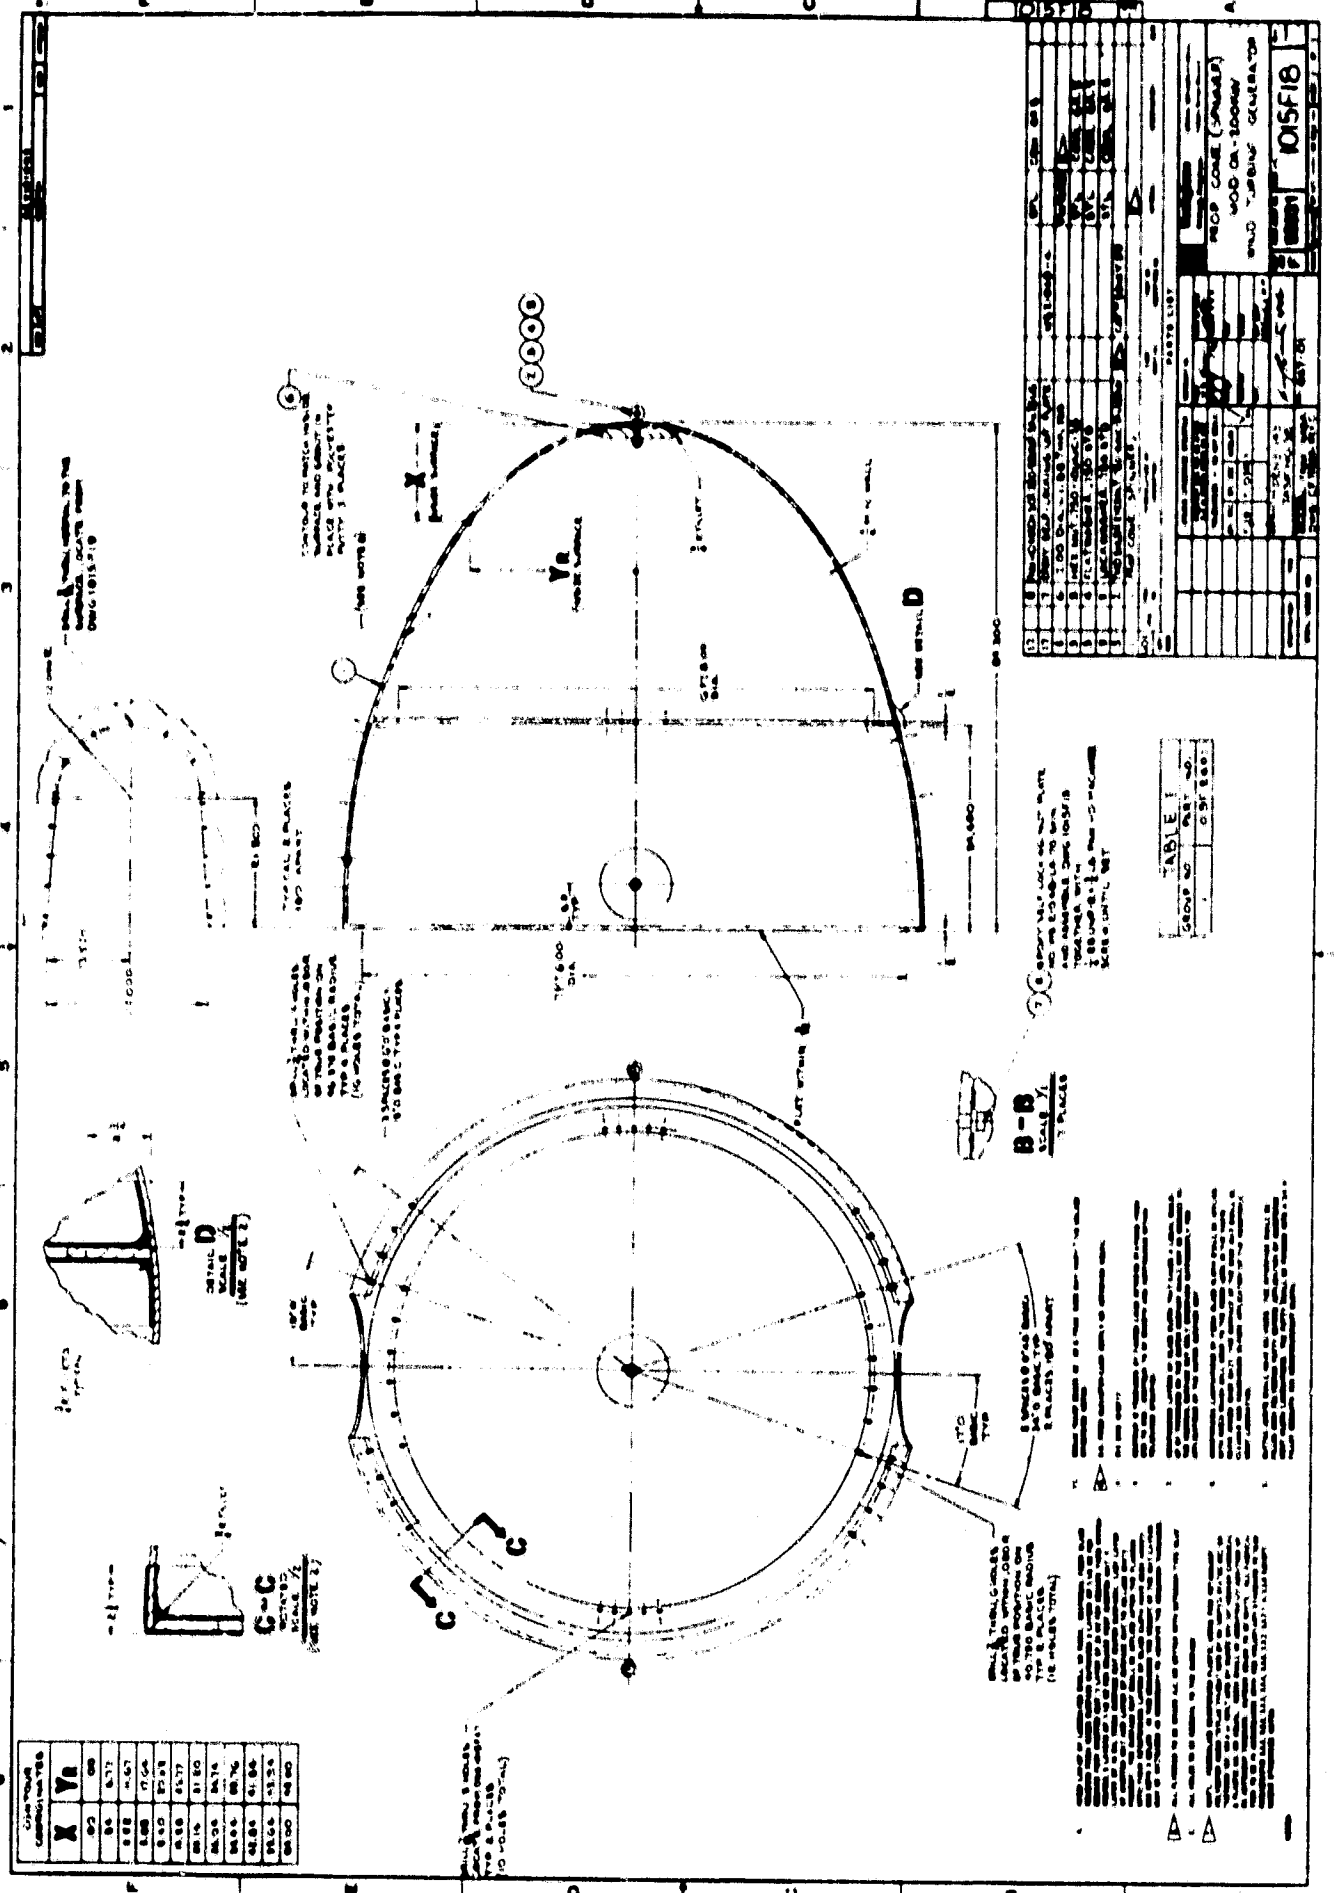








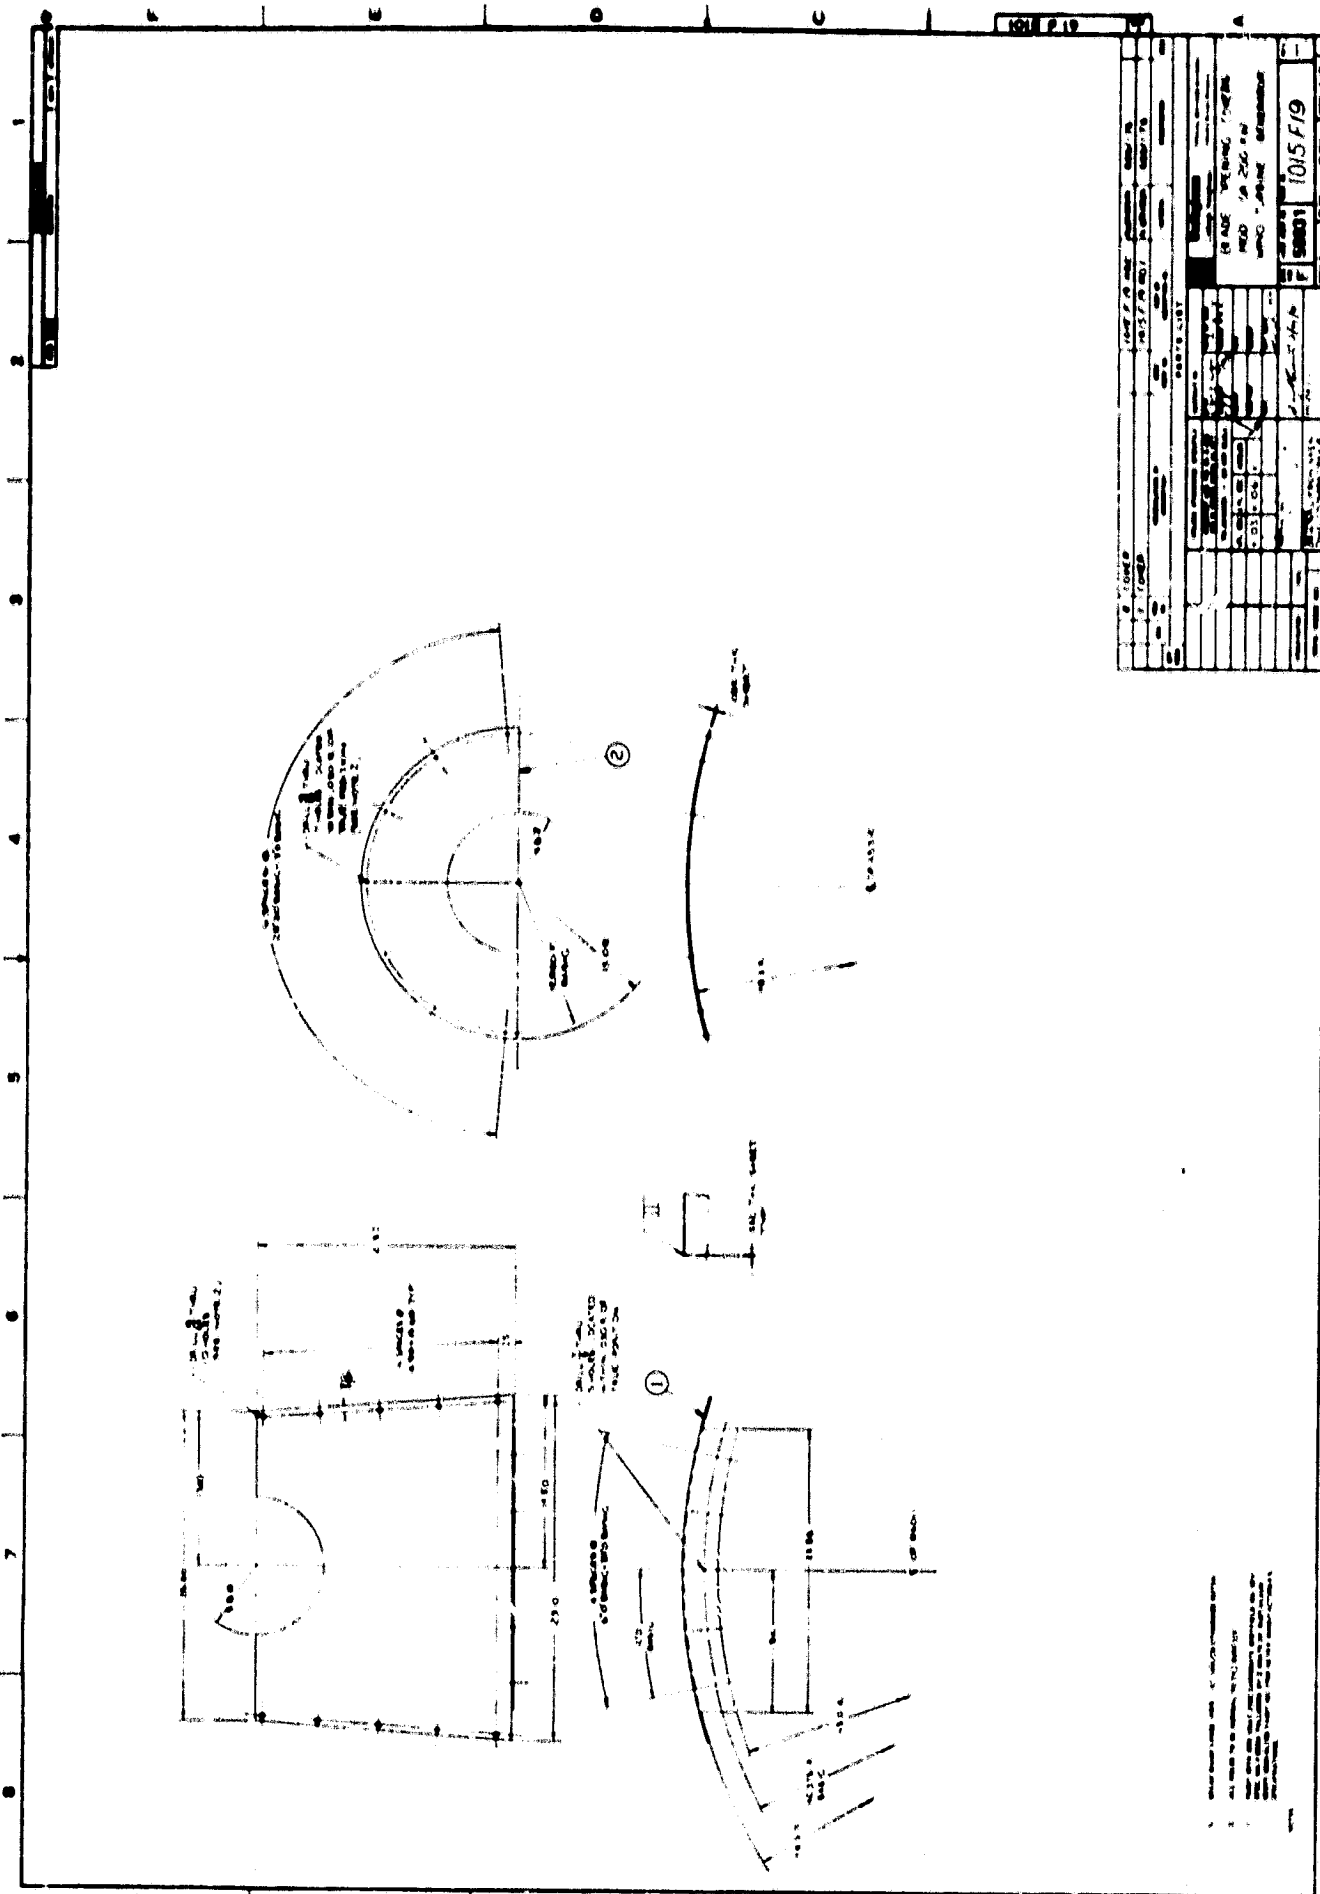

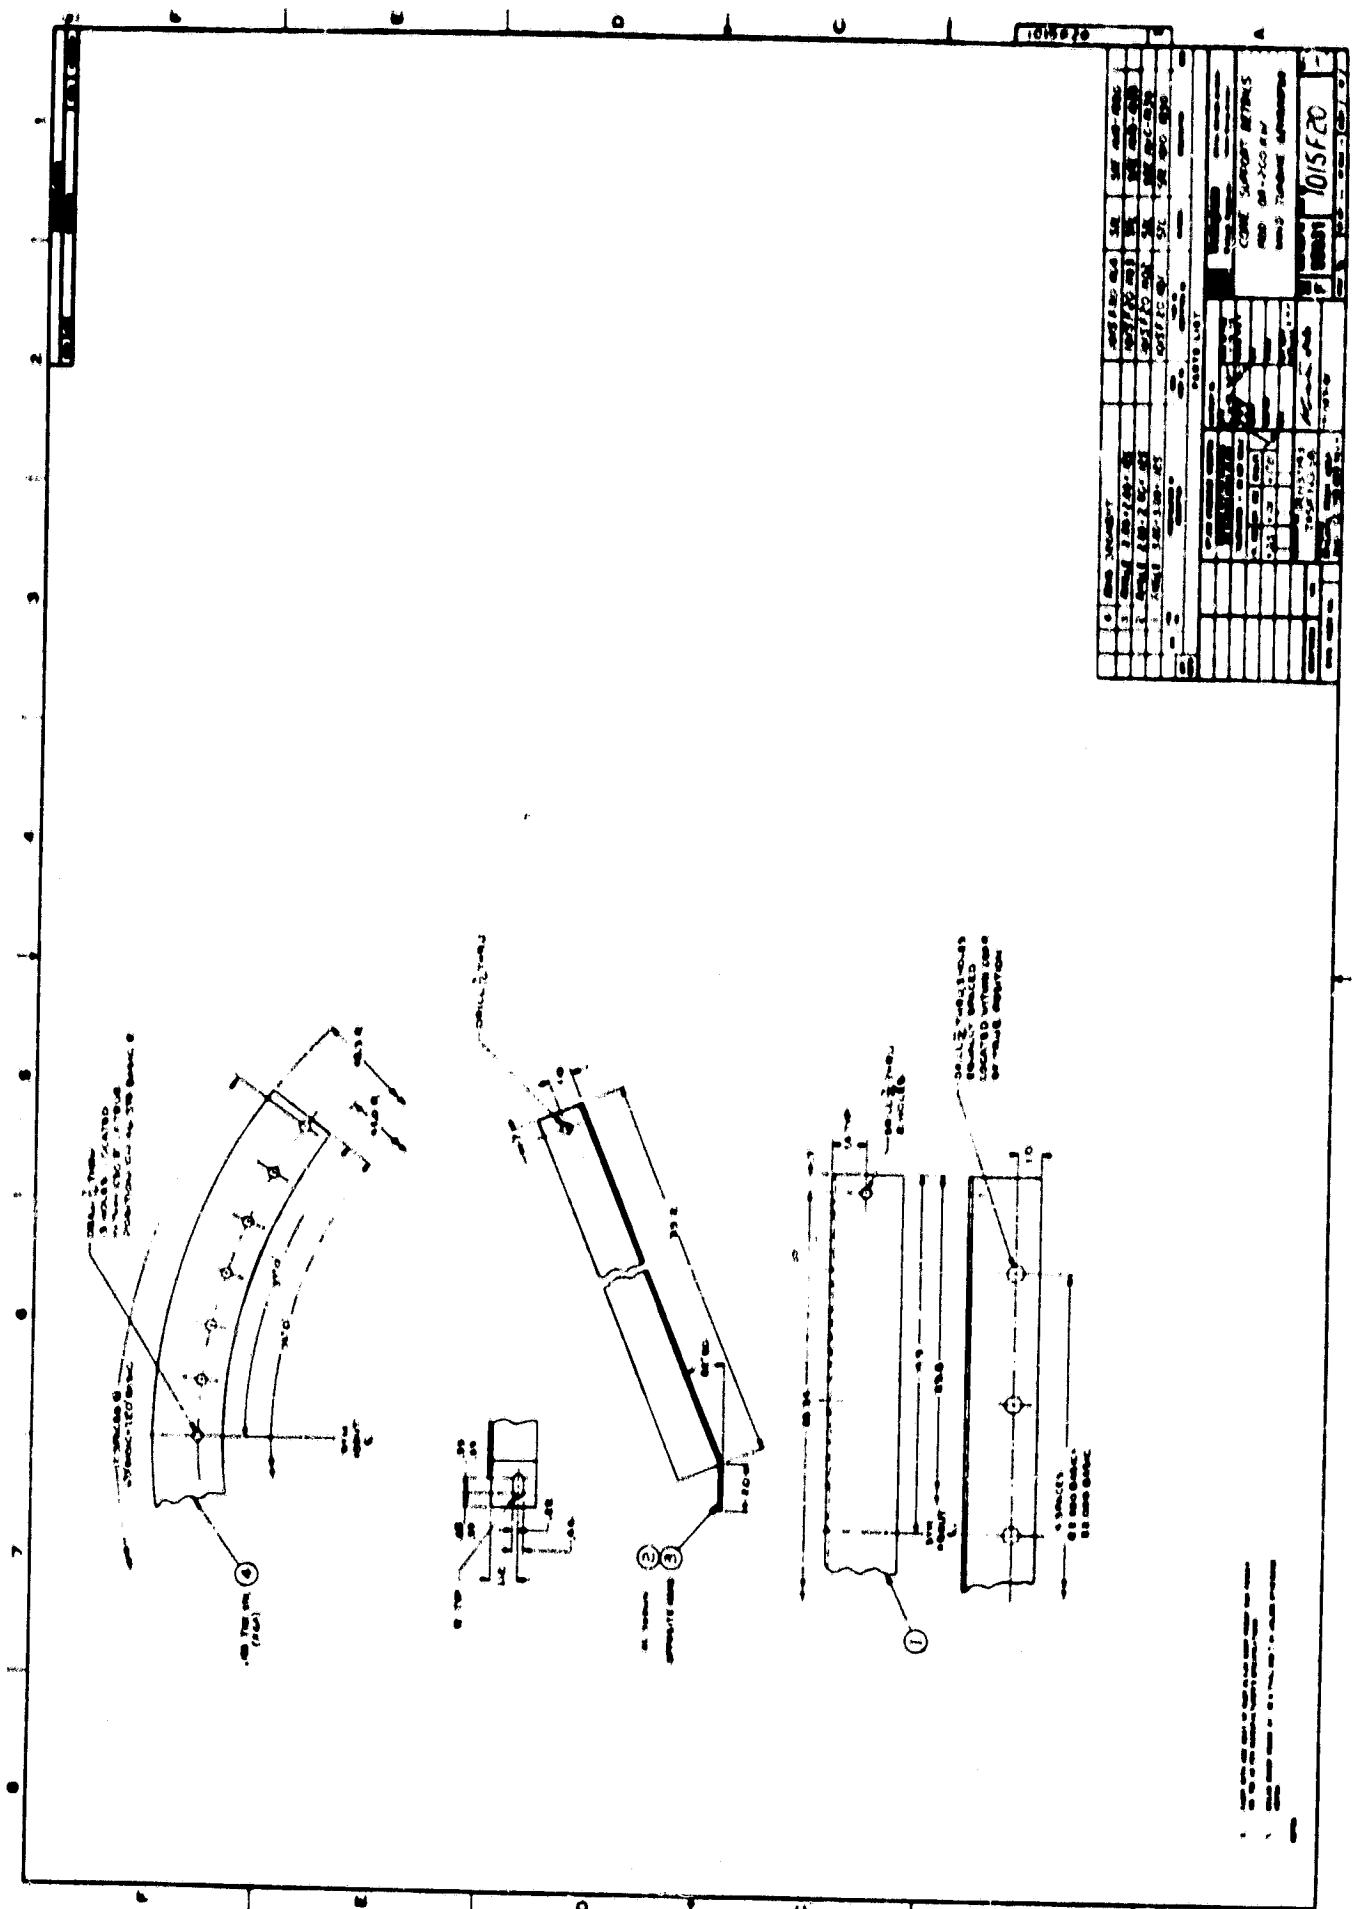







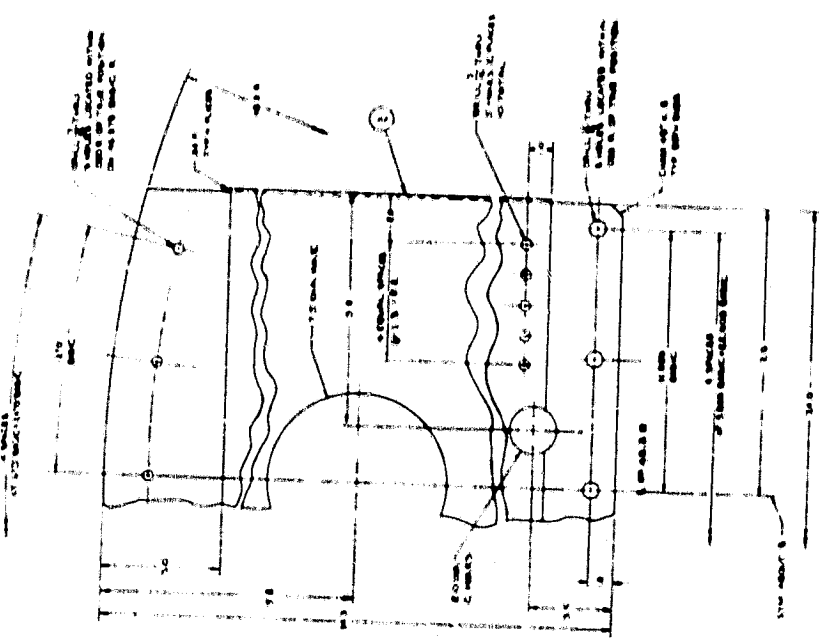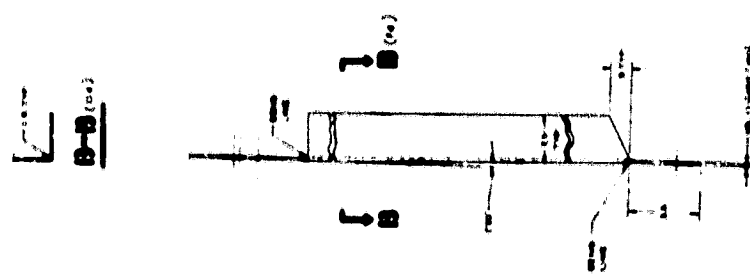



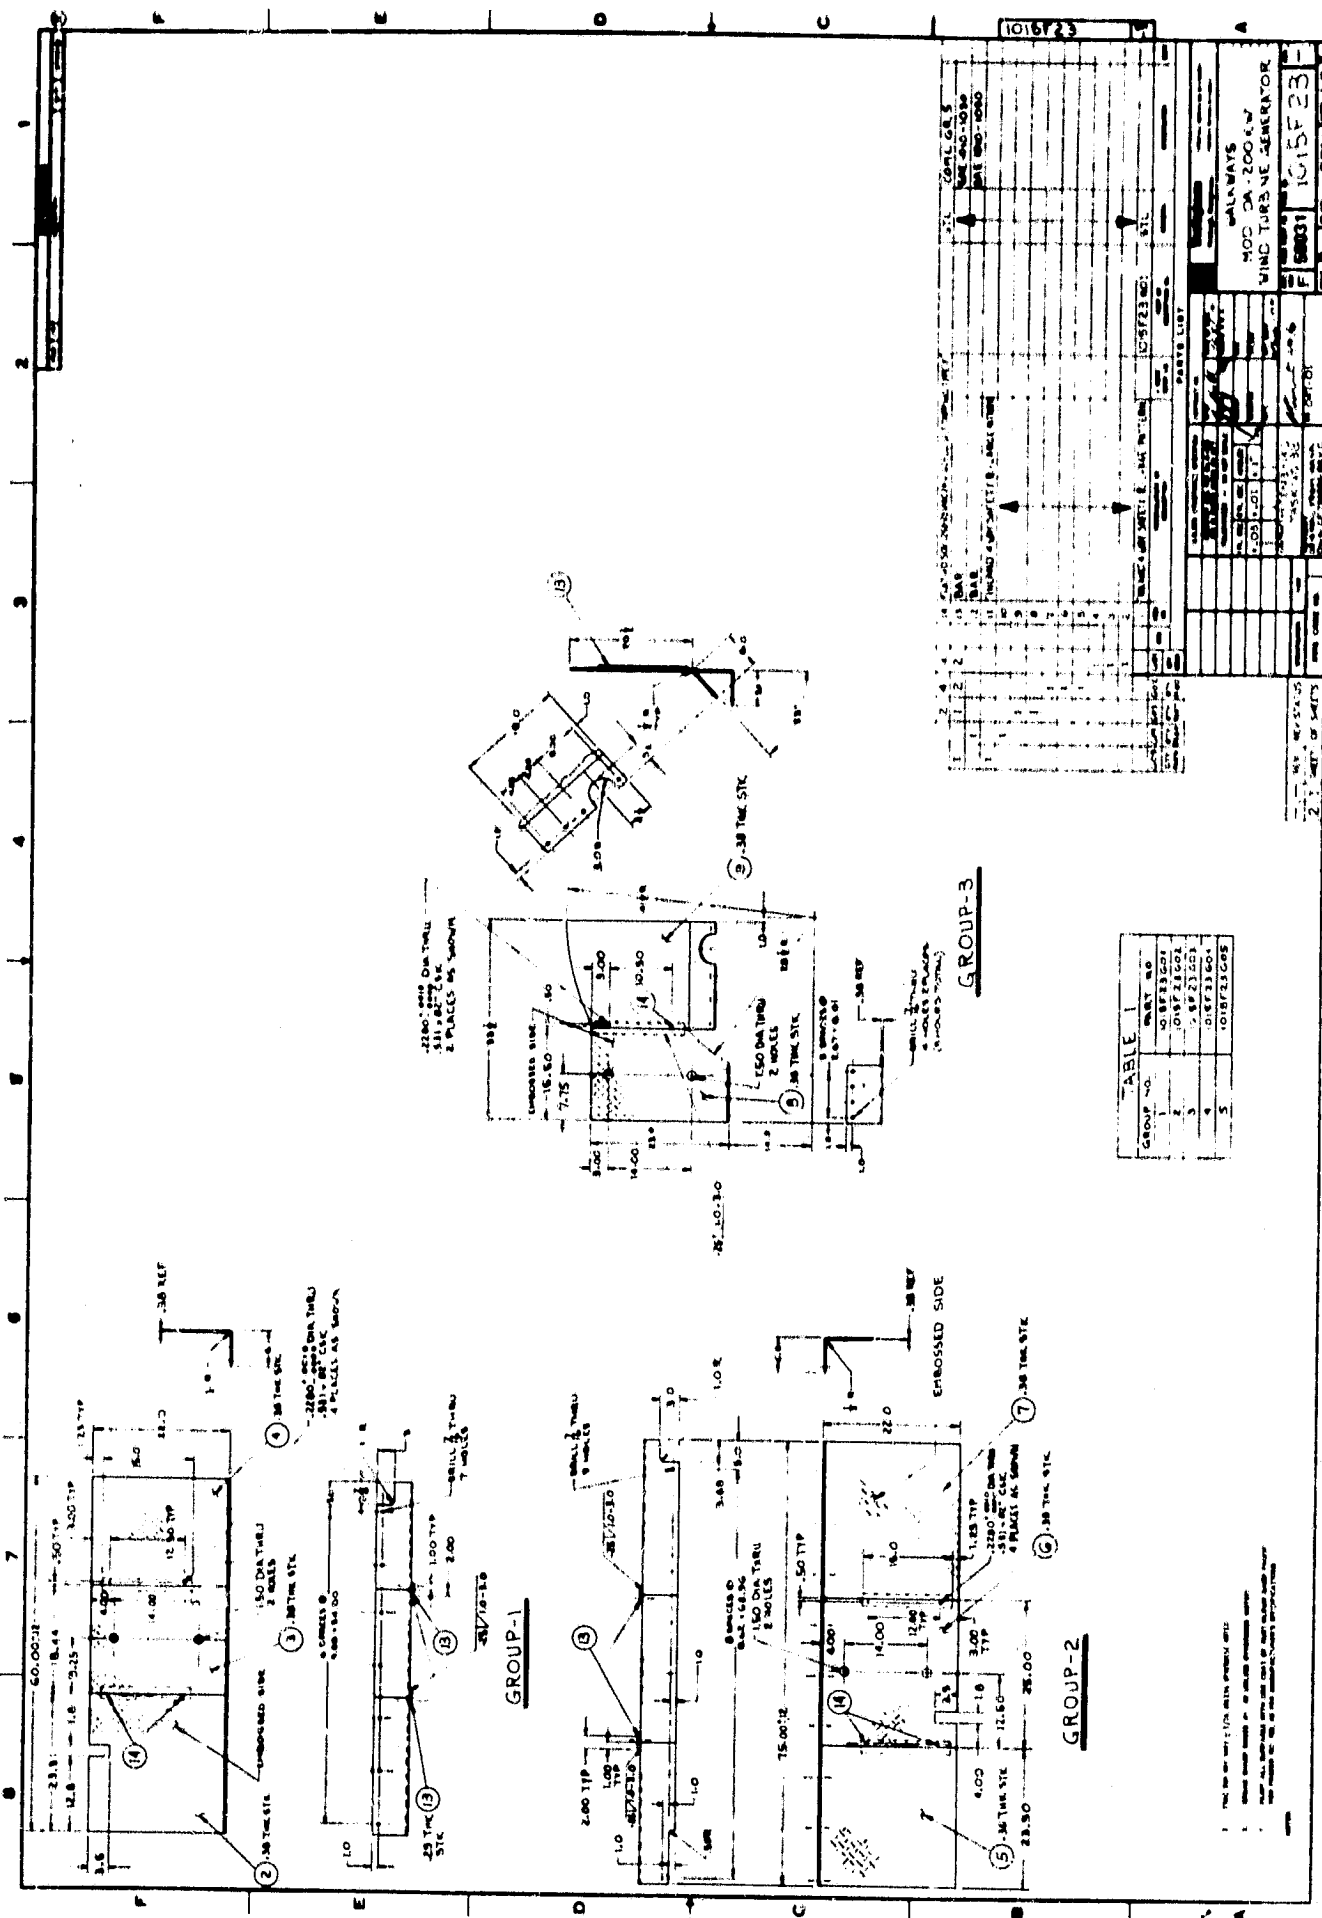

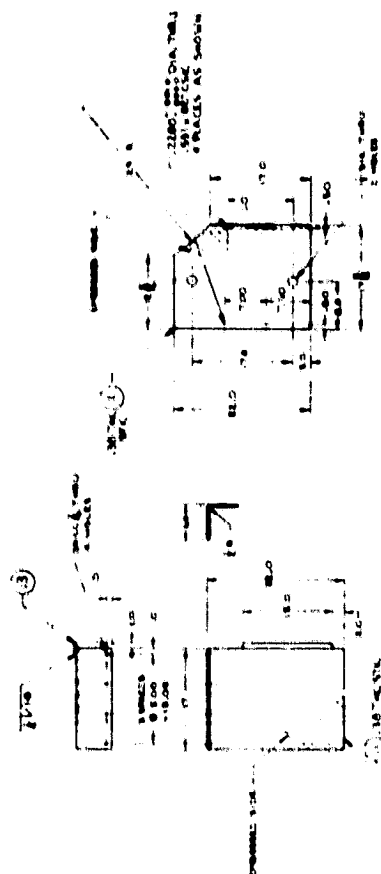

GROUP-5

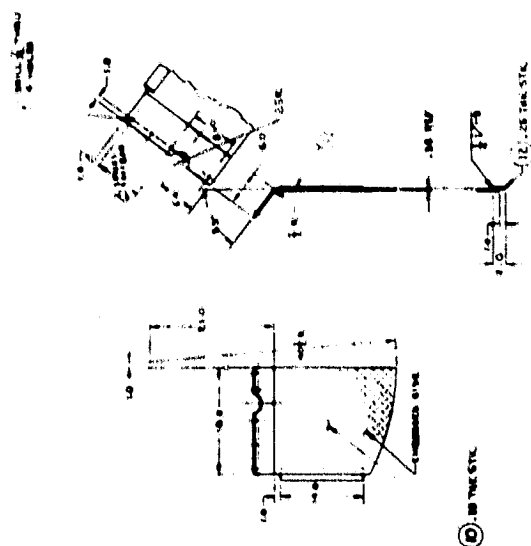

GROUP-4


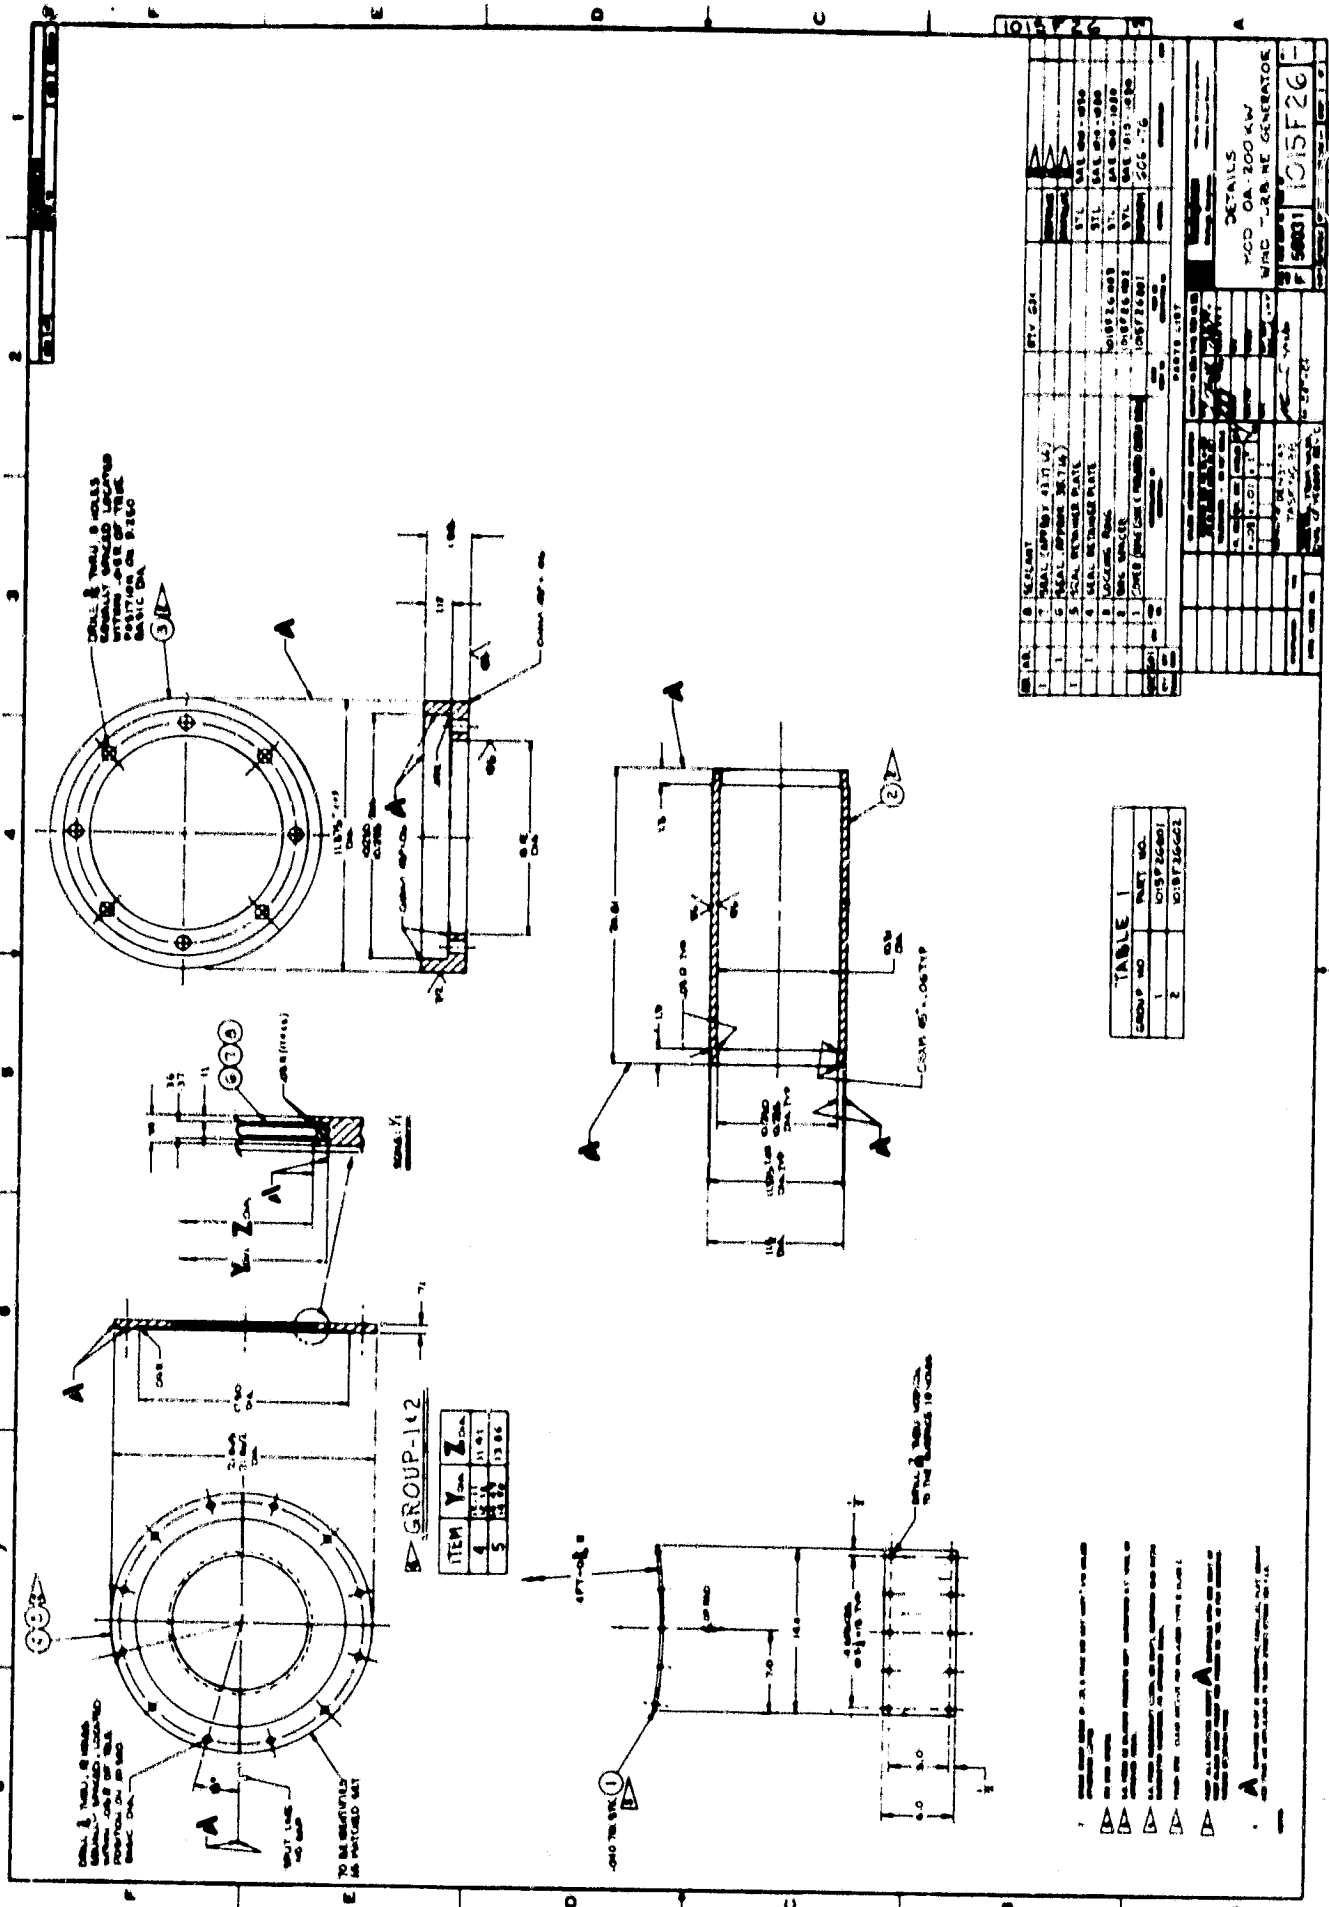



TABLE 1


GROUP NO.	PART NO.
1	1015F2601
2	1015F2602

DETAILS
MOD OA-200AW
WMD - OR NE GENERATOR
P 50031 1015F26

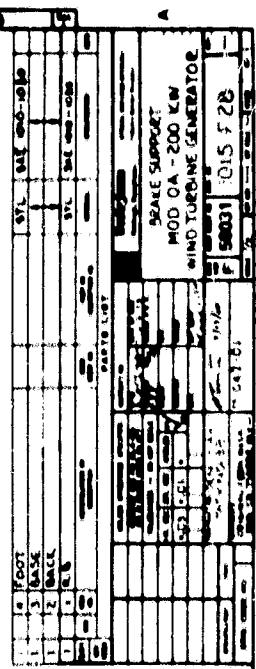


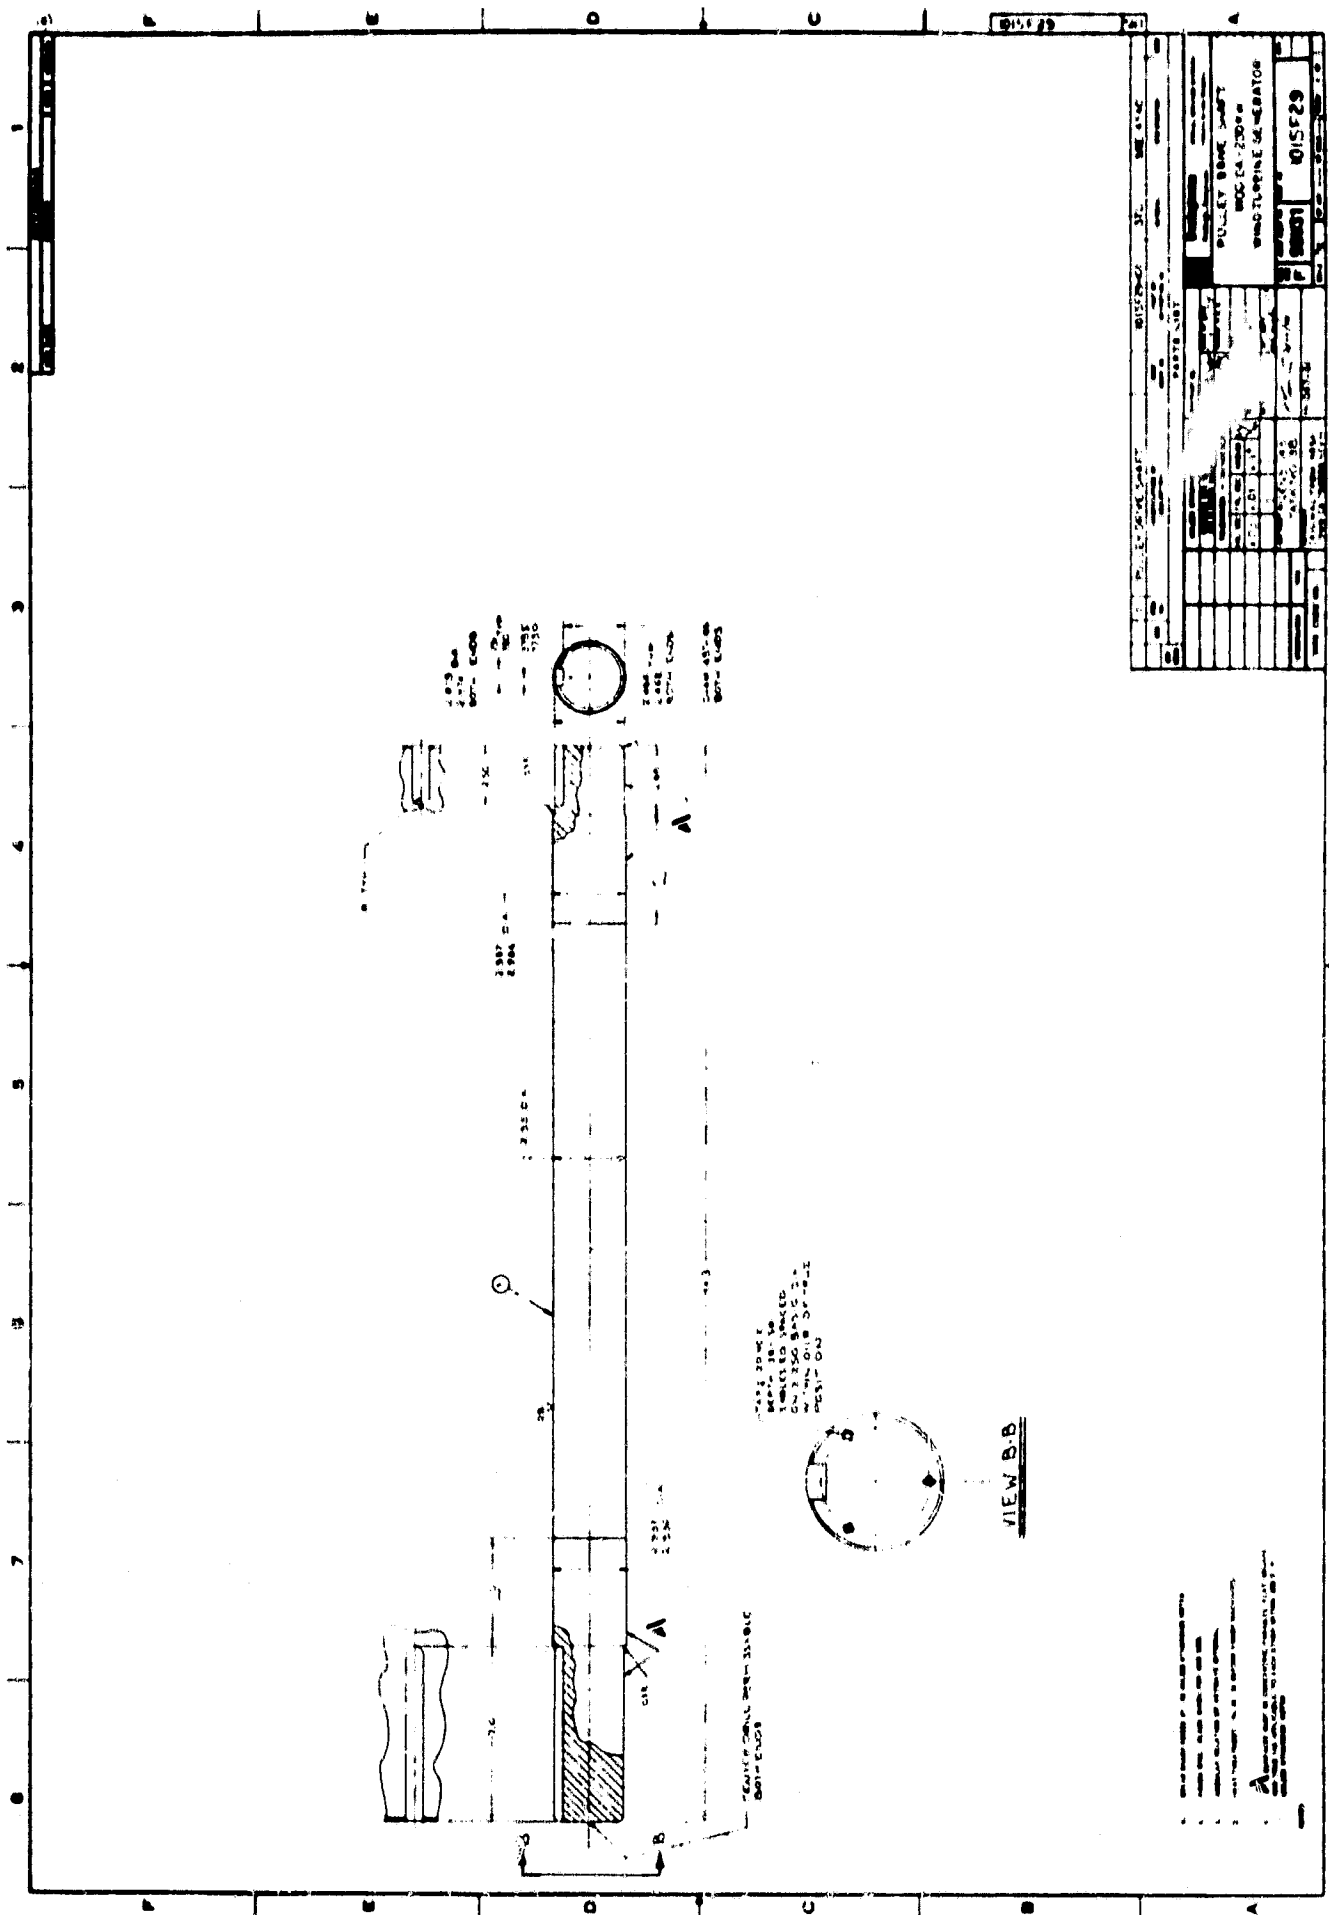


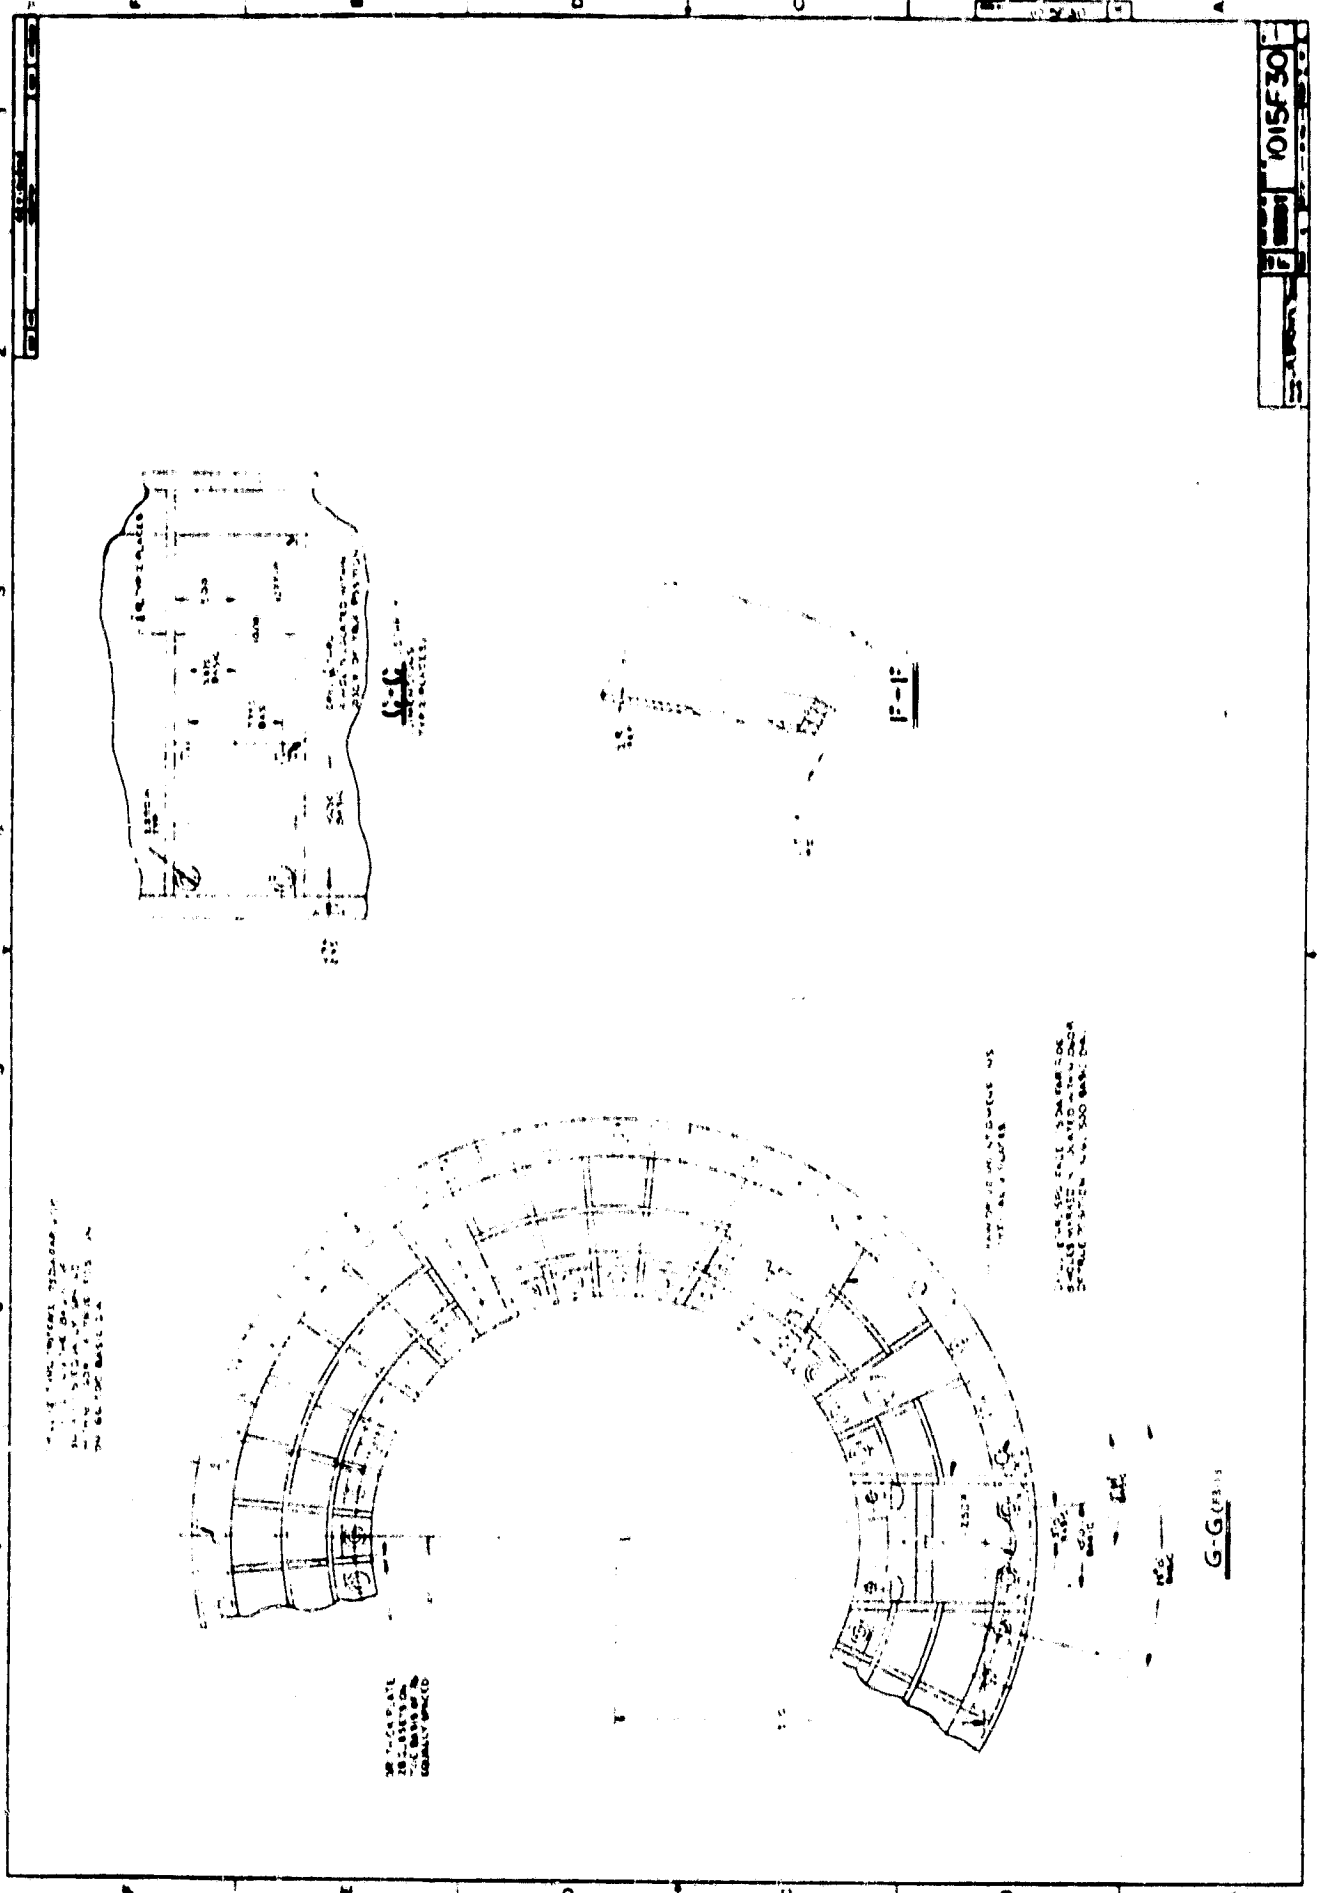

015F30

G-G (P. 1)

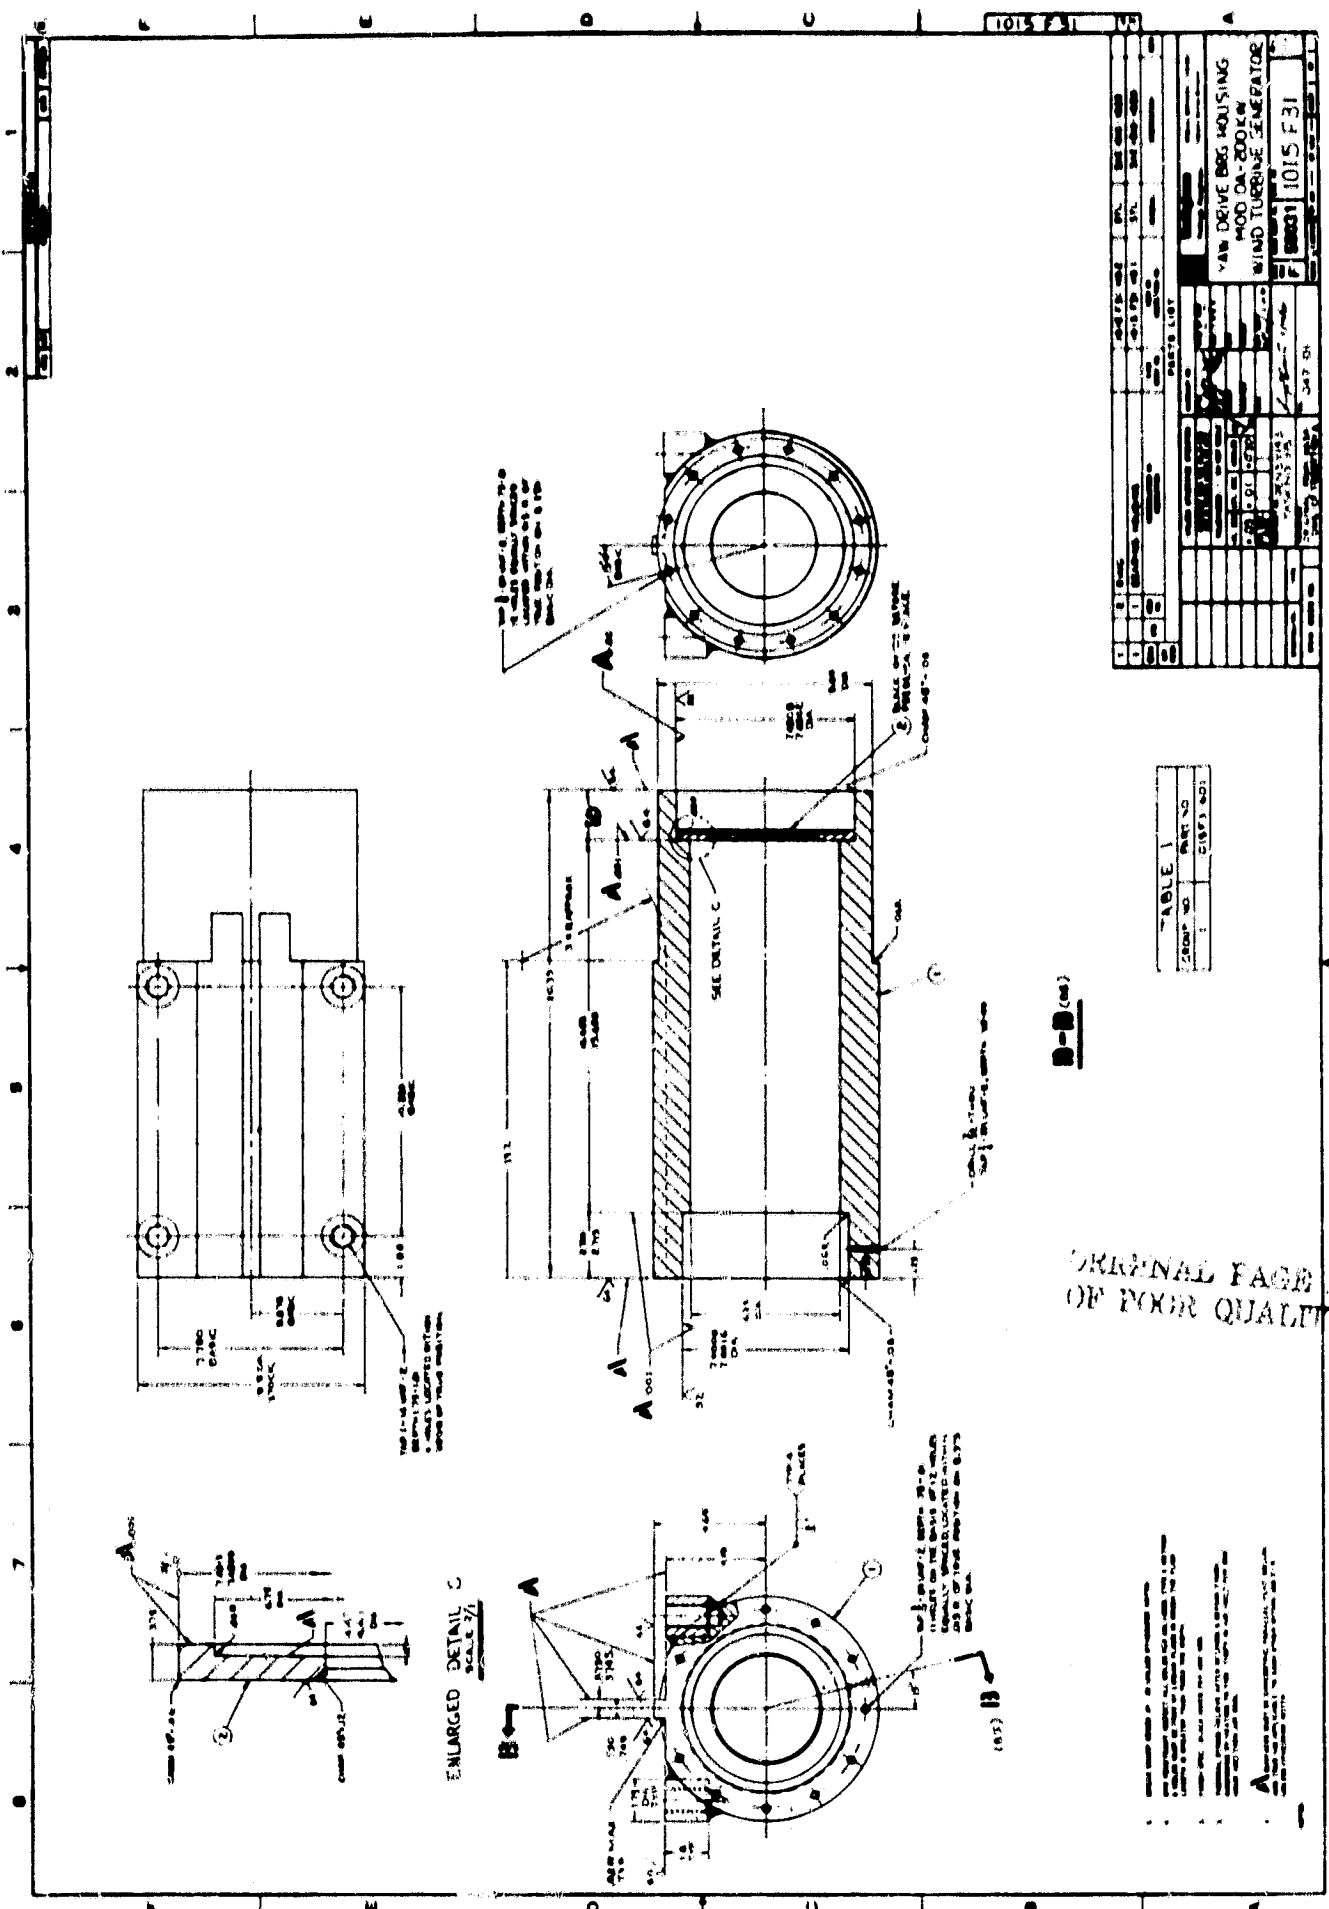


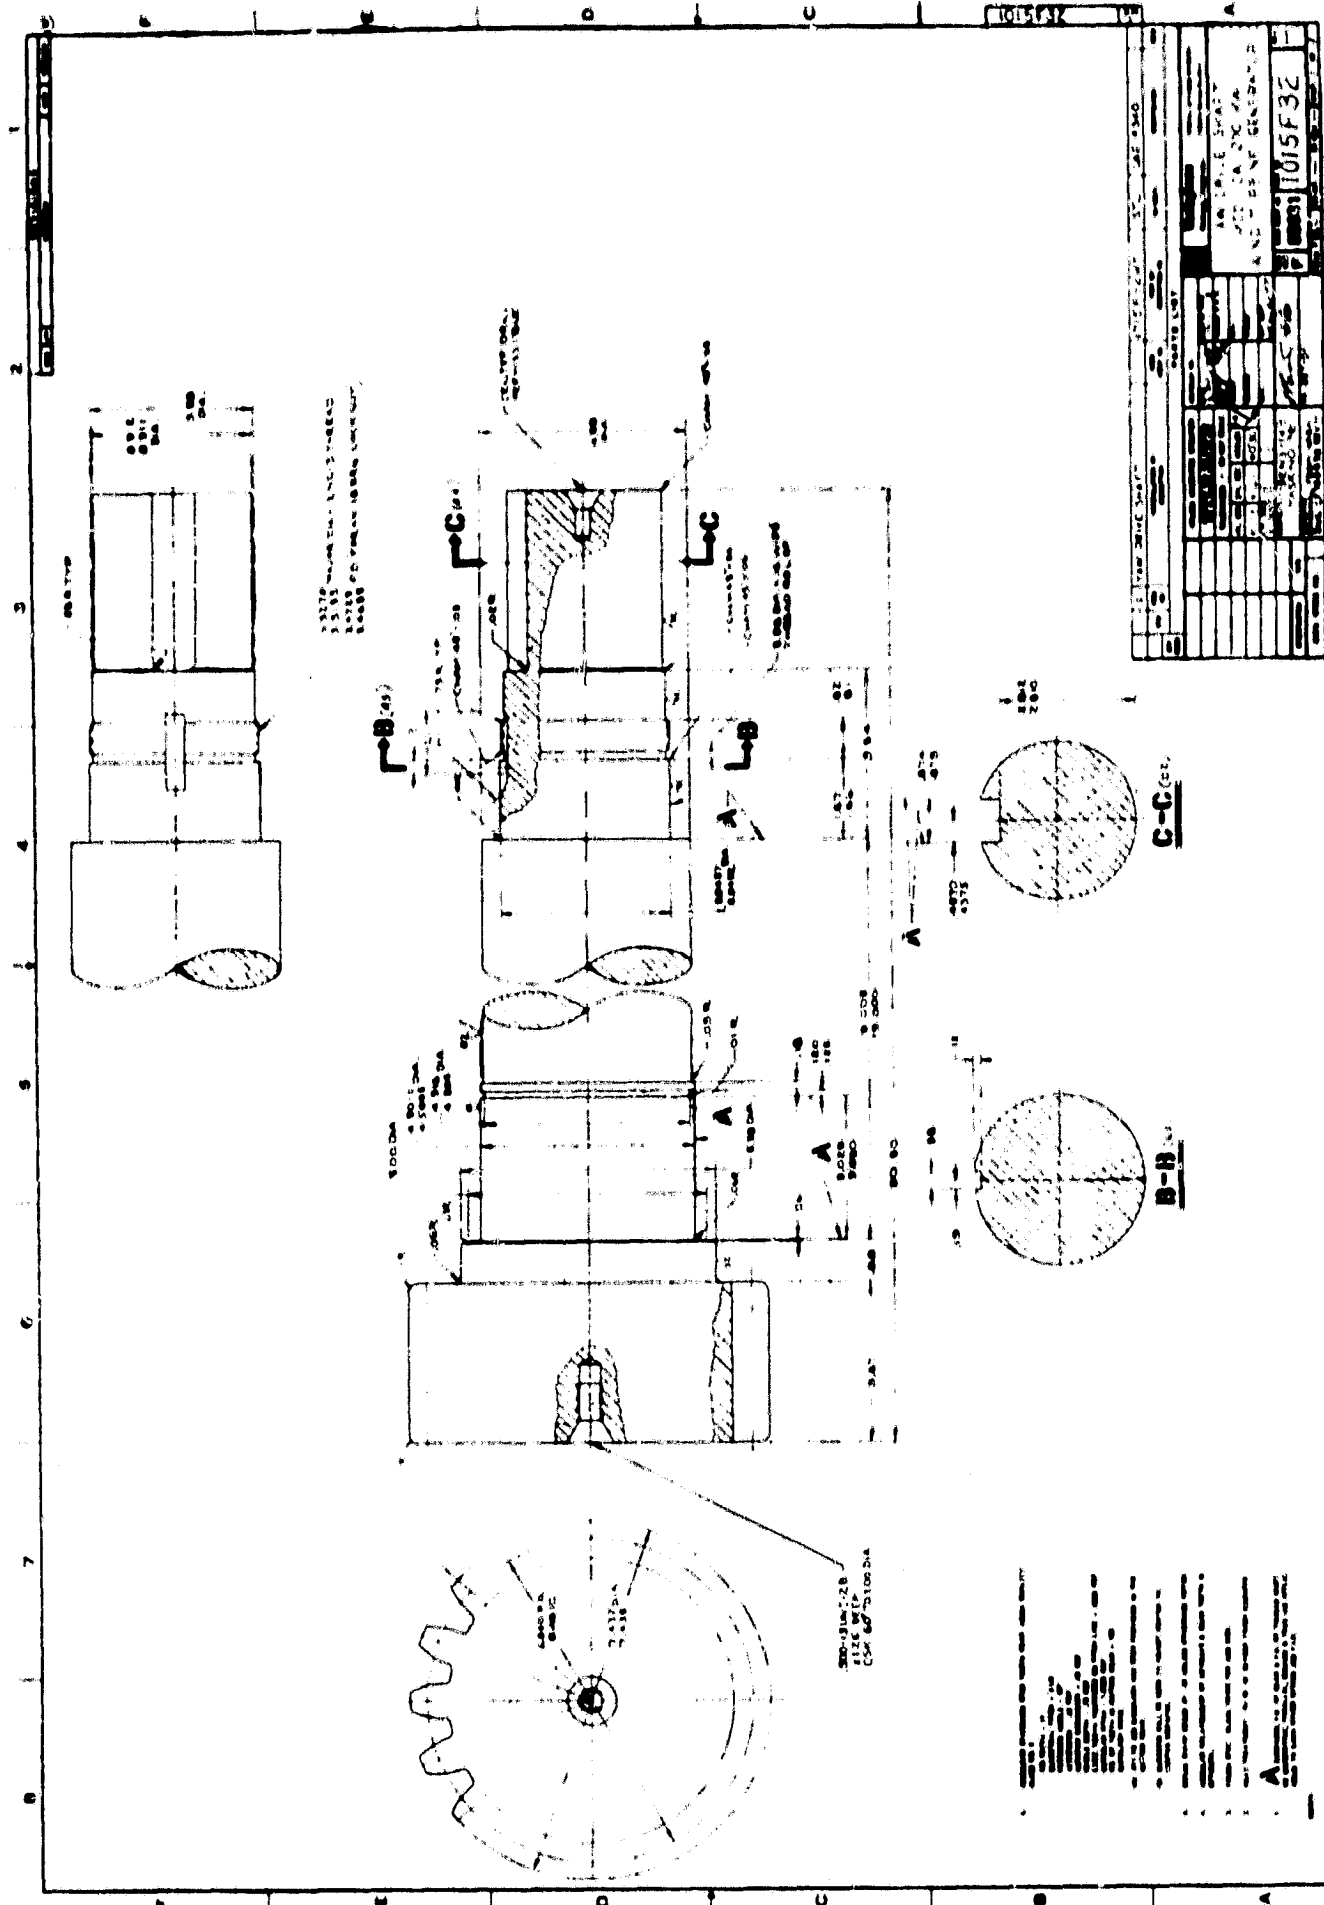

[illegible]

2

1	2	
---	---	---	---	---	---	---	---	---	----	----	-----

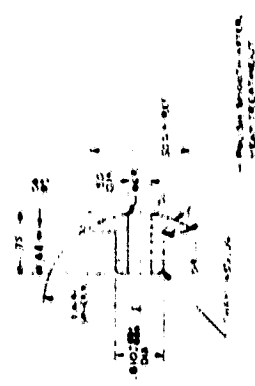


— 42 —


1 2 





[illegible]

[illegible]

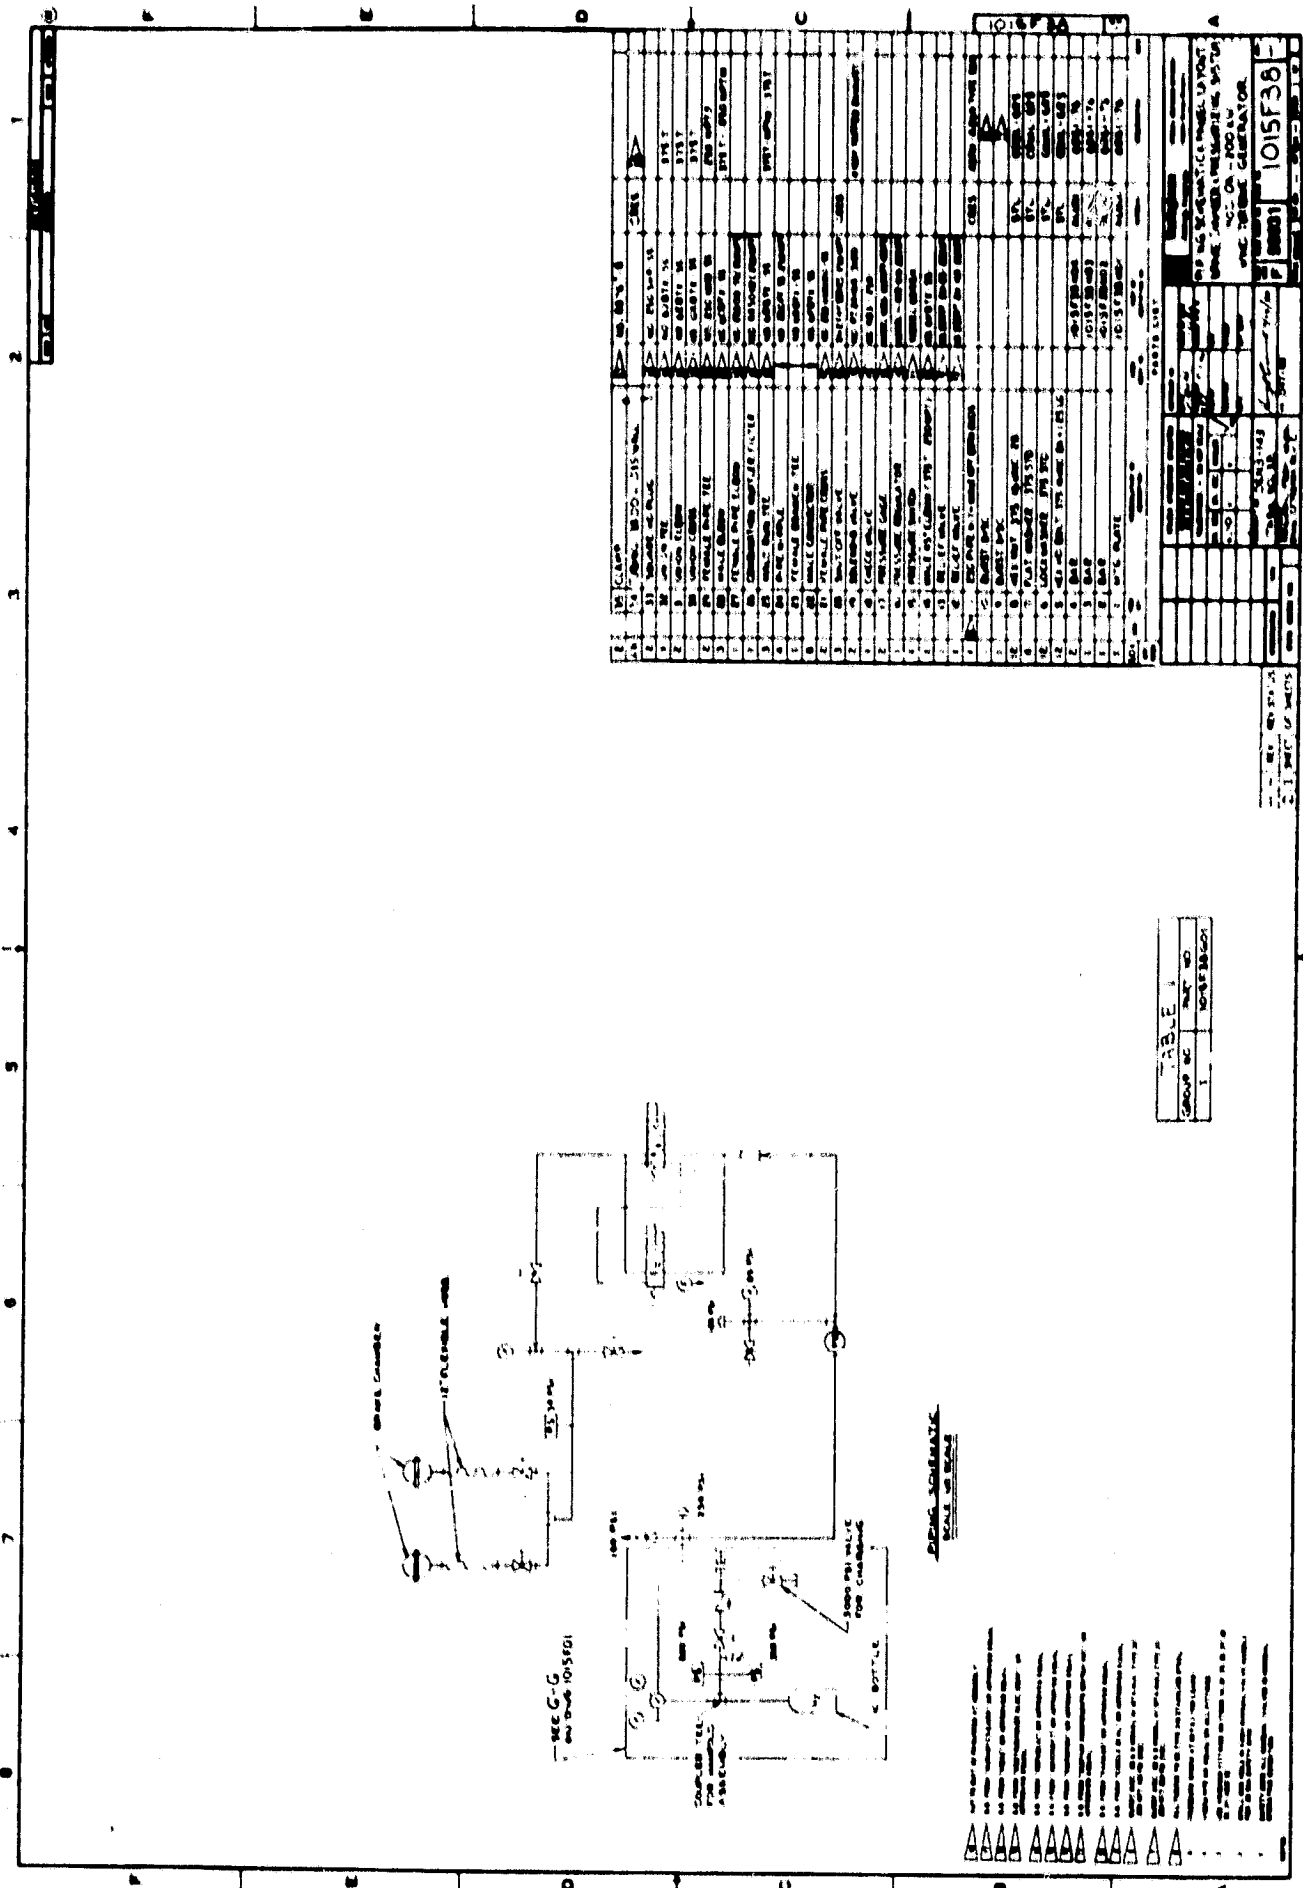

SEE G-6
AND DRAW 1015501















1015F38

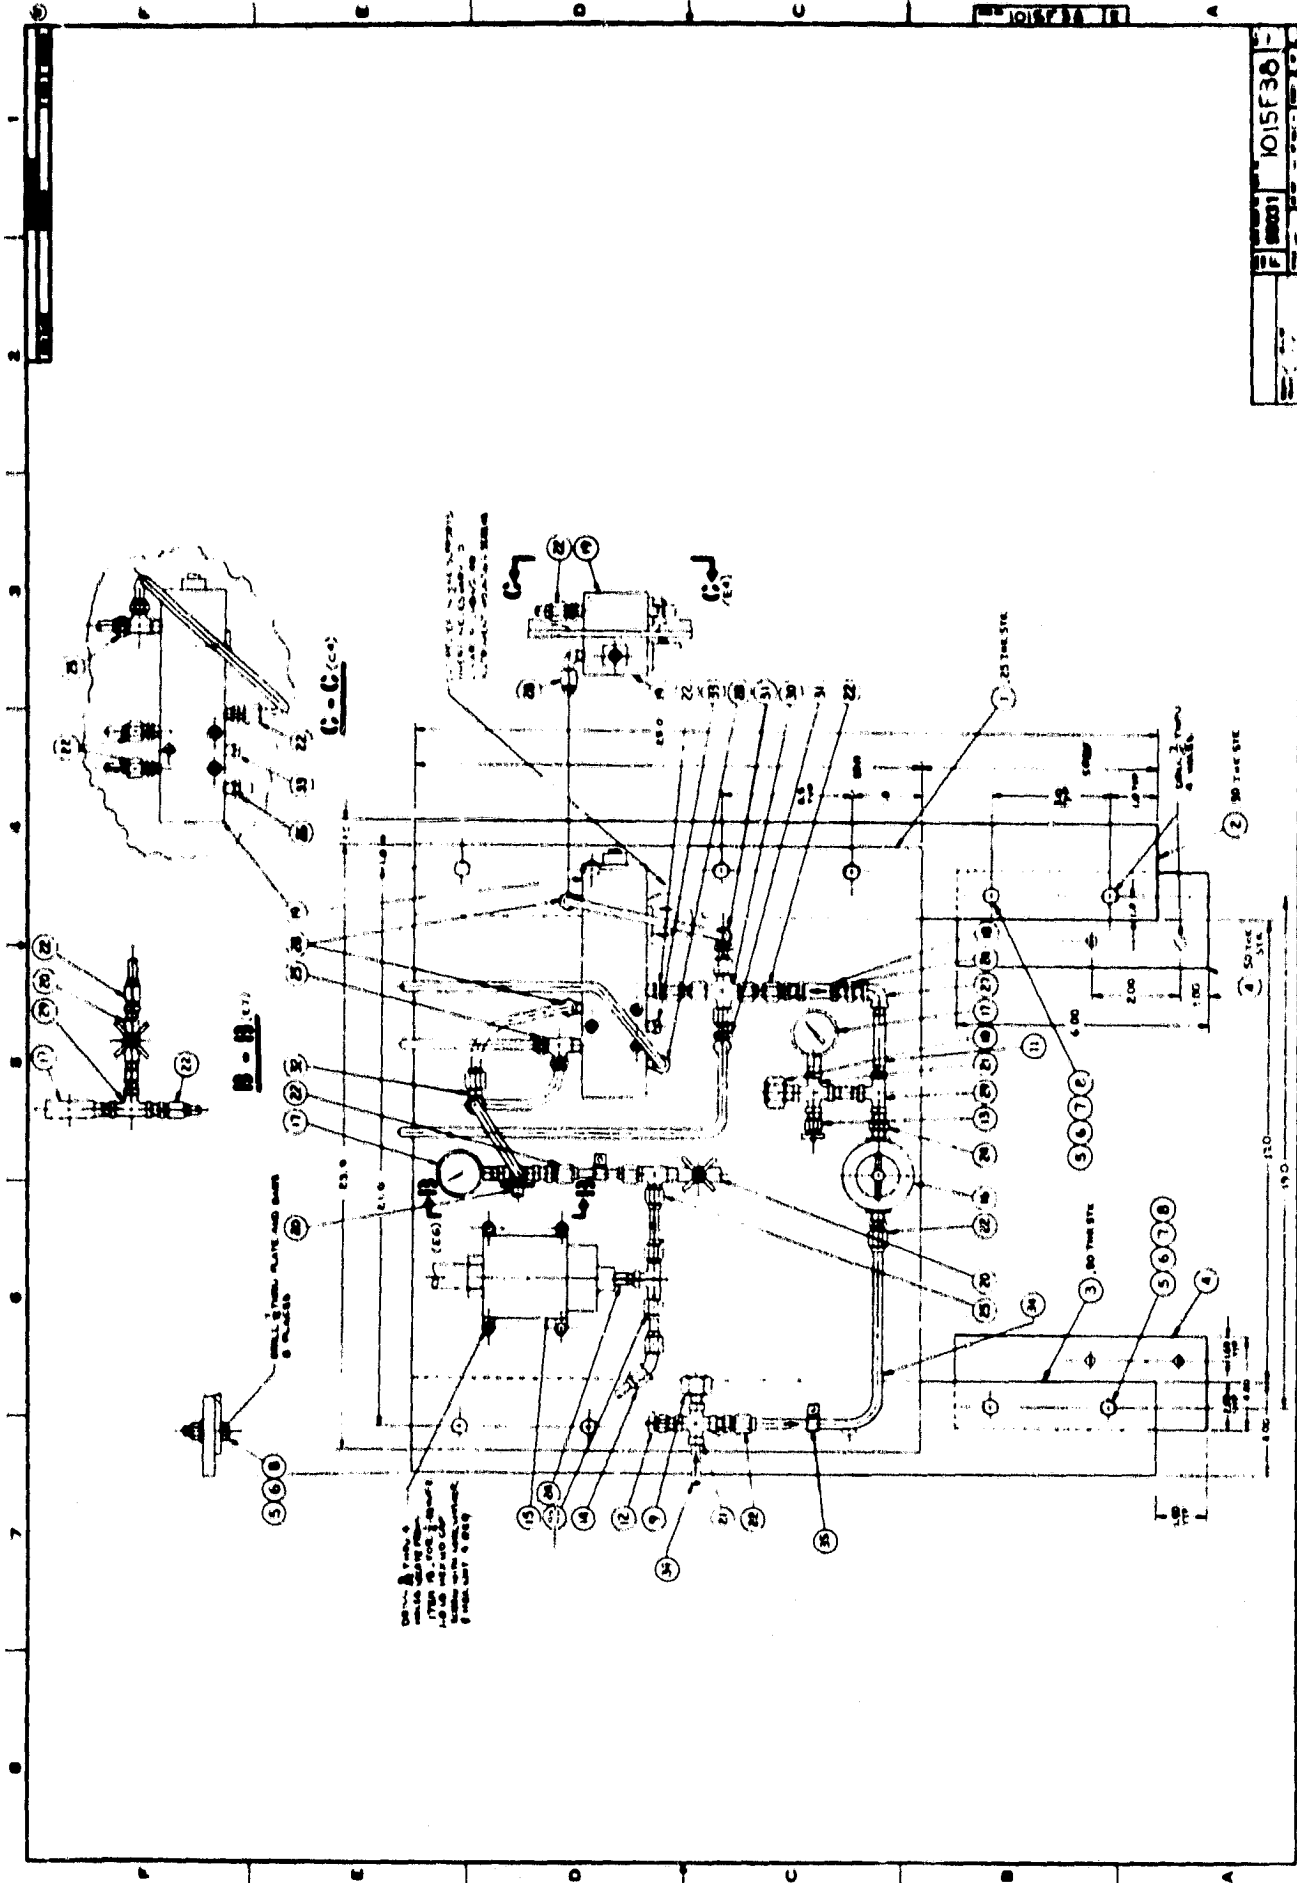


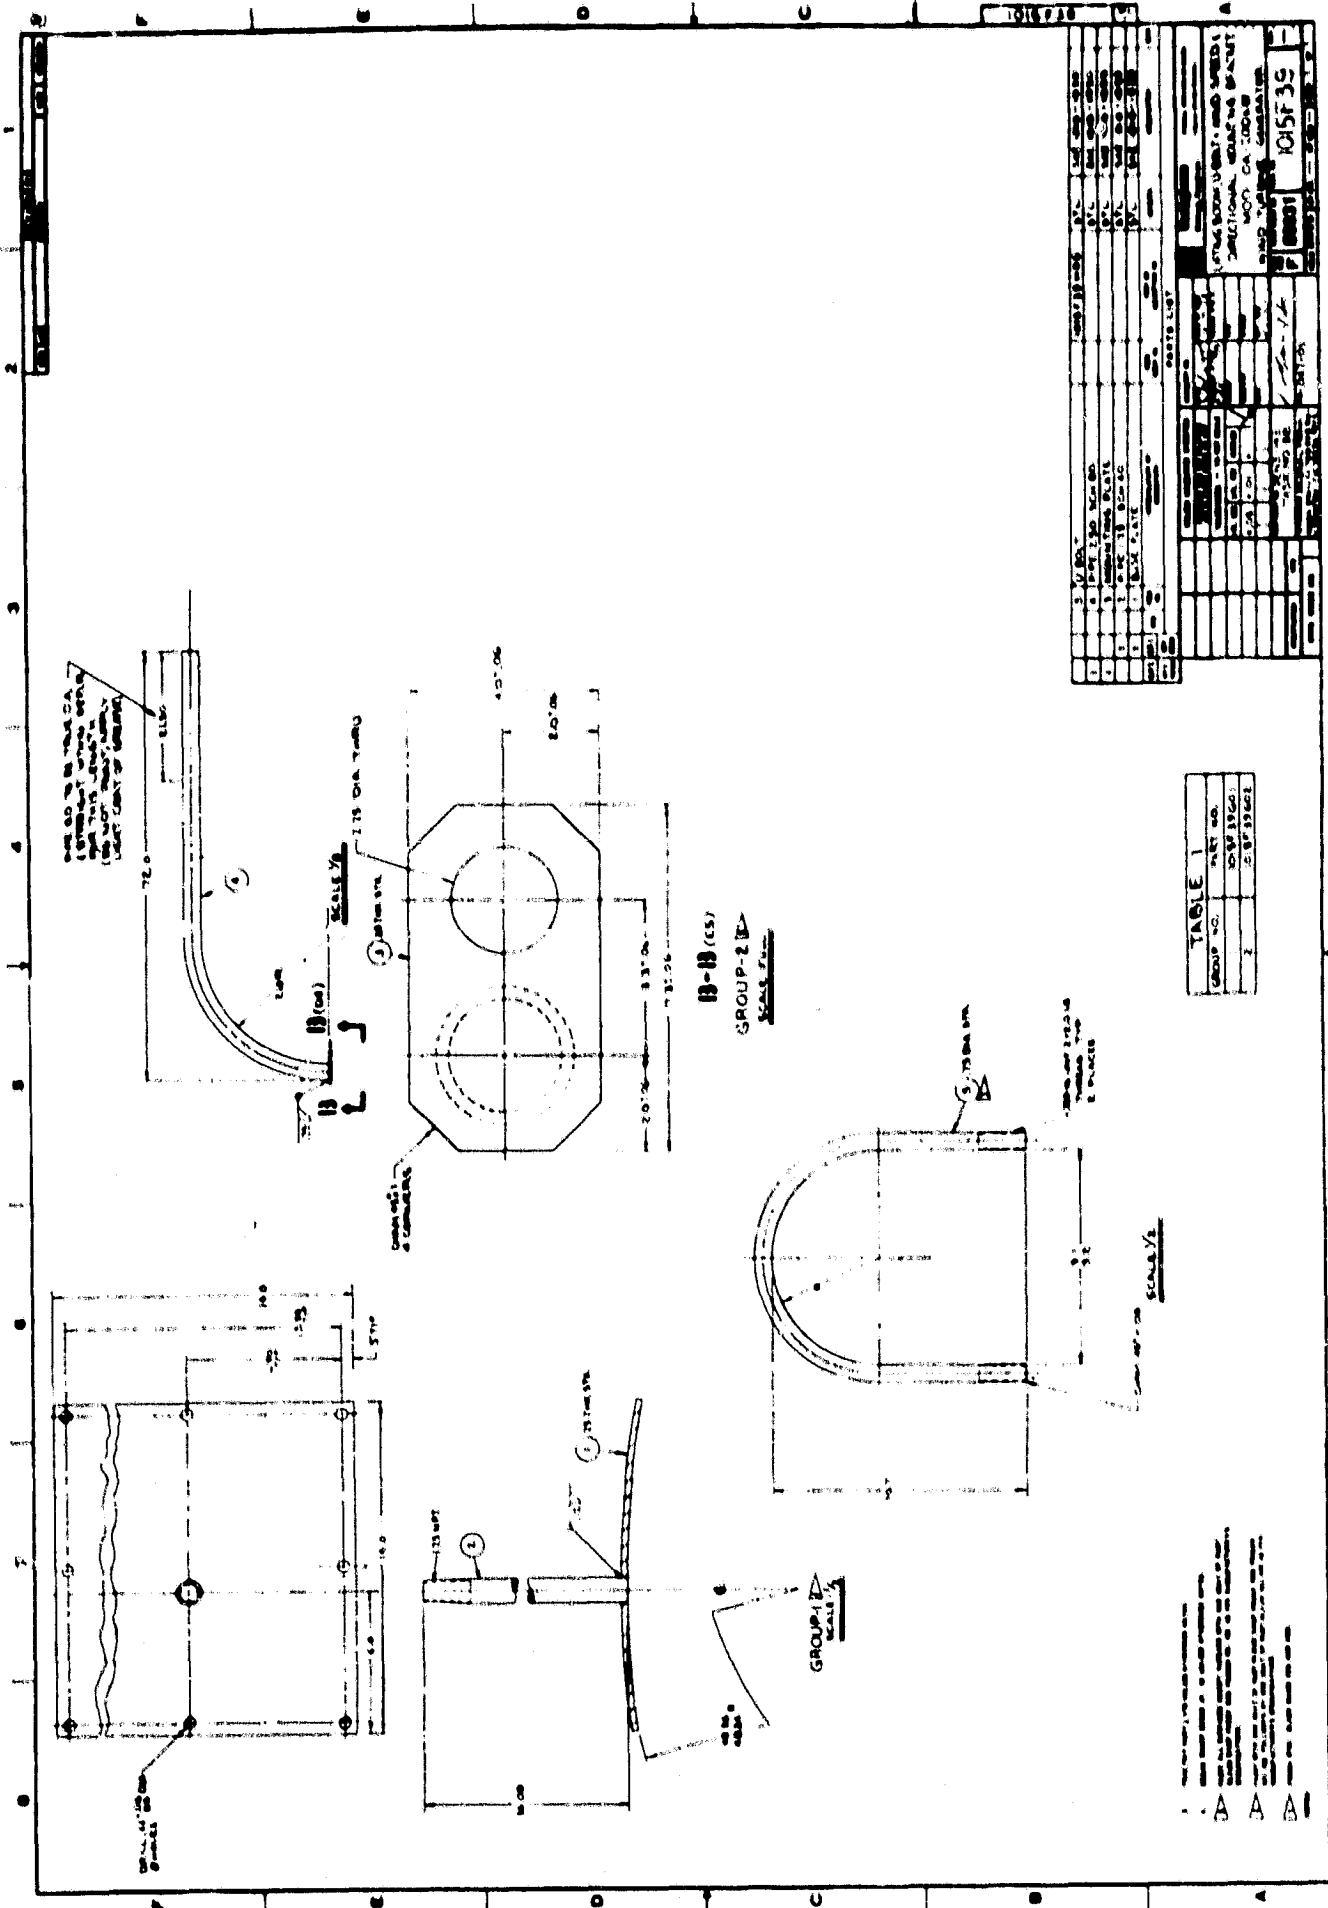


TABLE 1


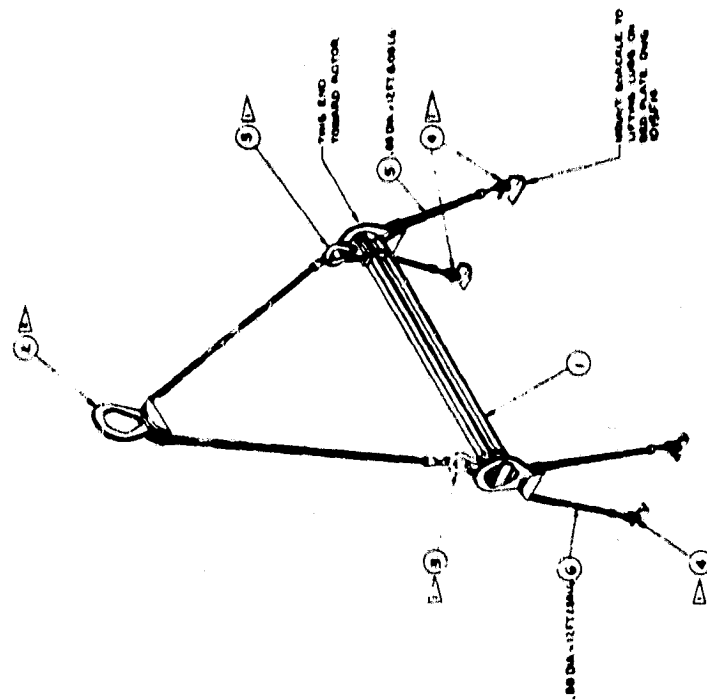

GROUP 1

TABLE 1	
COMP. NO.	PART NO.
1	1015F41

PARTS LIST	
1015F41









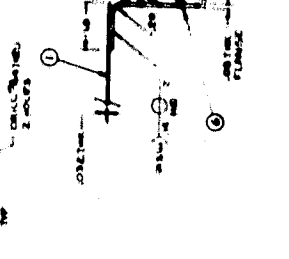




TABLE	
1	1015F42
2	1015F42



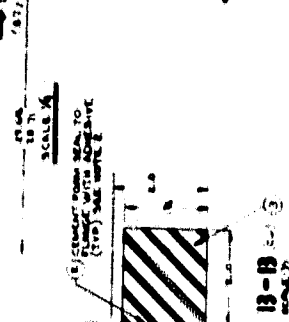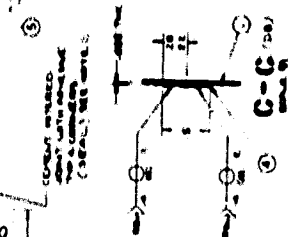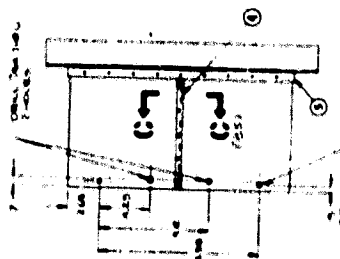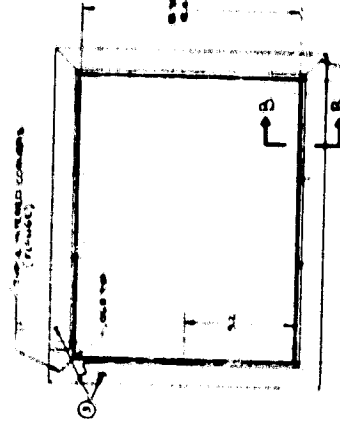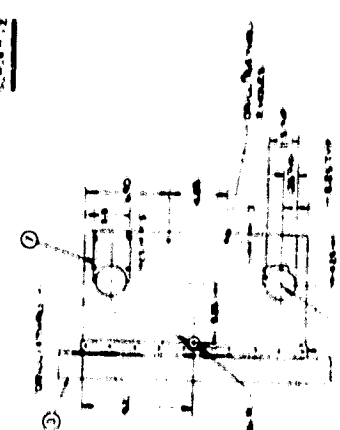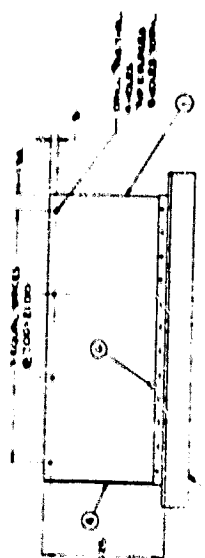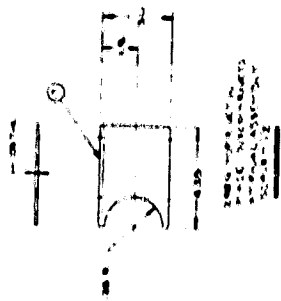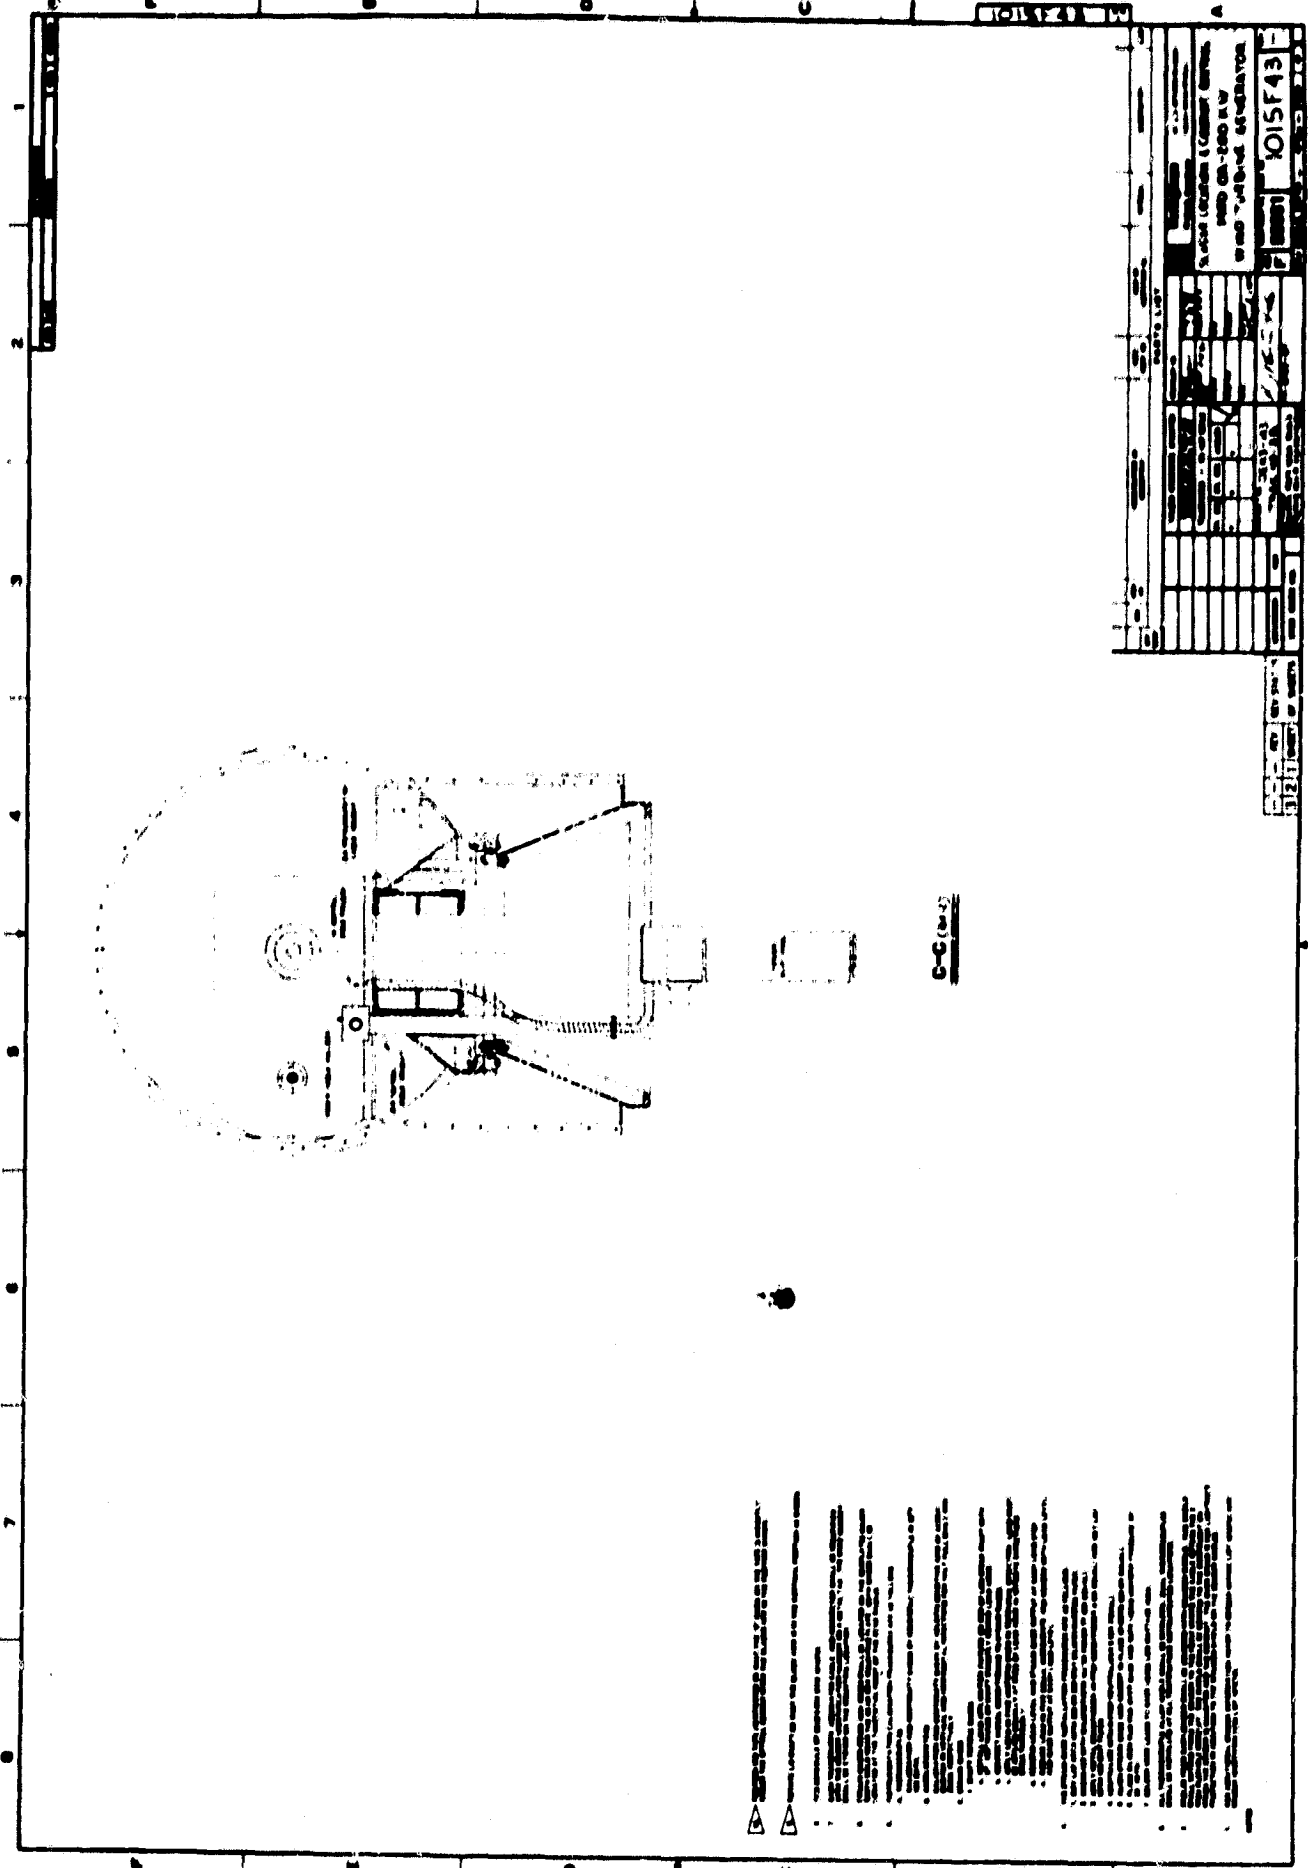

1015F43

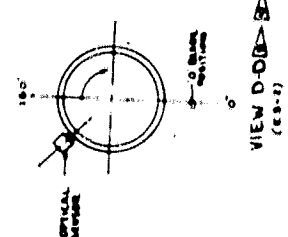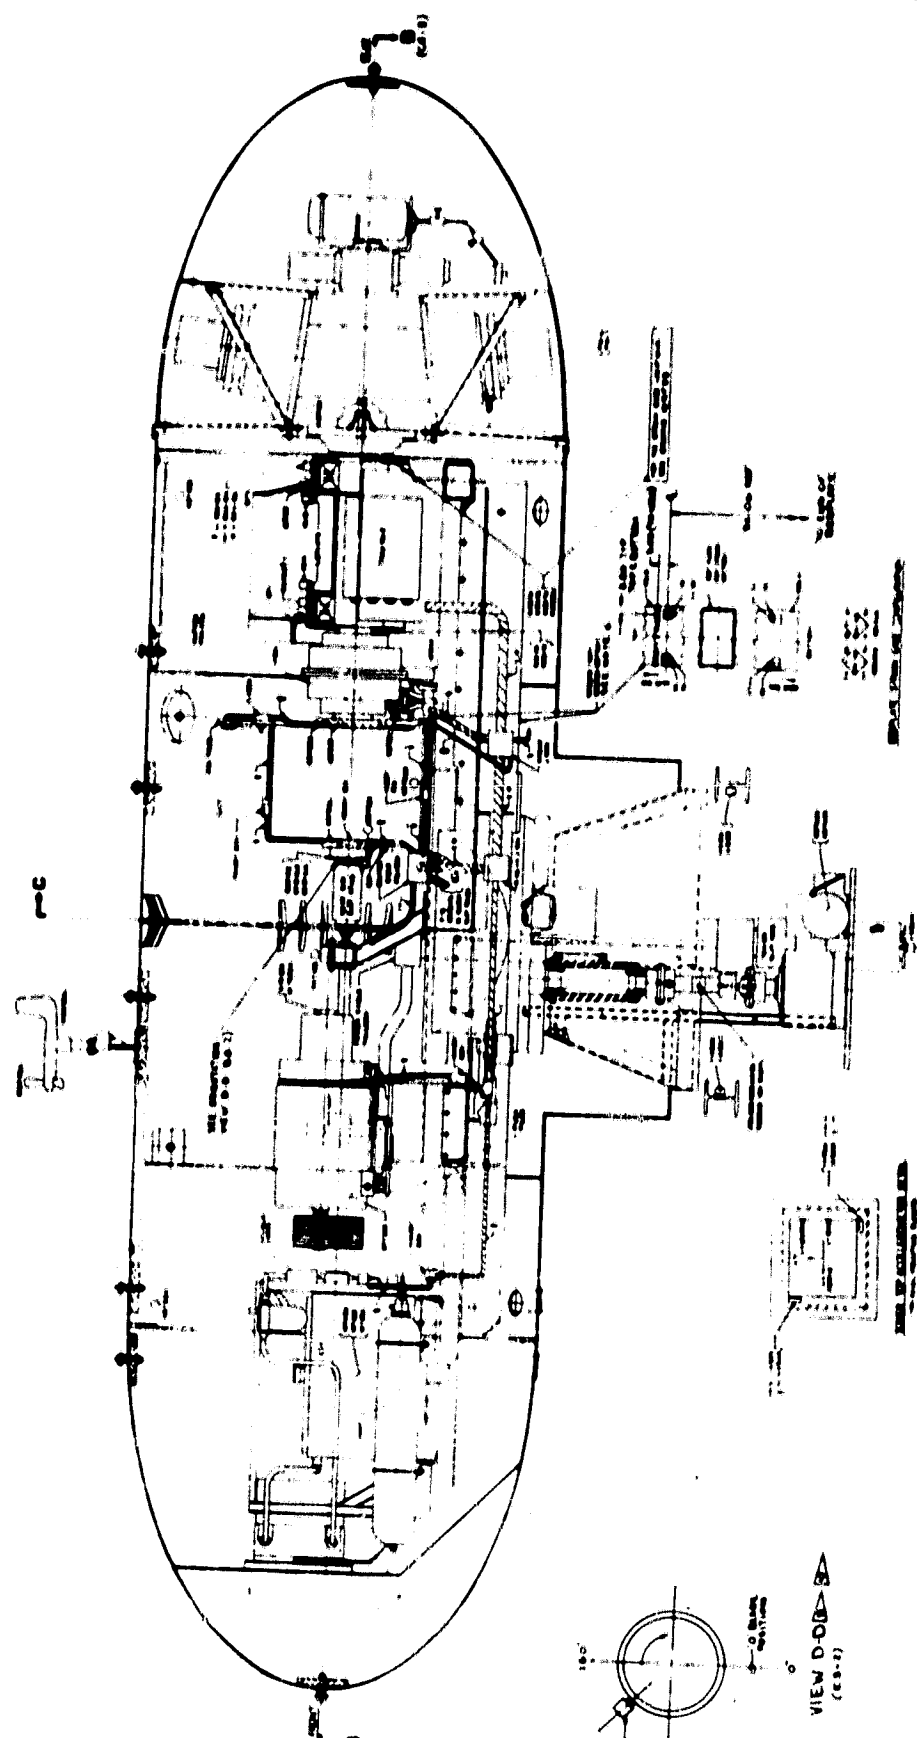

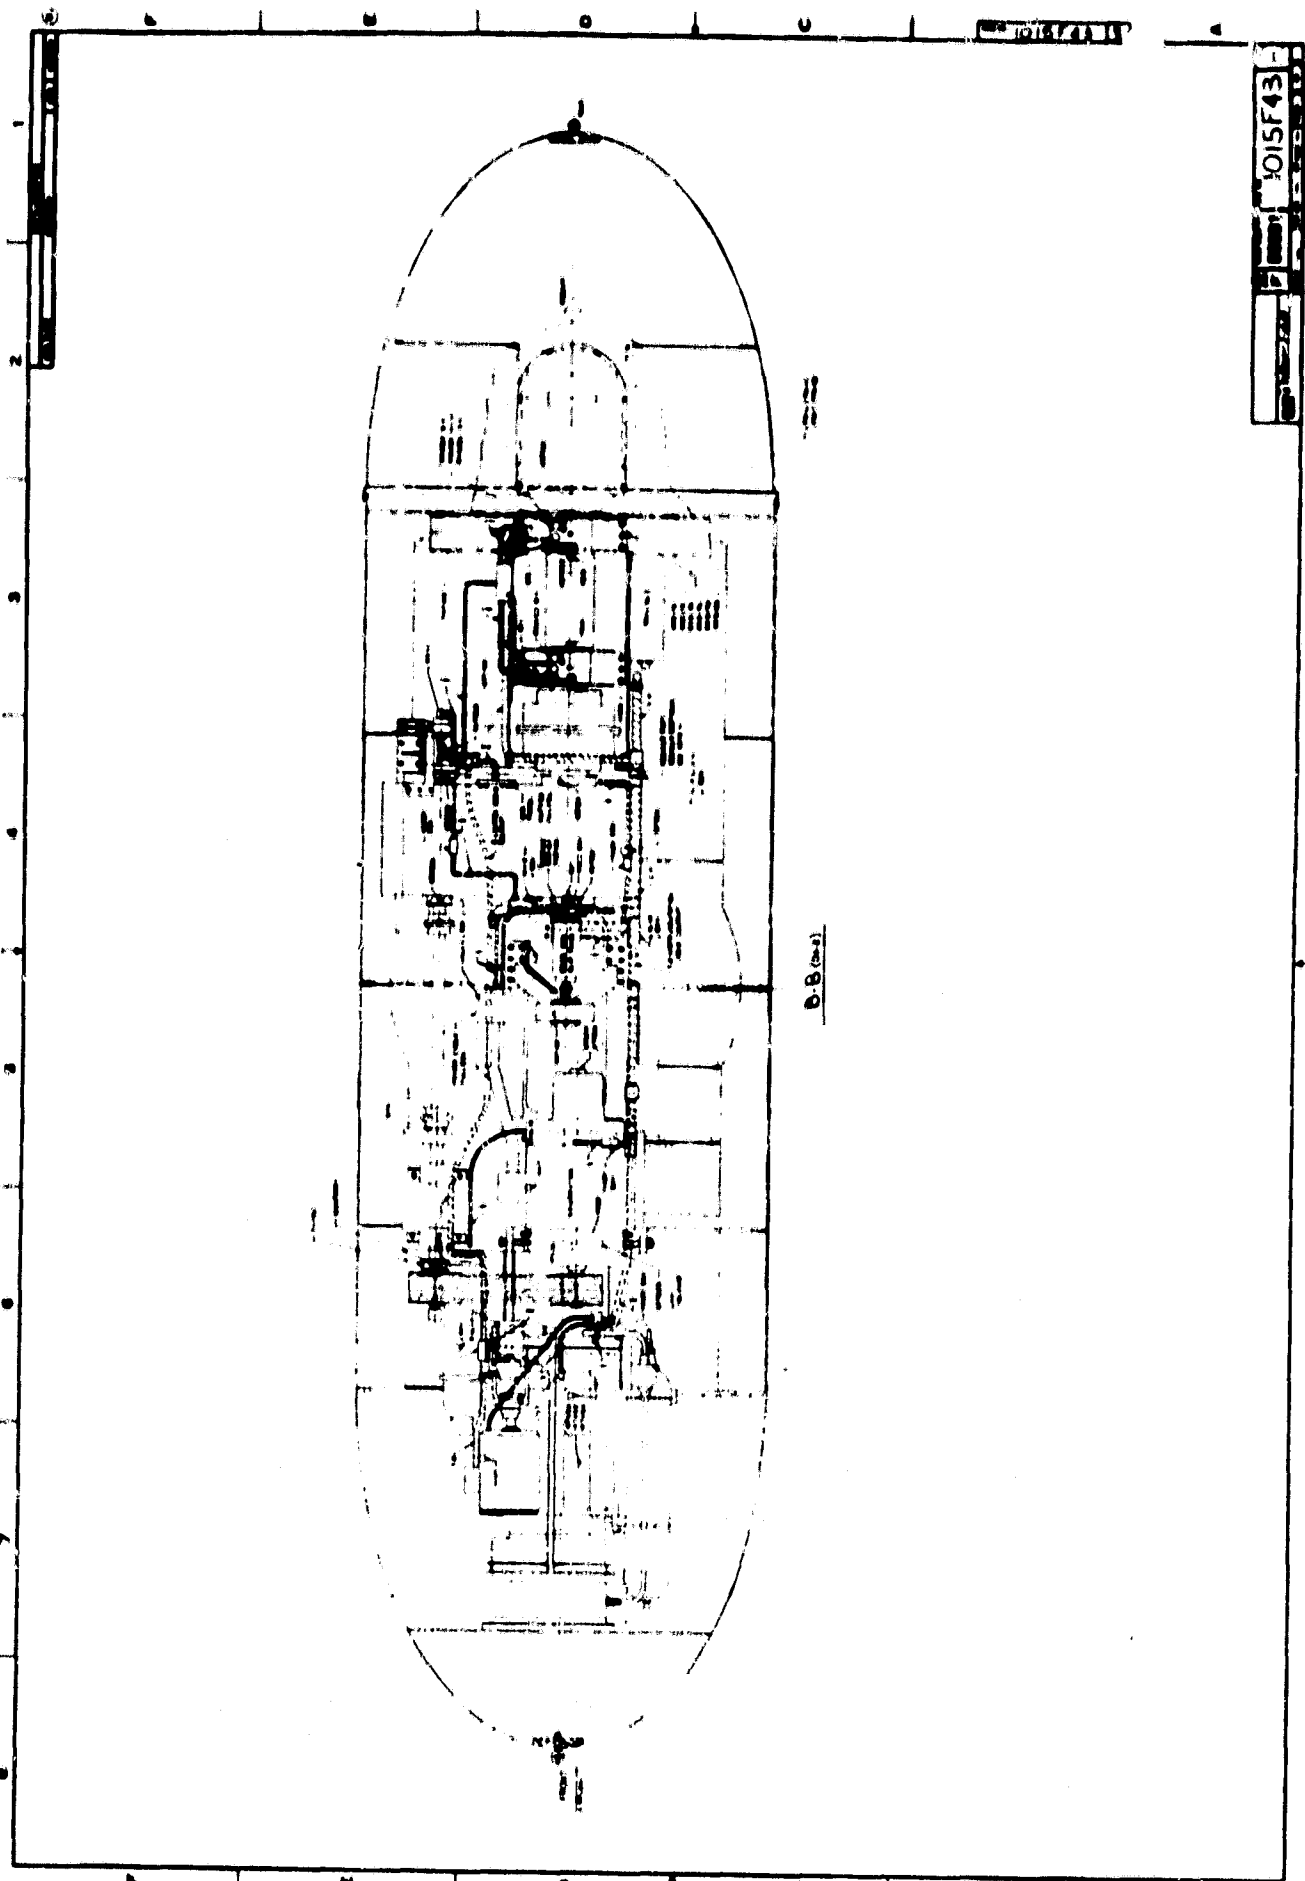

1015F43

0.8 (1/2)

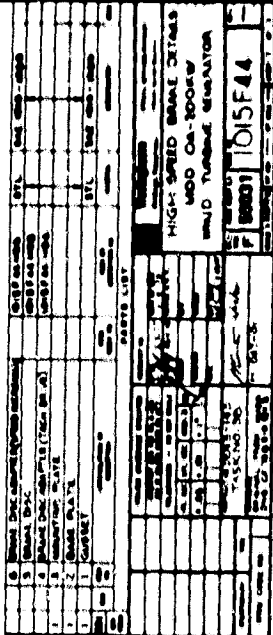


TABLE 1	
GROUP NO.	PART NO.
1	DISF4601

[illegible]


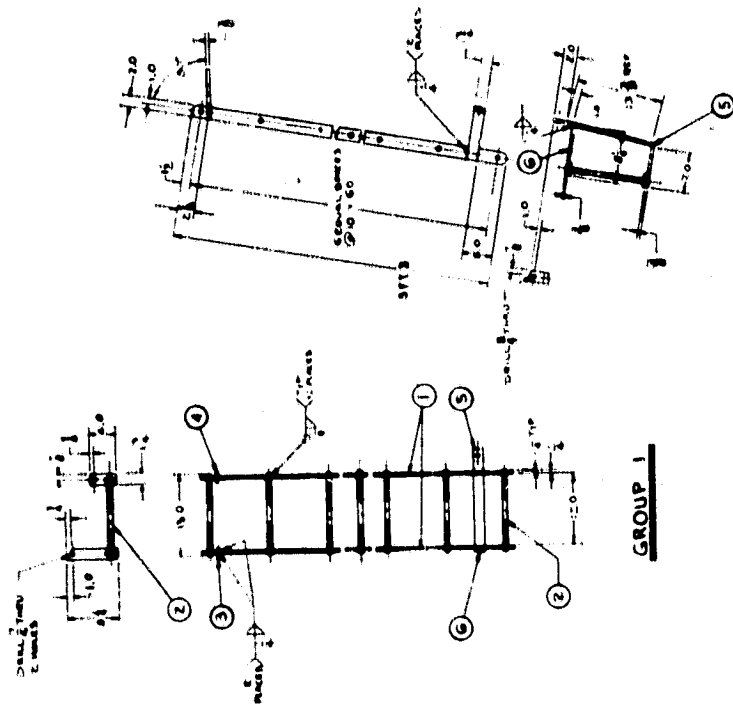




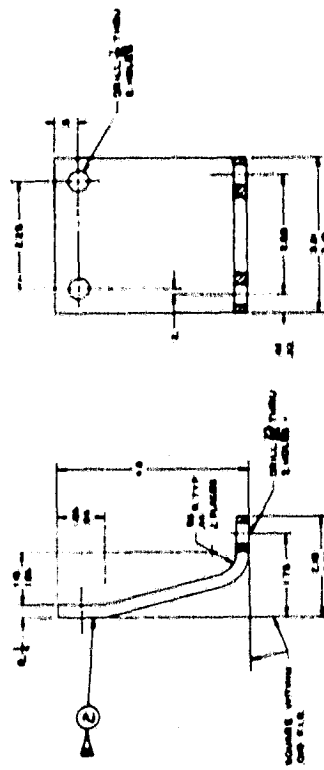

ORIGINAL PAGE IS
OF POOR QUALITY

[illegible]



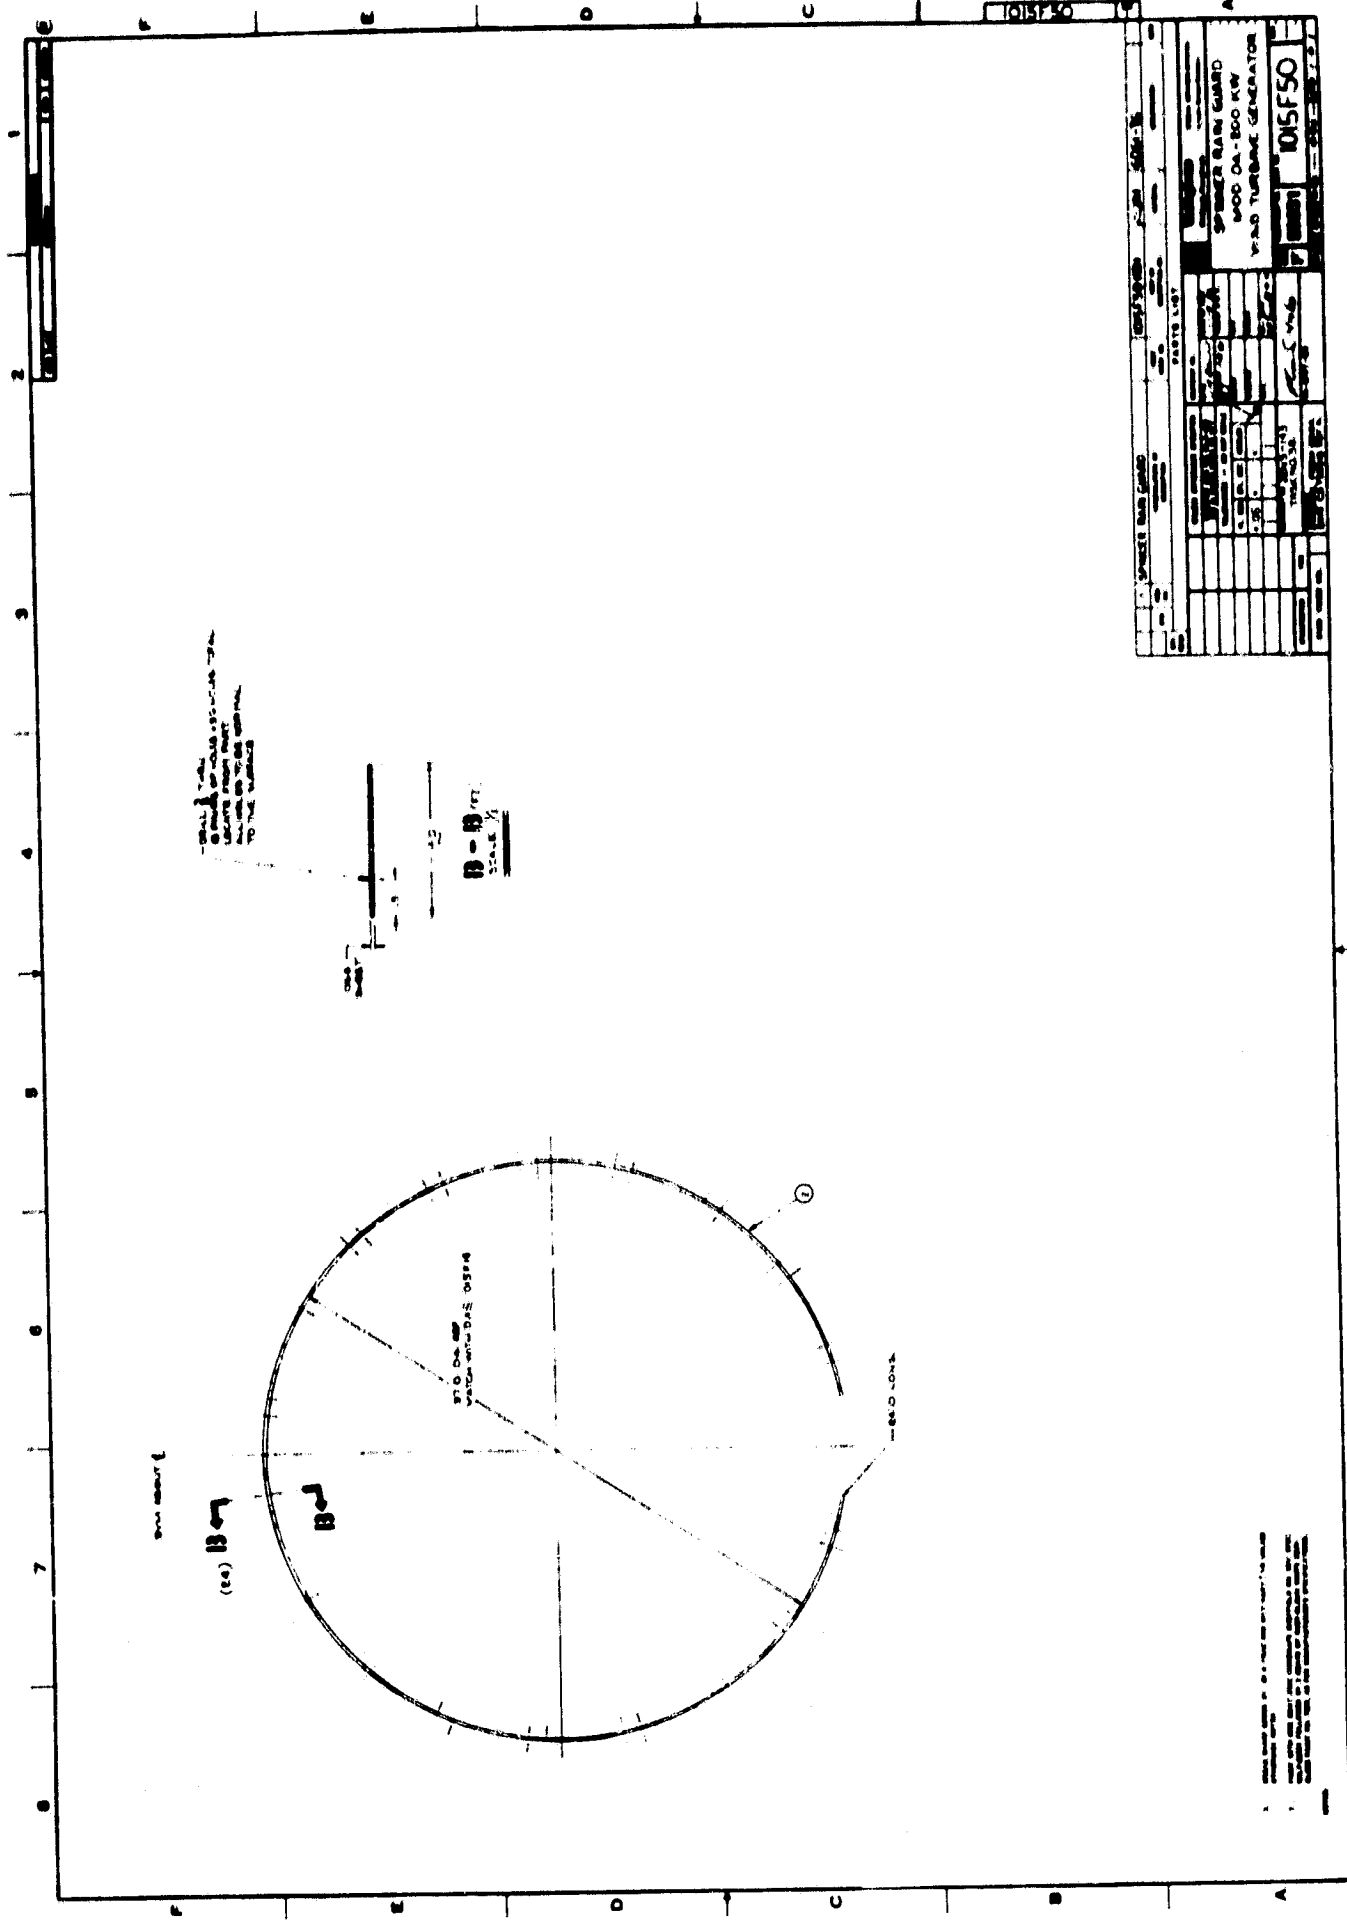



[illegible]






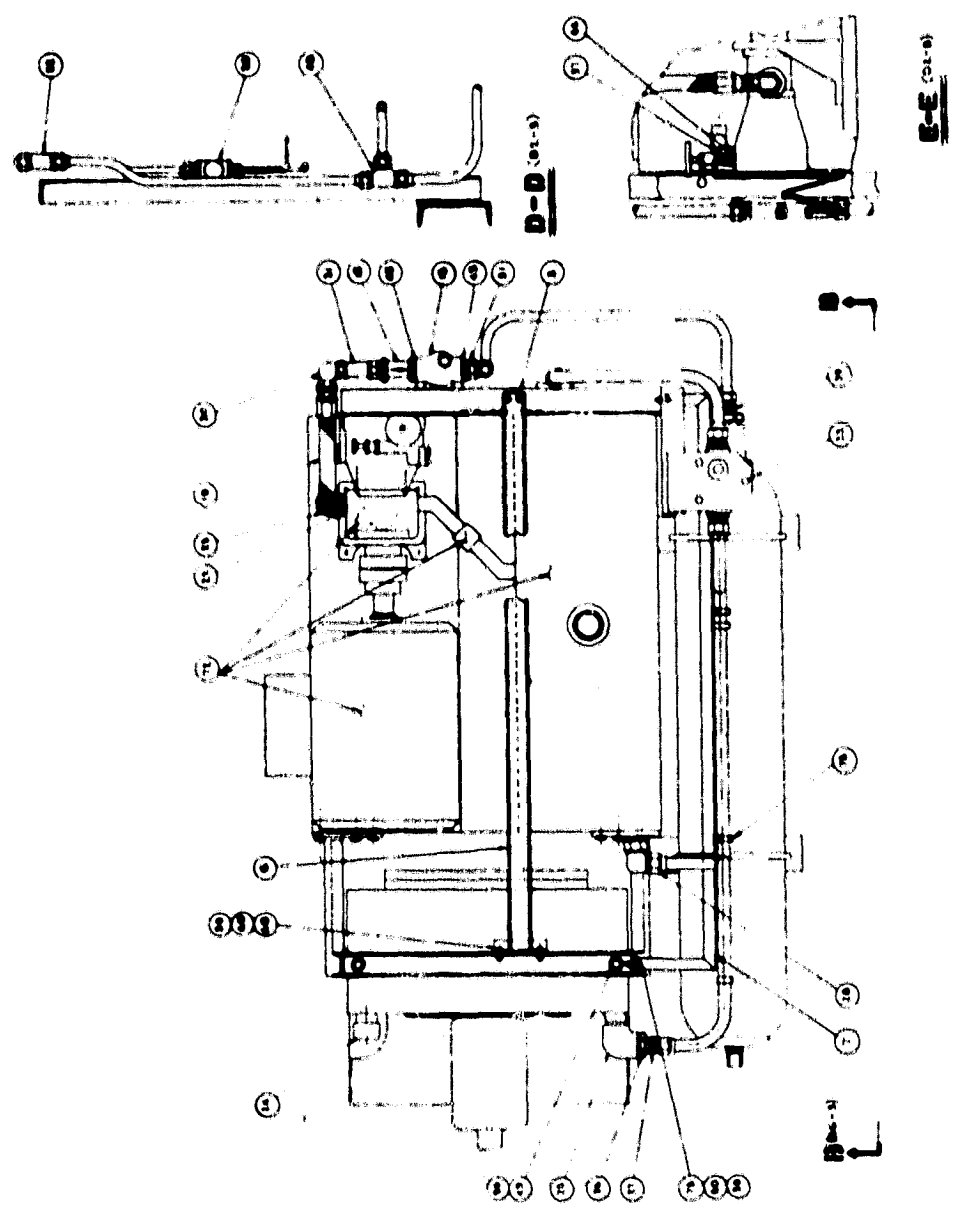


ORIGINAL PAGE IS
OF POOR QUALITY

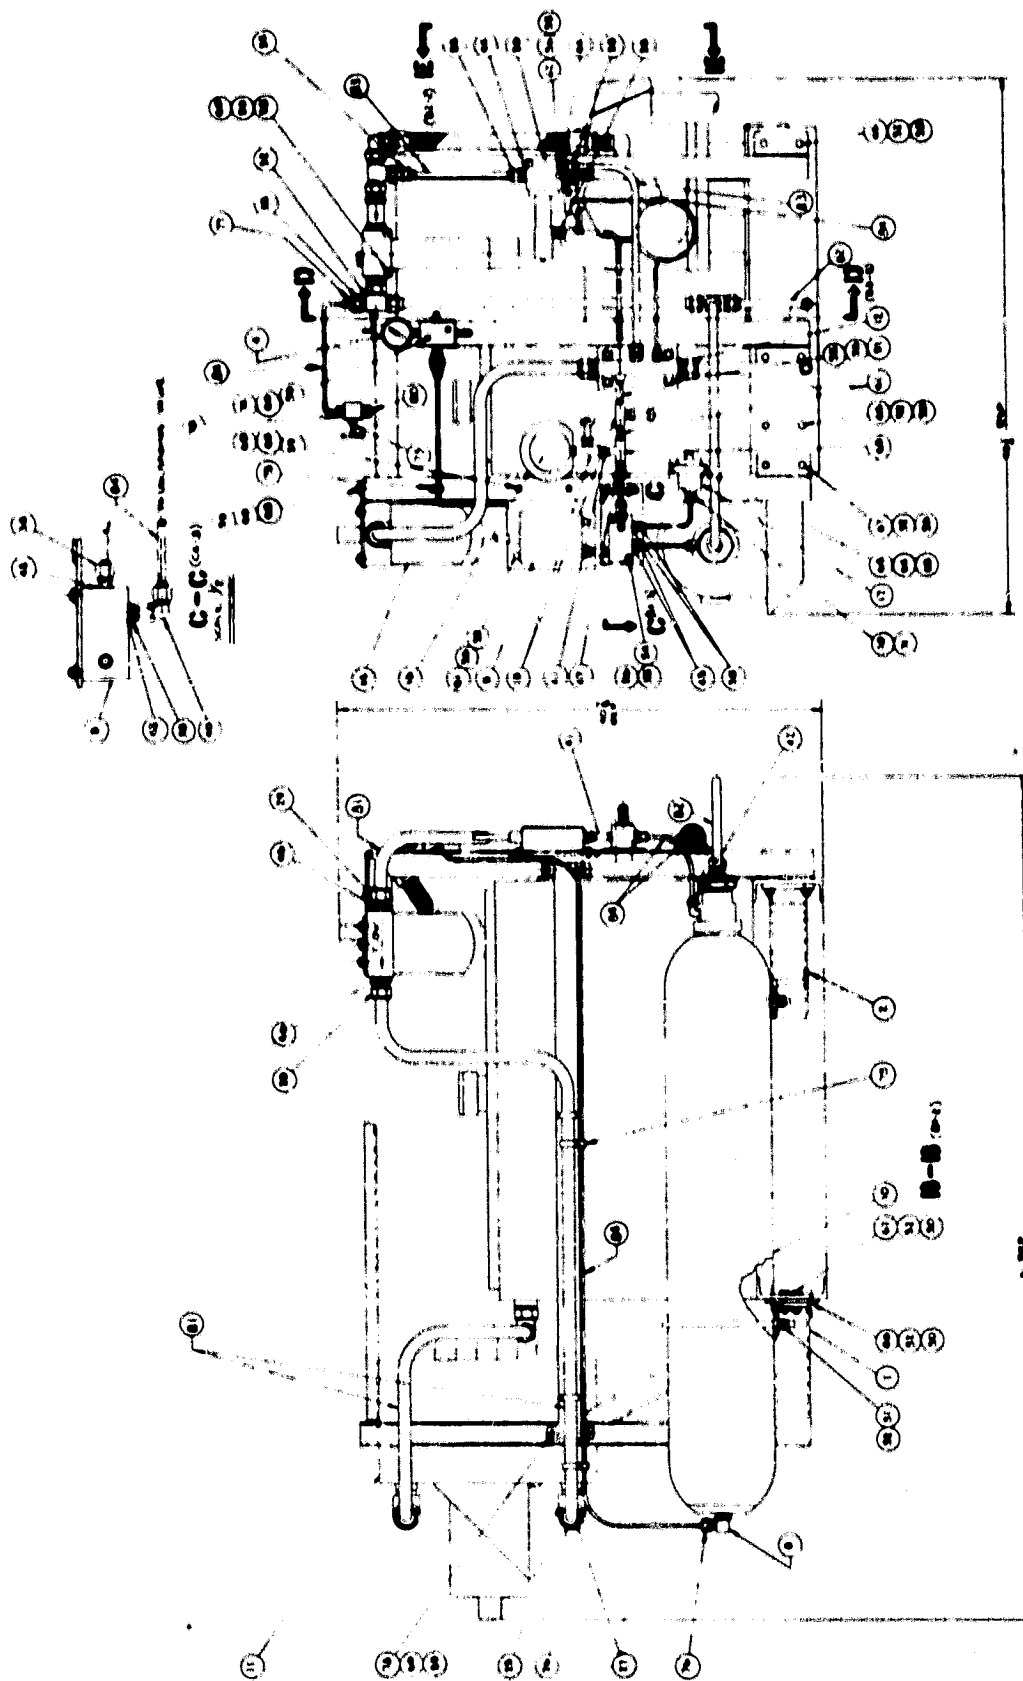


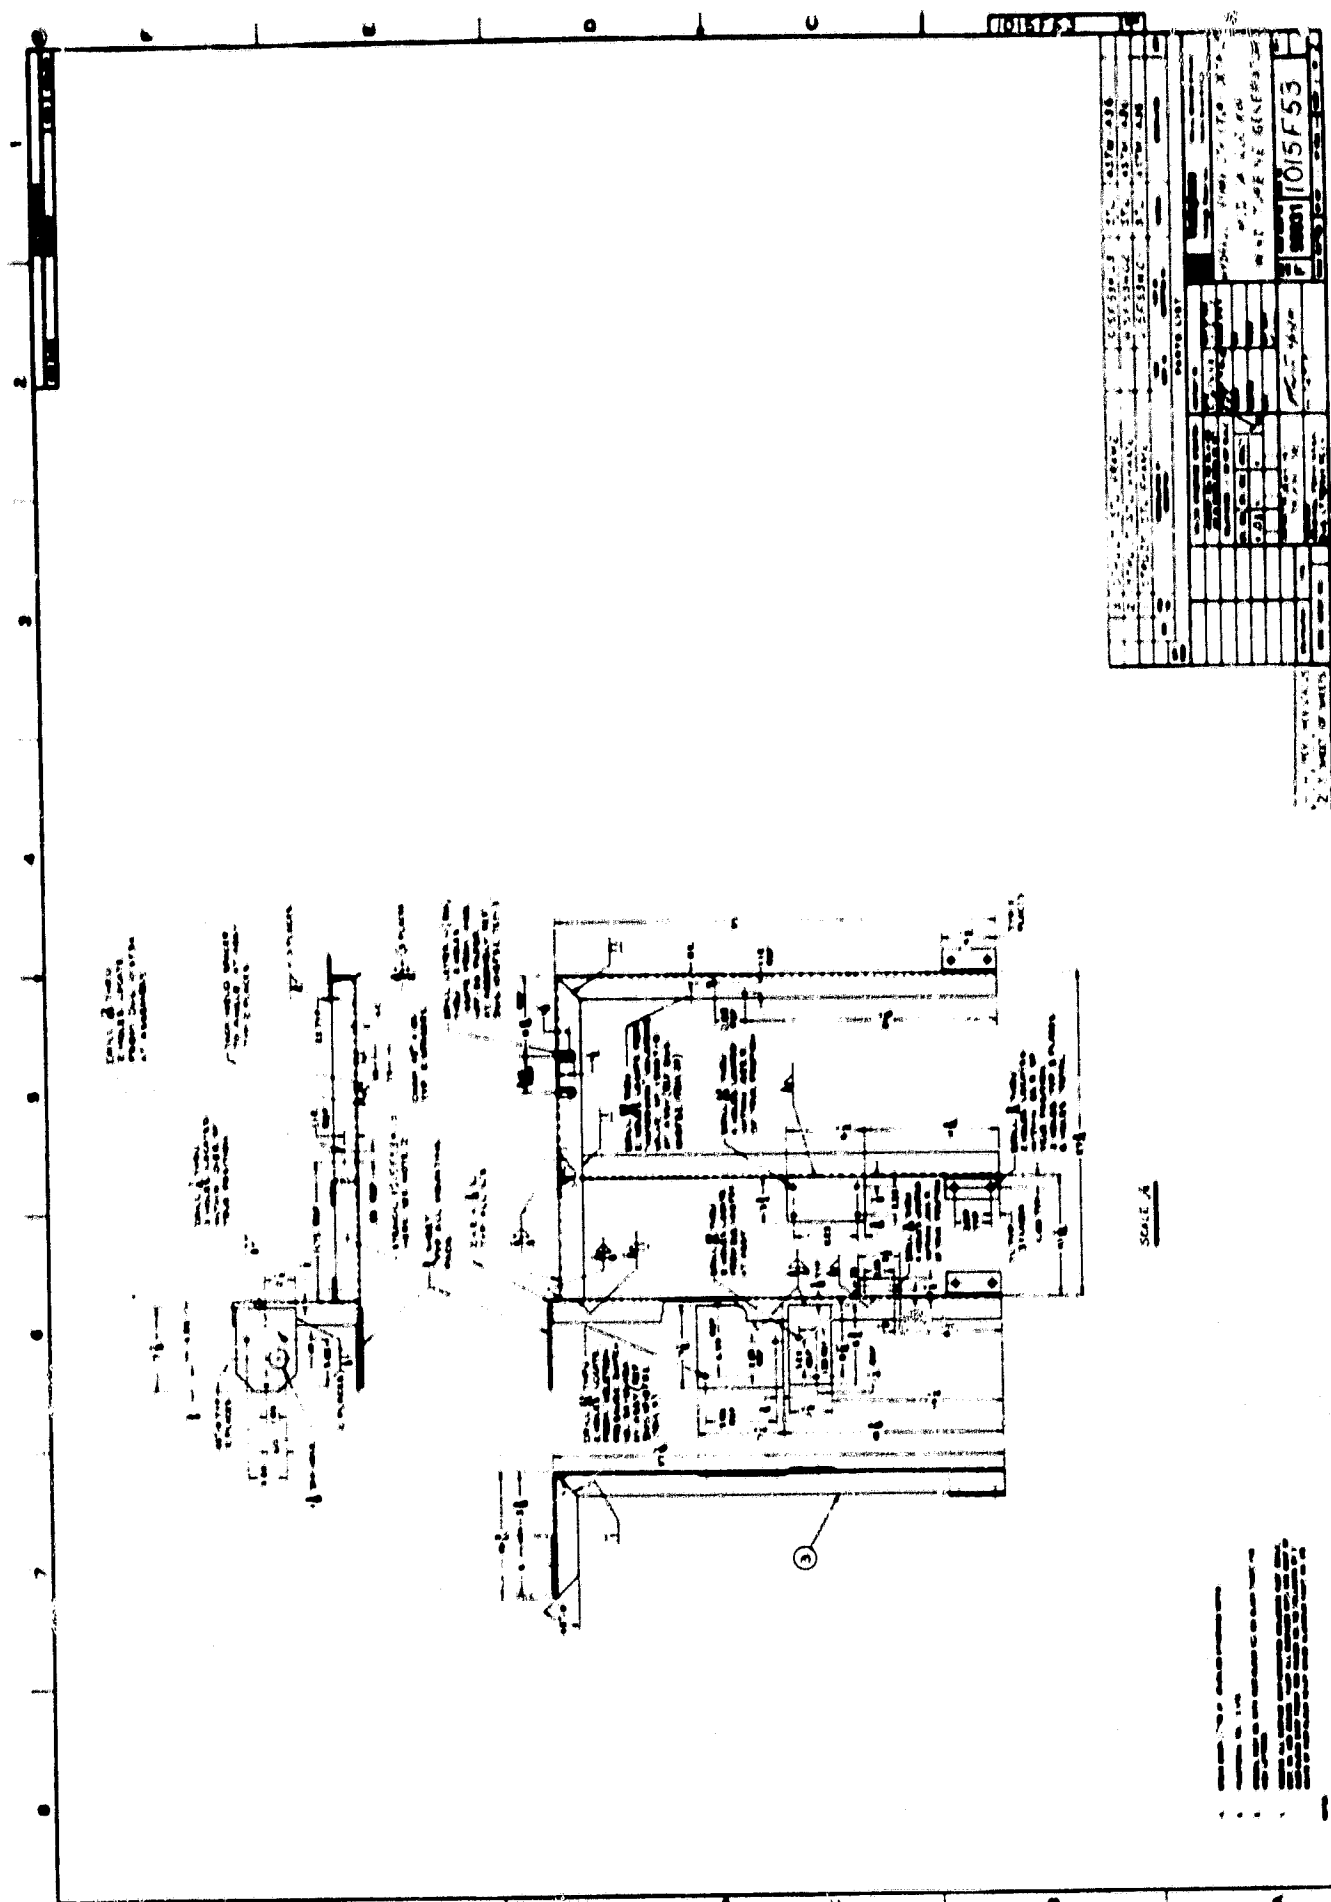

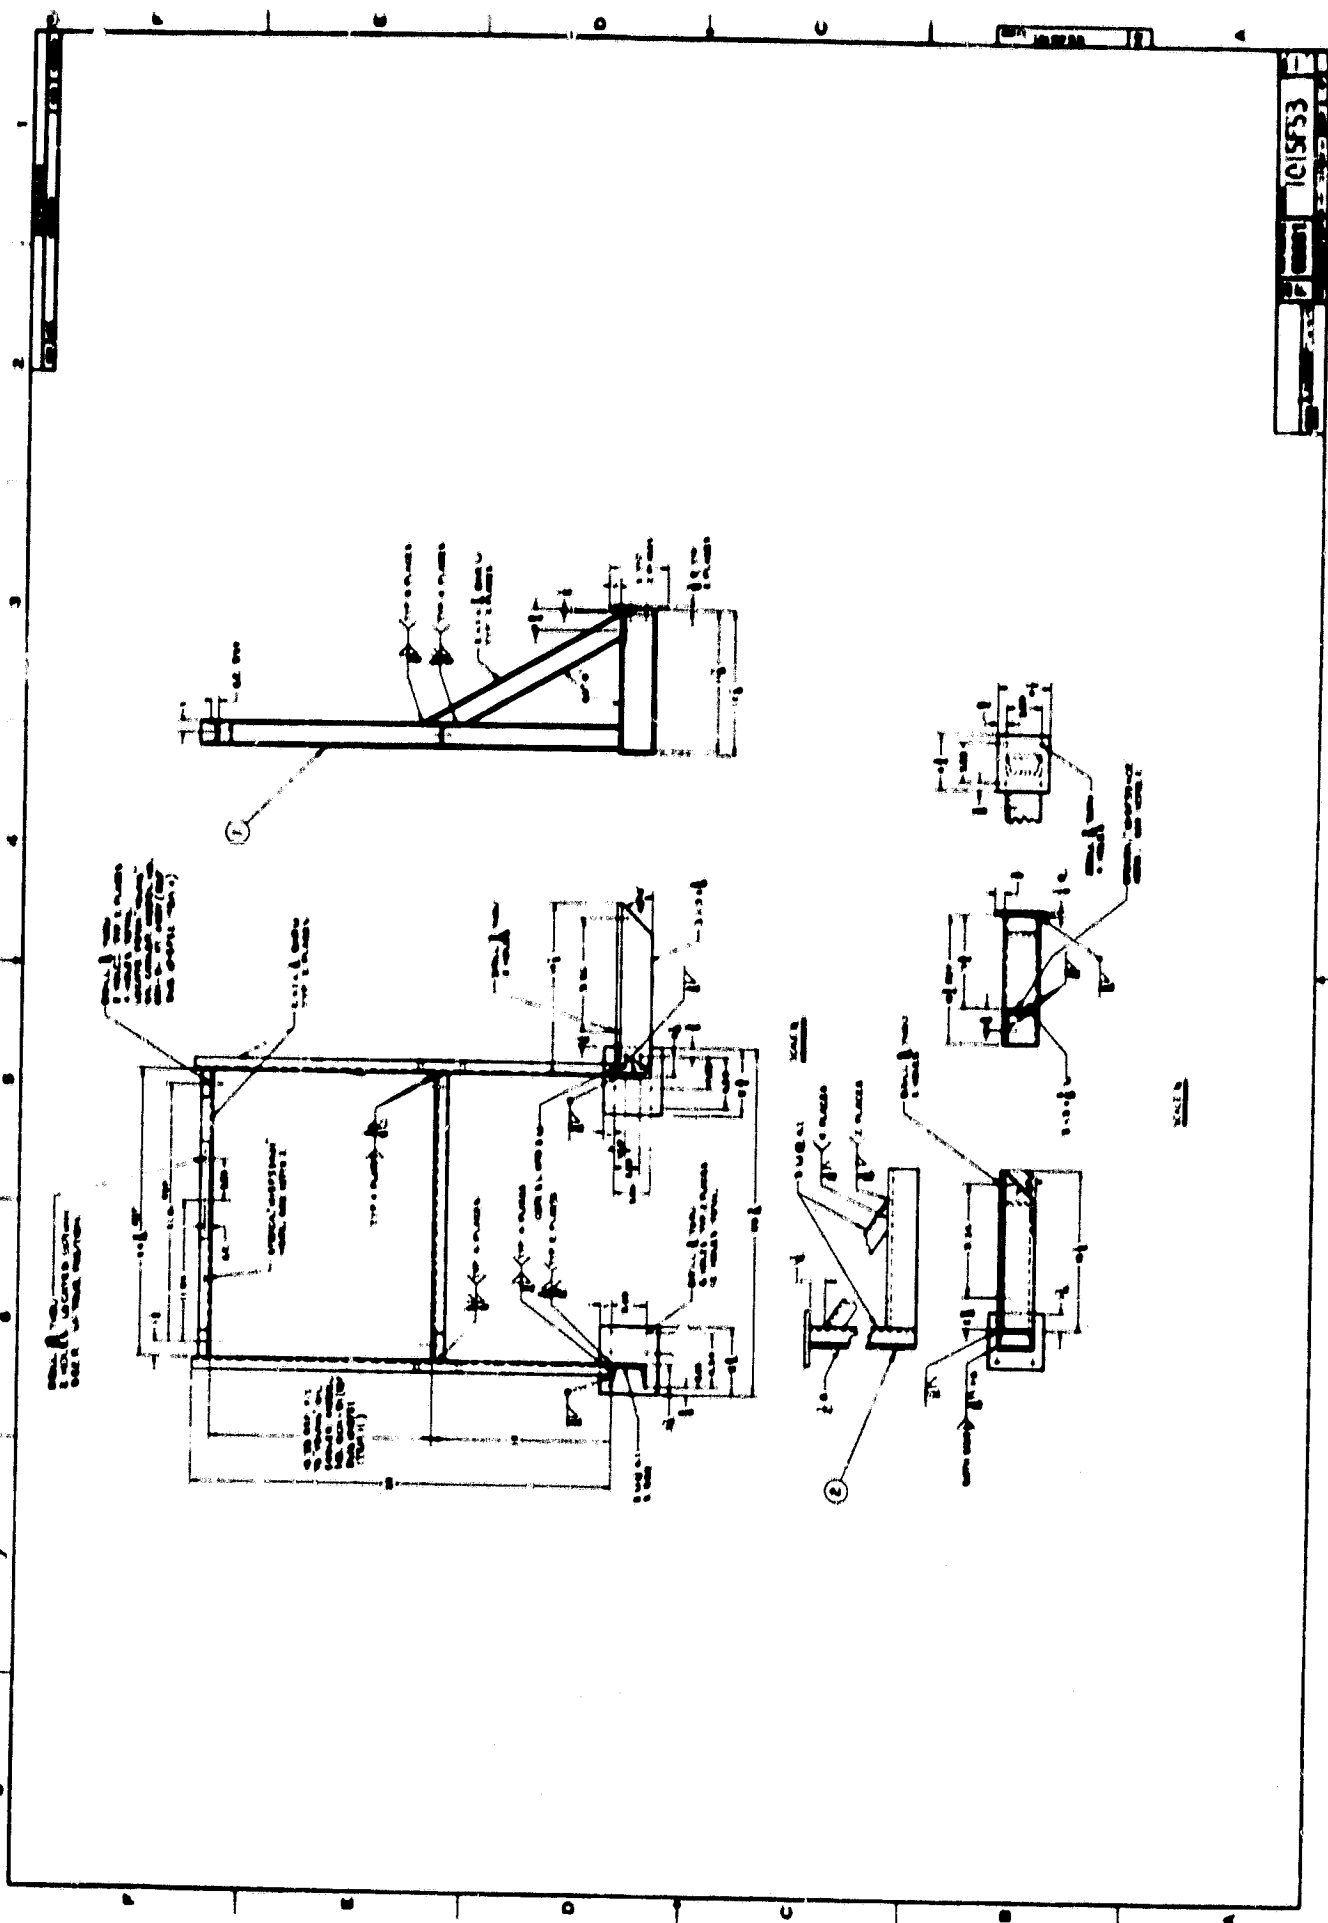


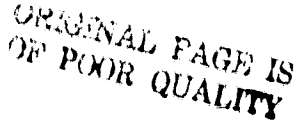
[illegible]



[illegible]

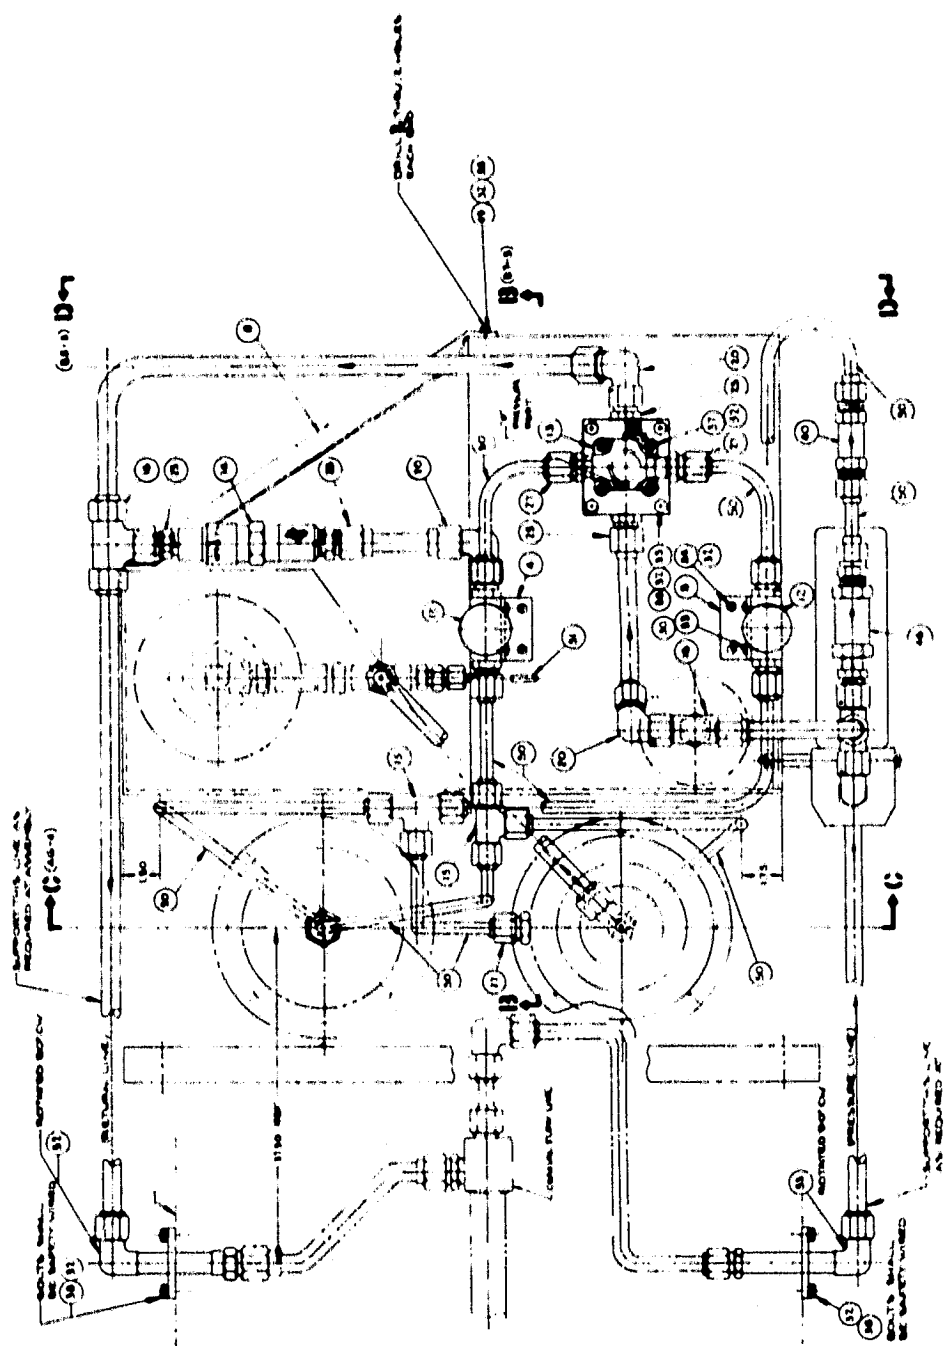

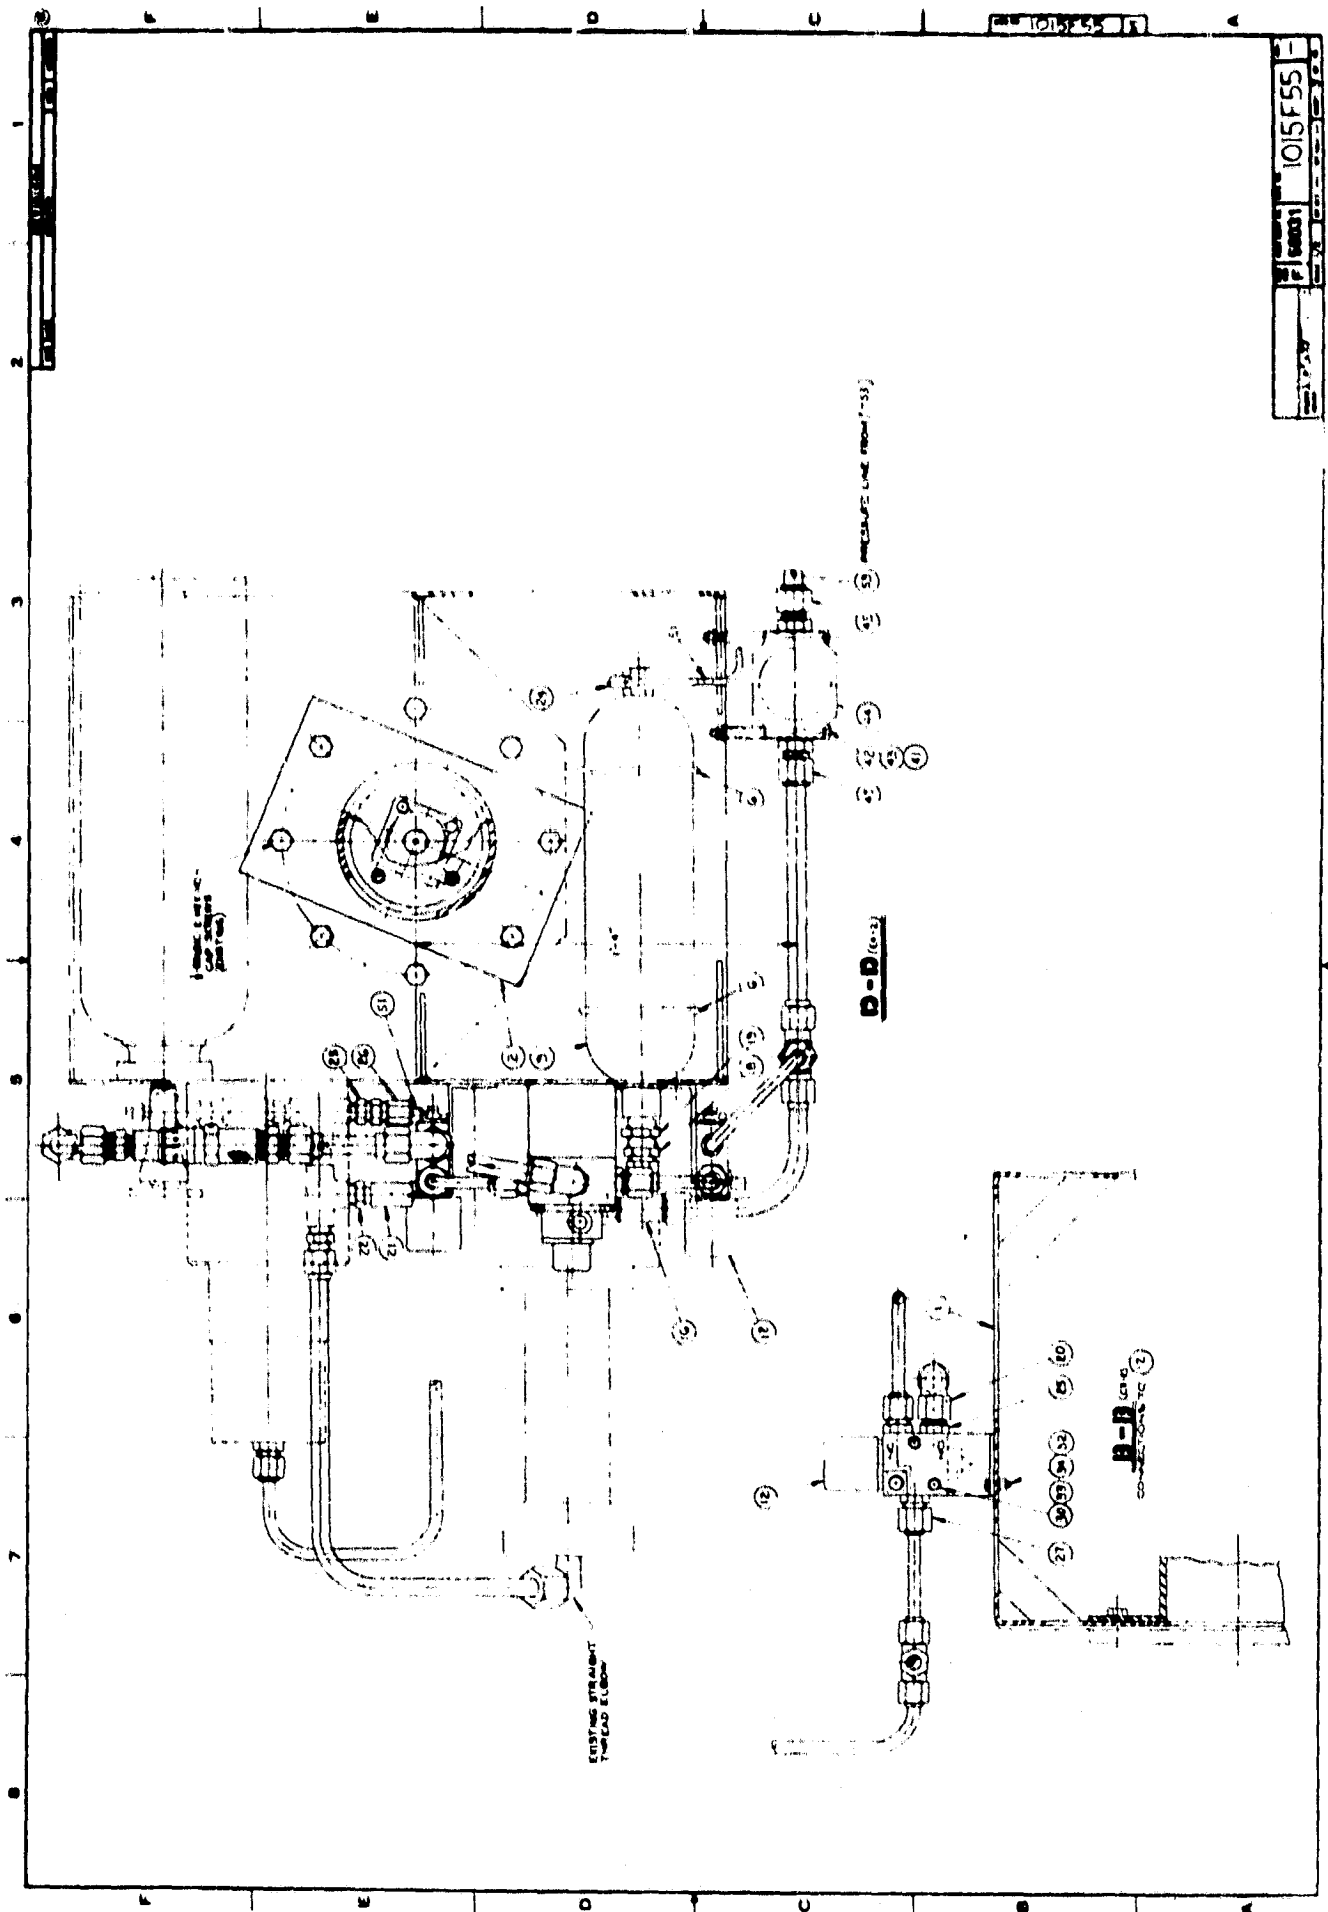

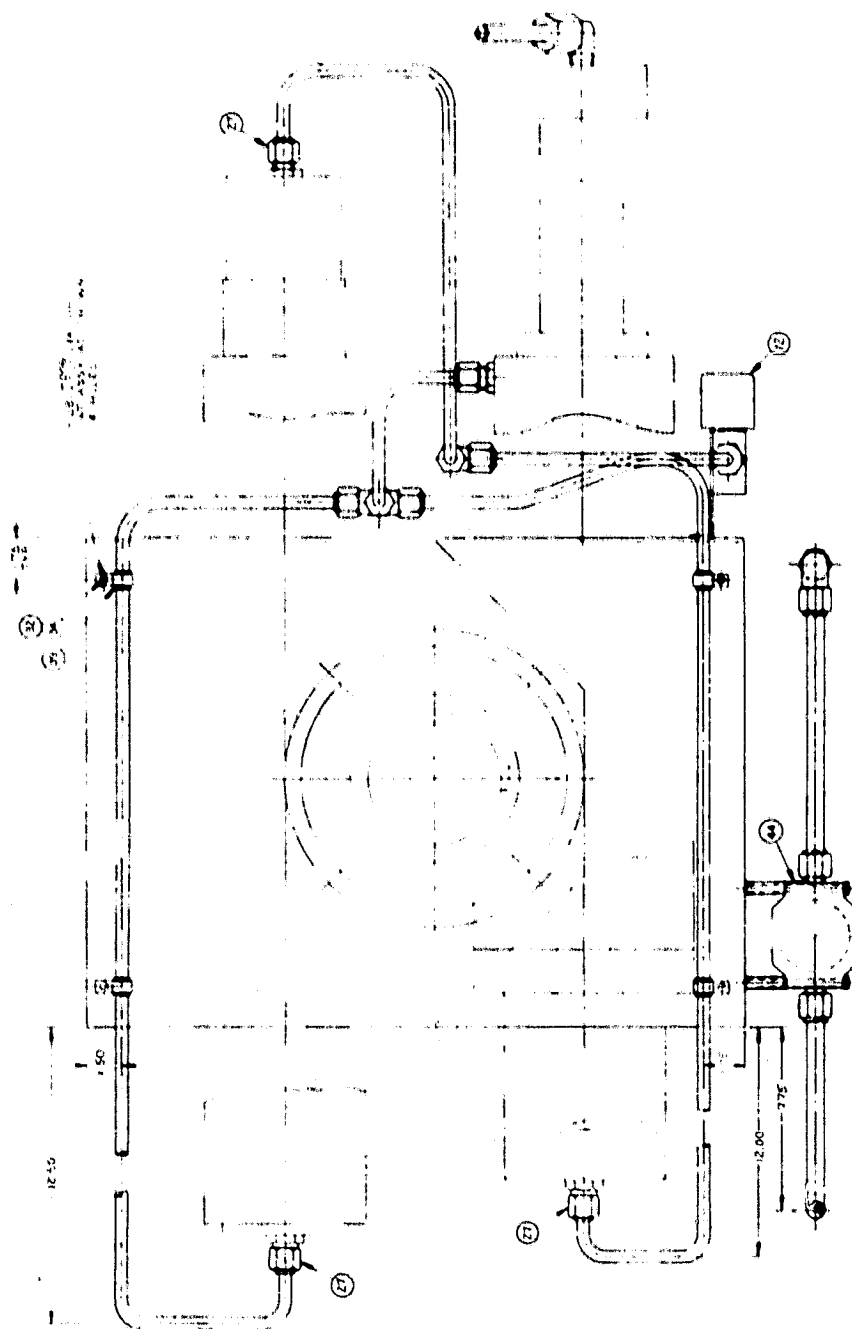


C-C

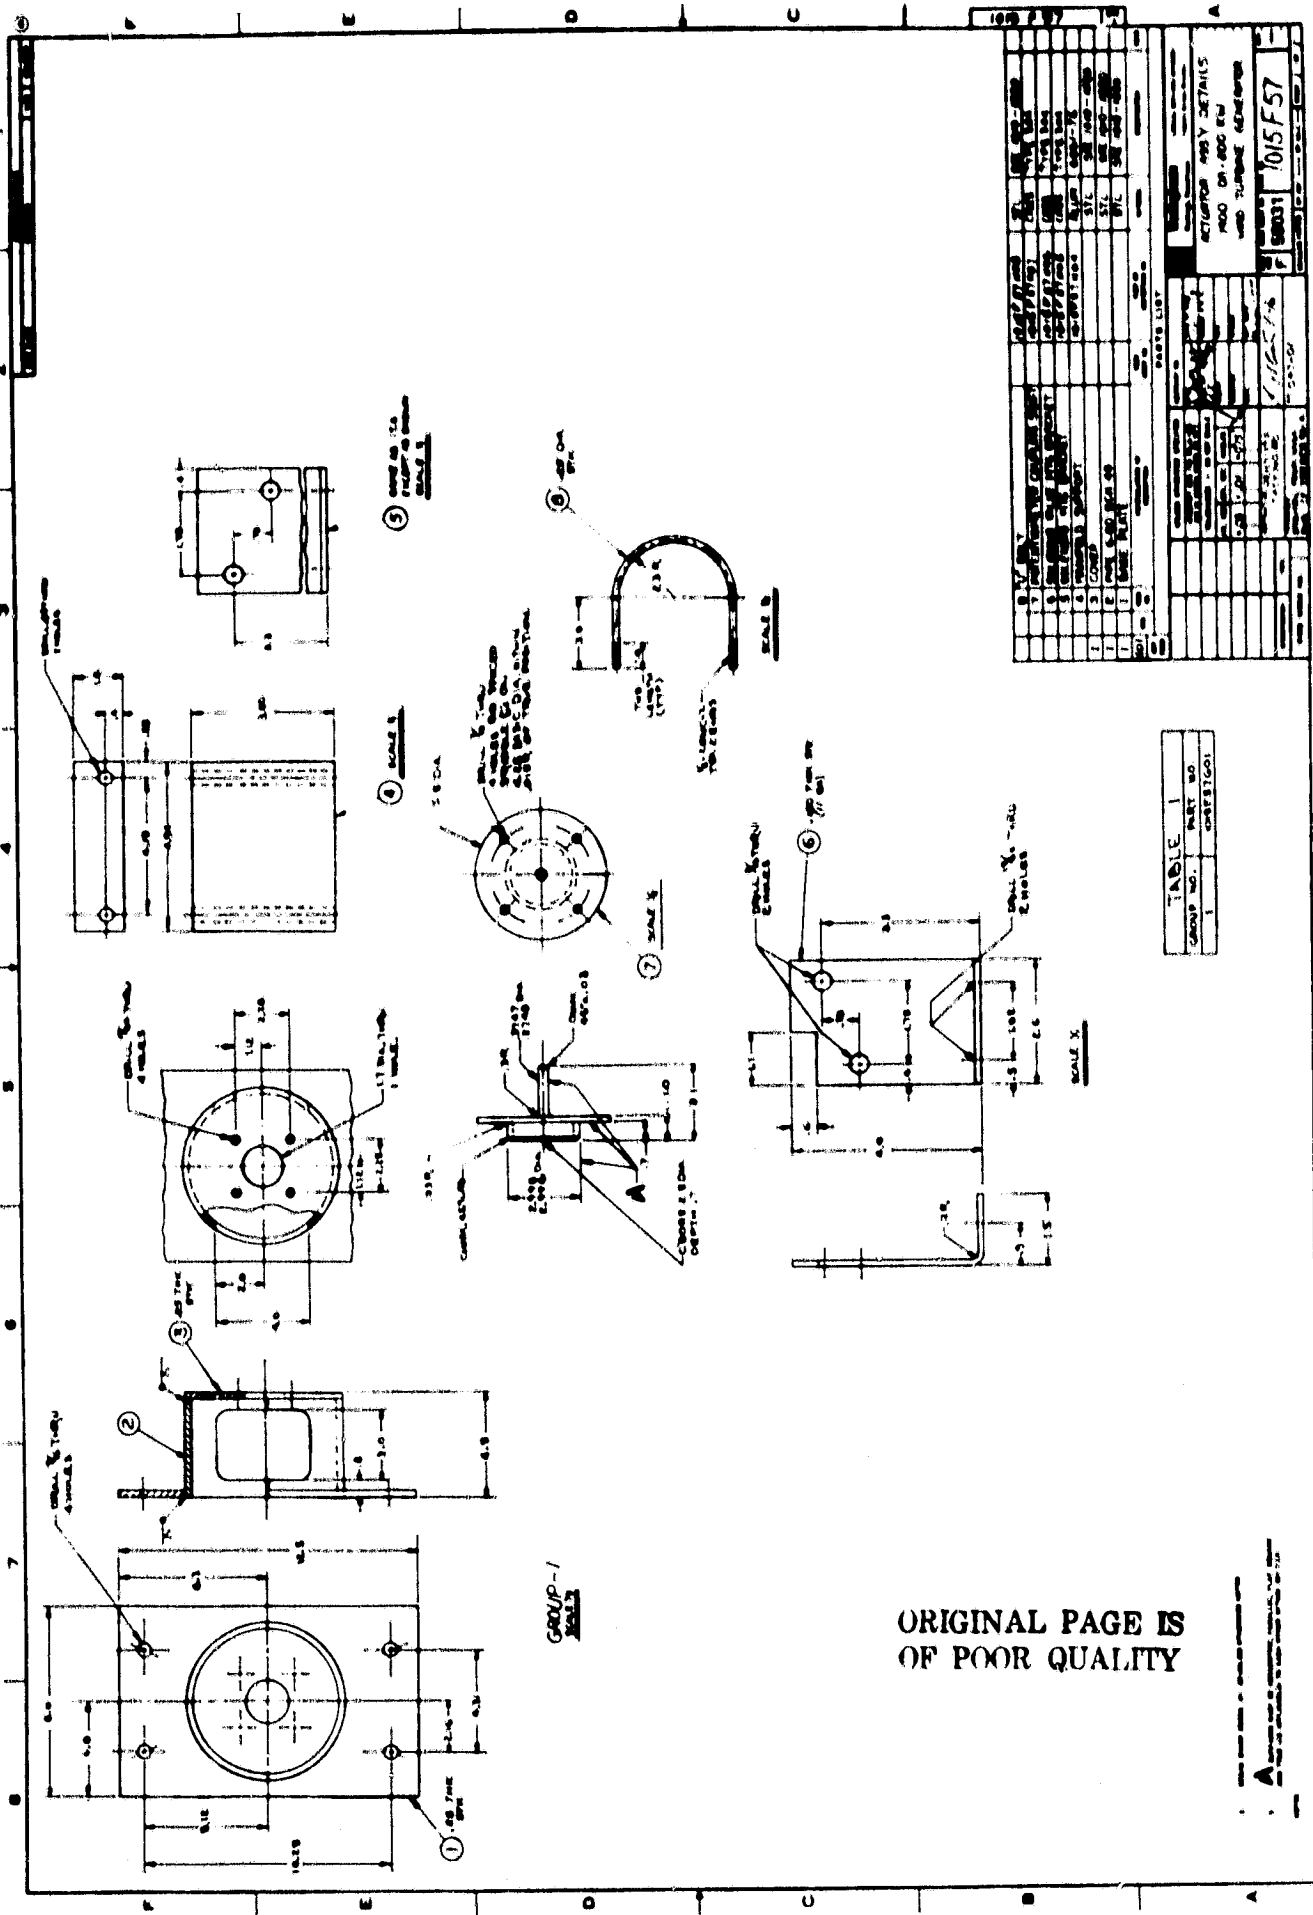



TABLE 1	
GROUP NO.	PART NO.
1	1015F57

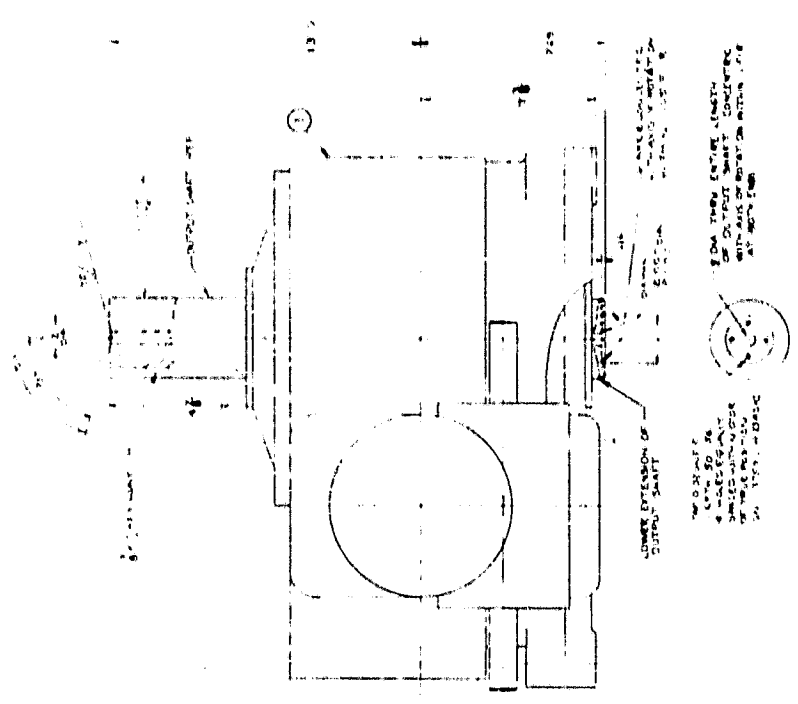



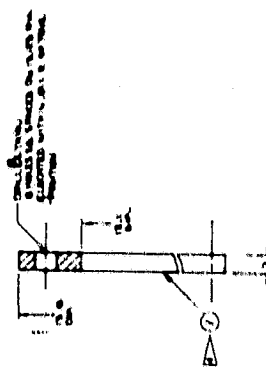
[illegible]

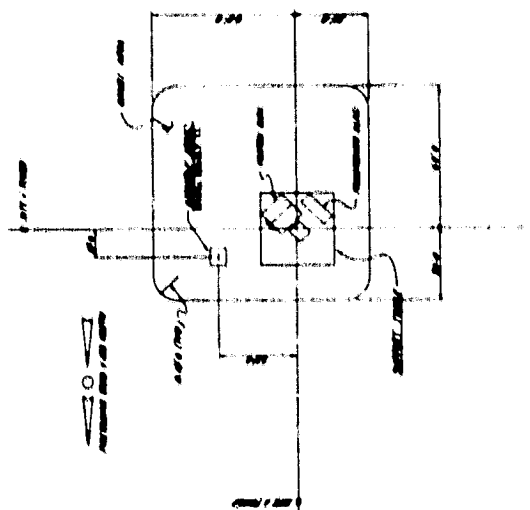



[illegible]




OL 35101

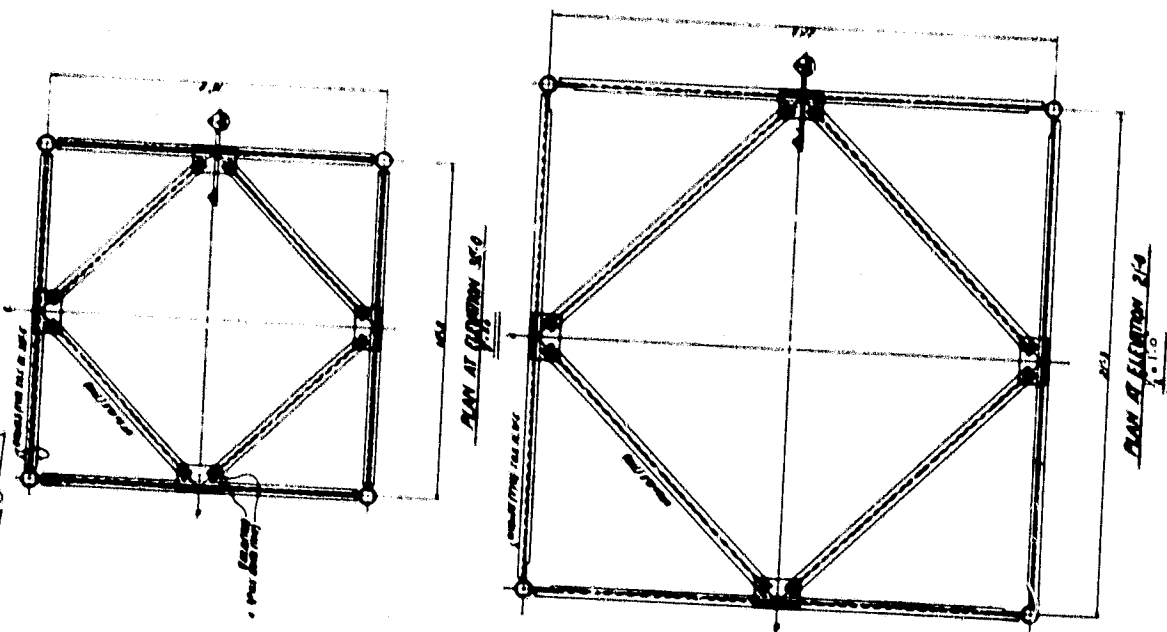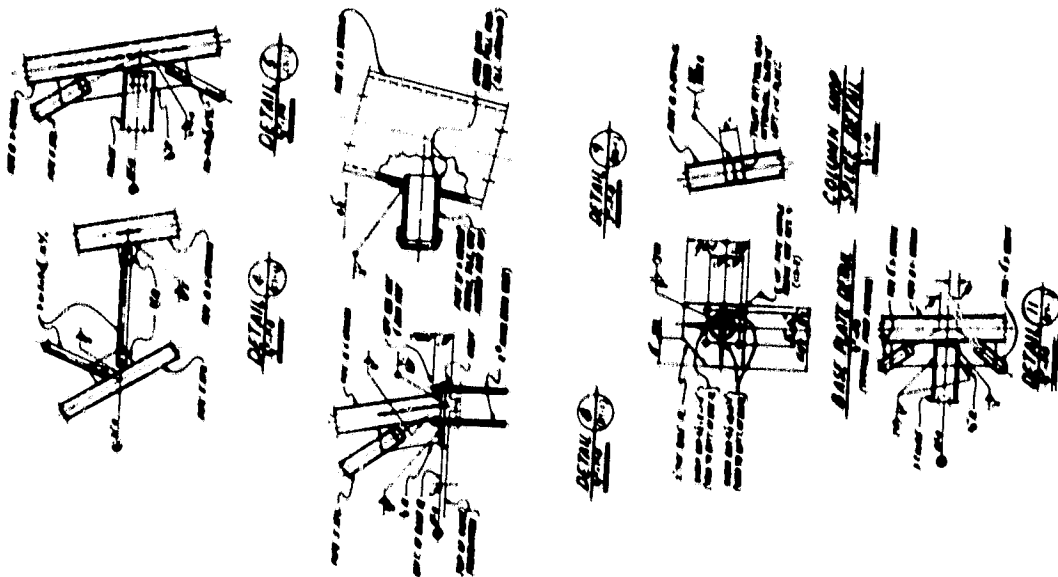


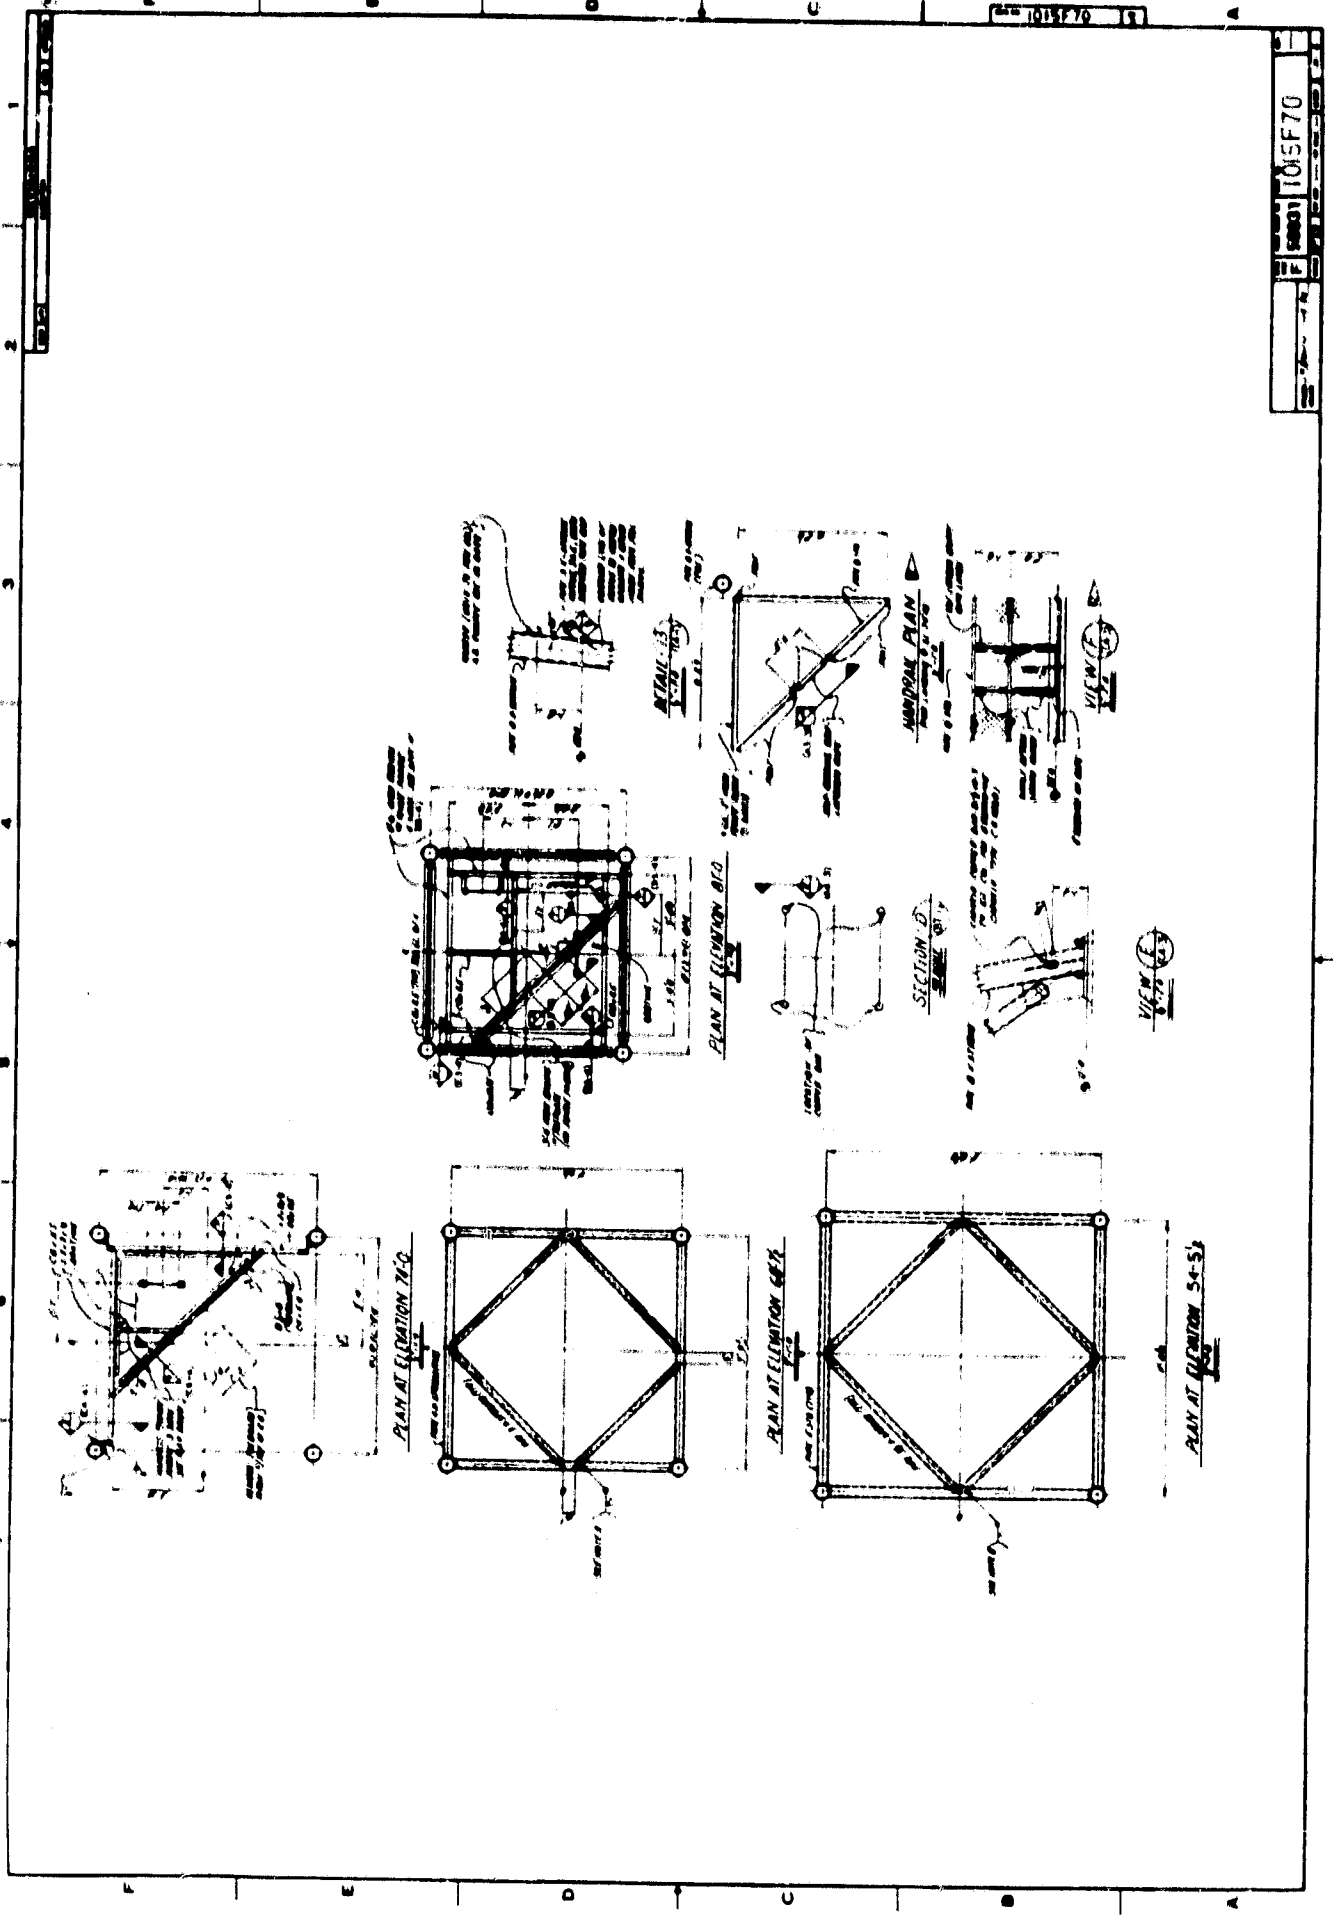


1015F70

1015F70

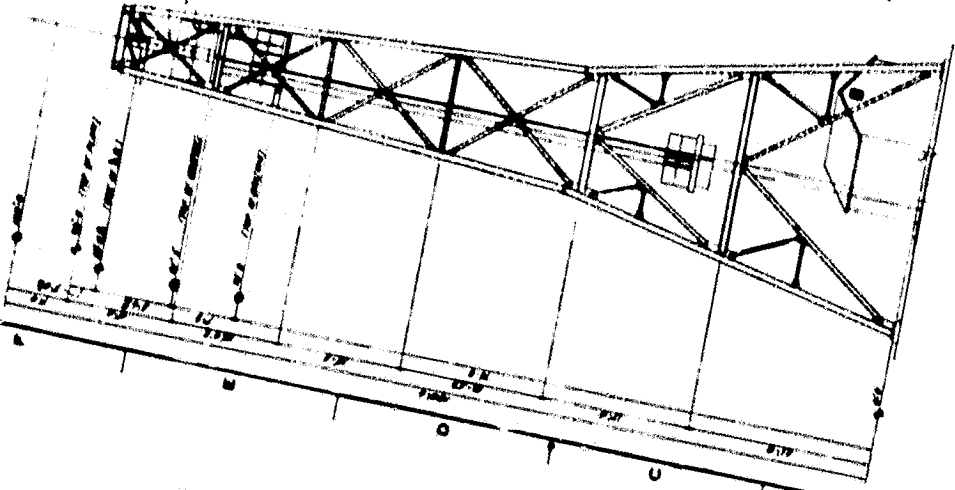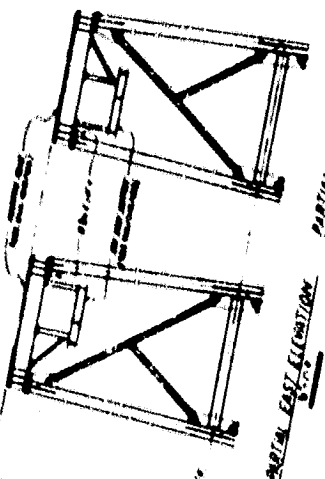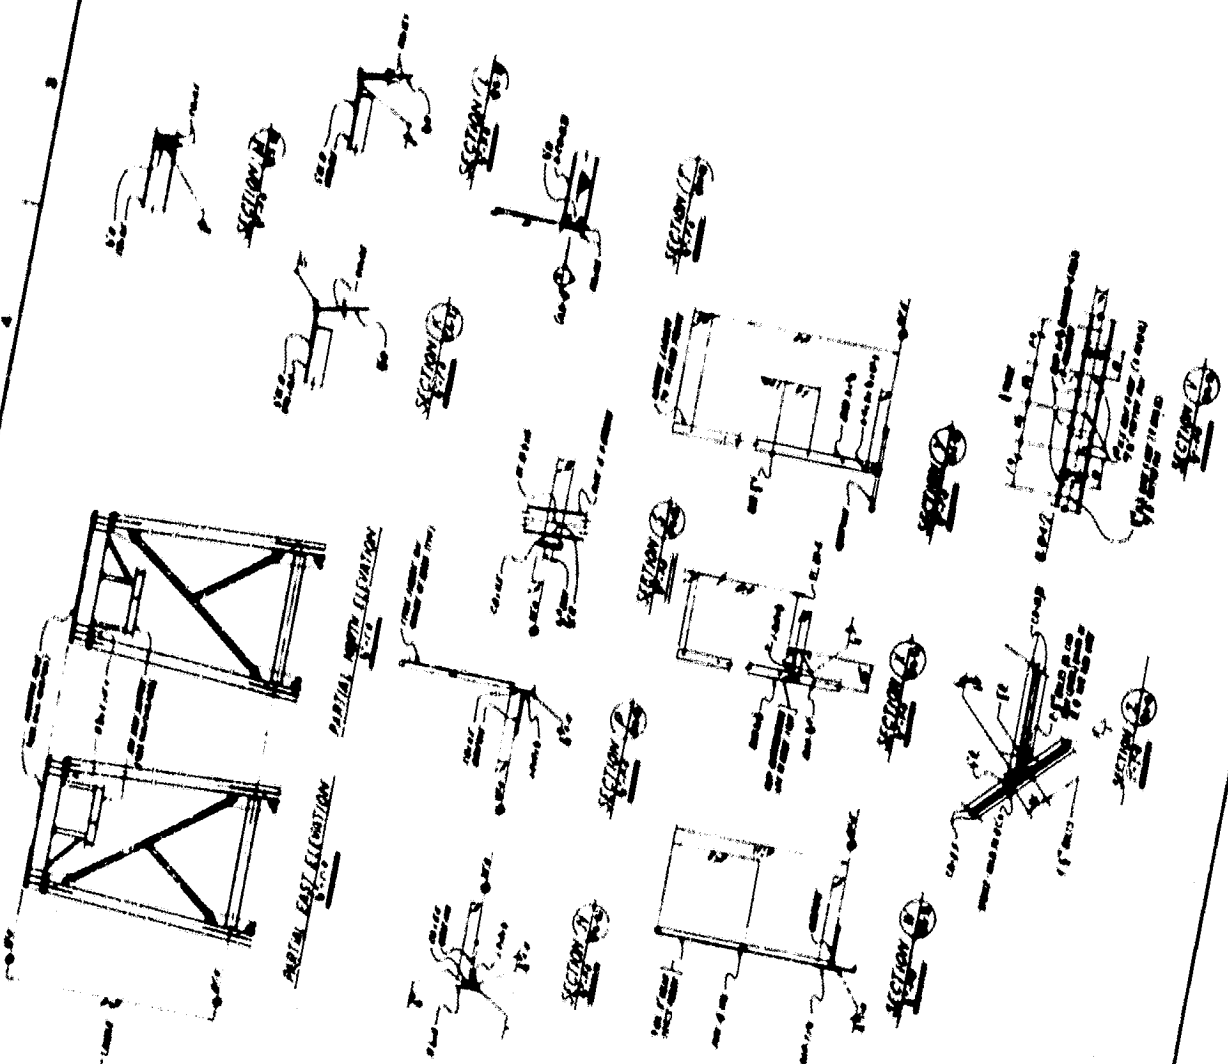

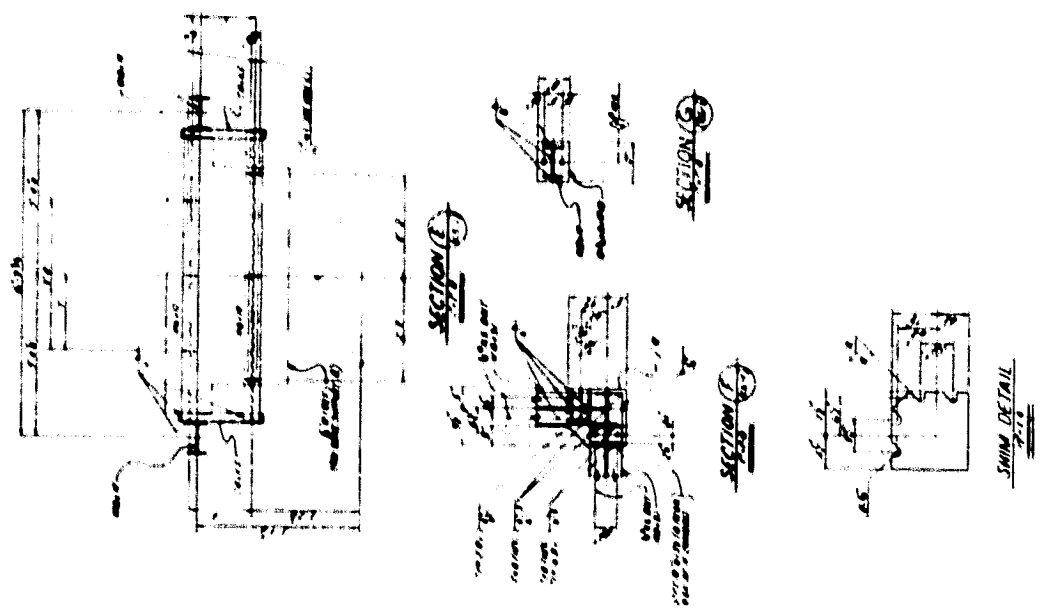


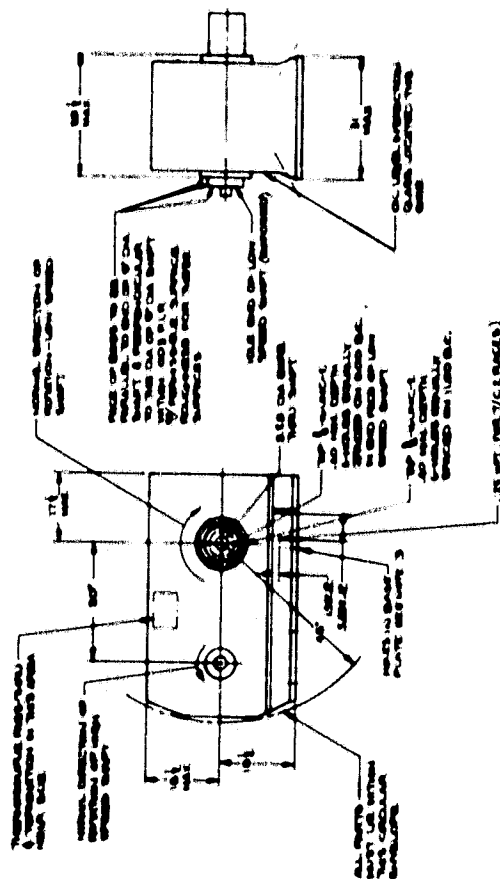

1	2	
1	2	3	4	5	6	7	8	9	10	11	12	13</	



1		2		
---	--	---	--	---	--	---	--	---	--	---	--	---	--	---	--	---	--	----	--	----	--	-----	--

 



200XN W/8 TYPING SUPPORT STRUCTURE
SCALE 1/4" = 1'-0"



DETAIL B
SCALE 1/4" = 1'-0"

ORIGINAL PAGE IS
OF POOR QUALITY

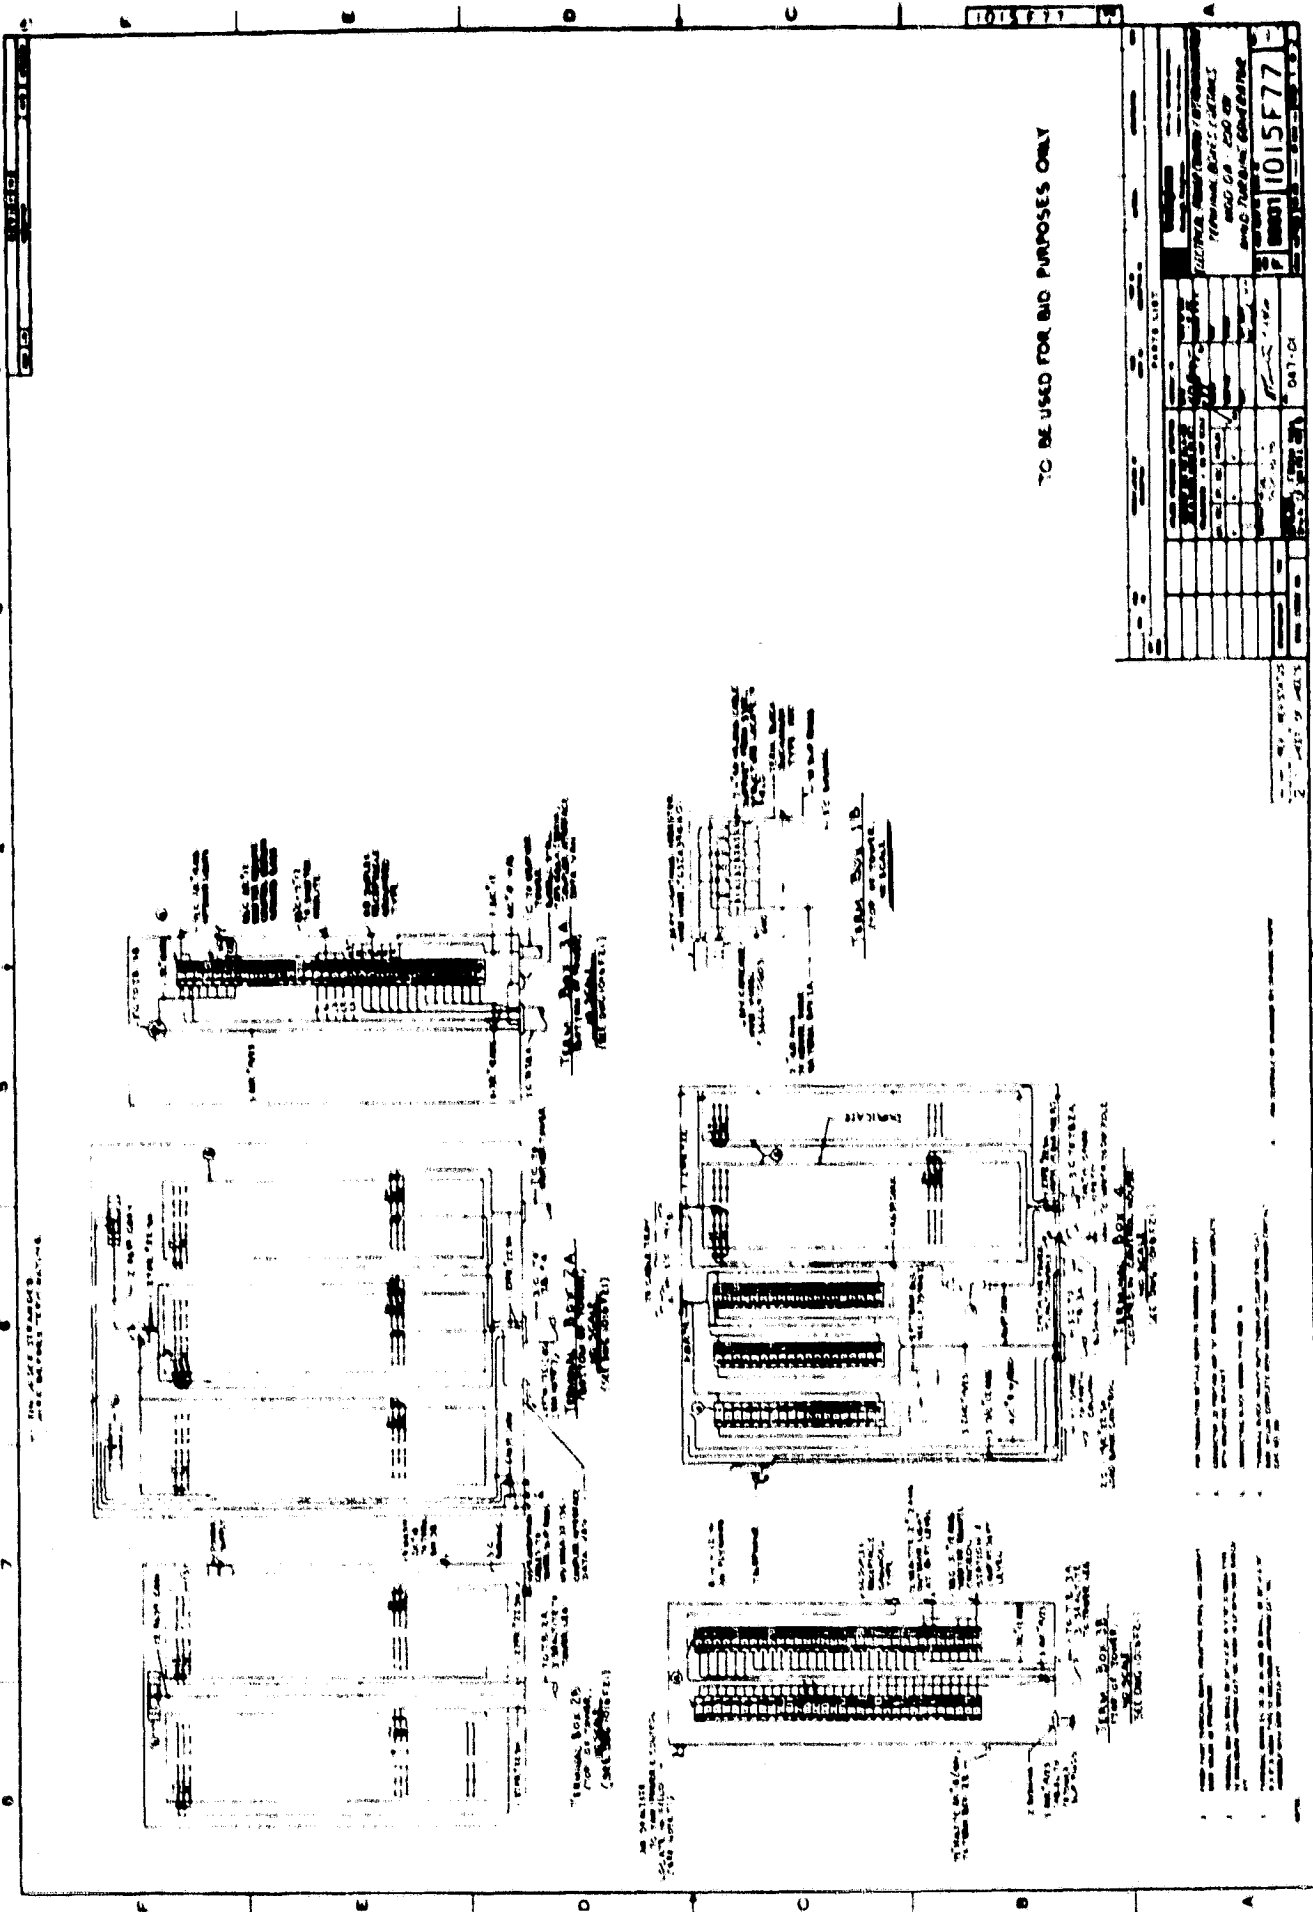[illegible]

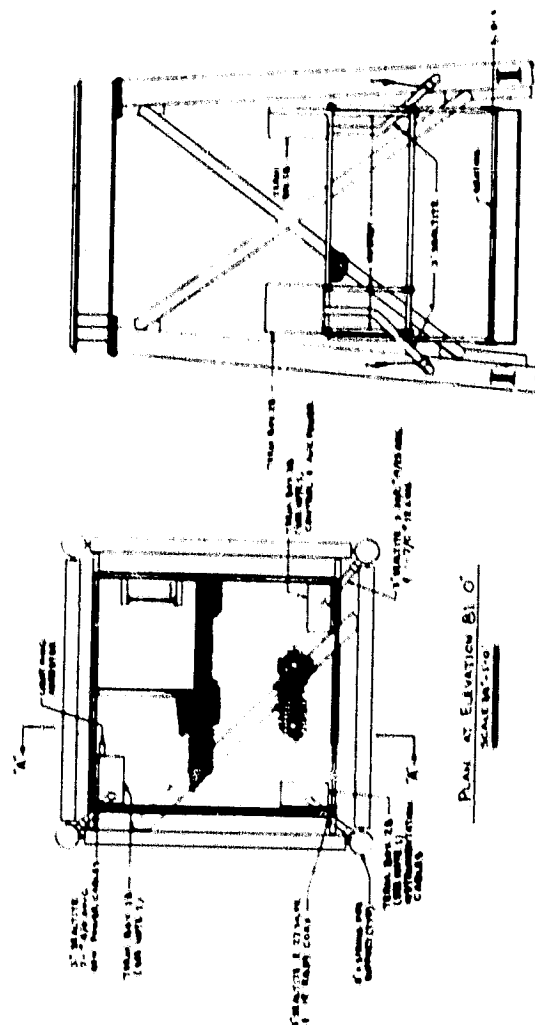



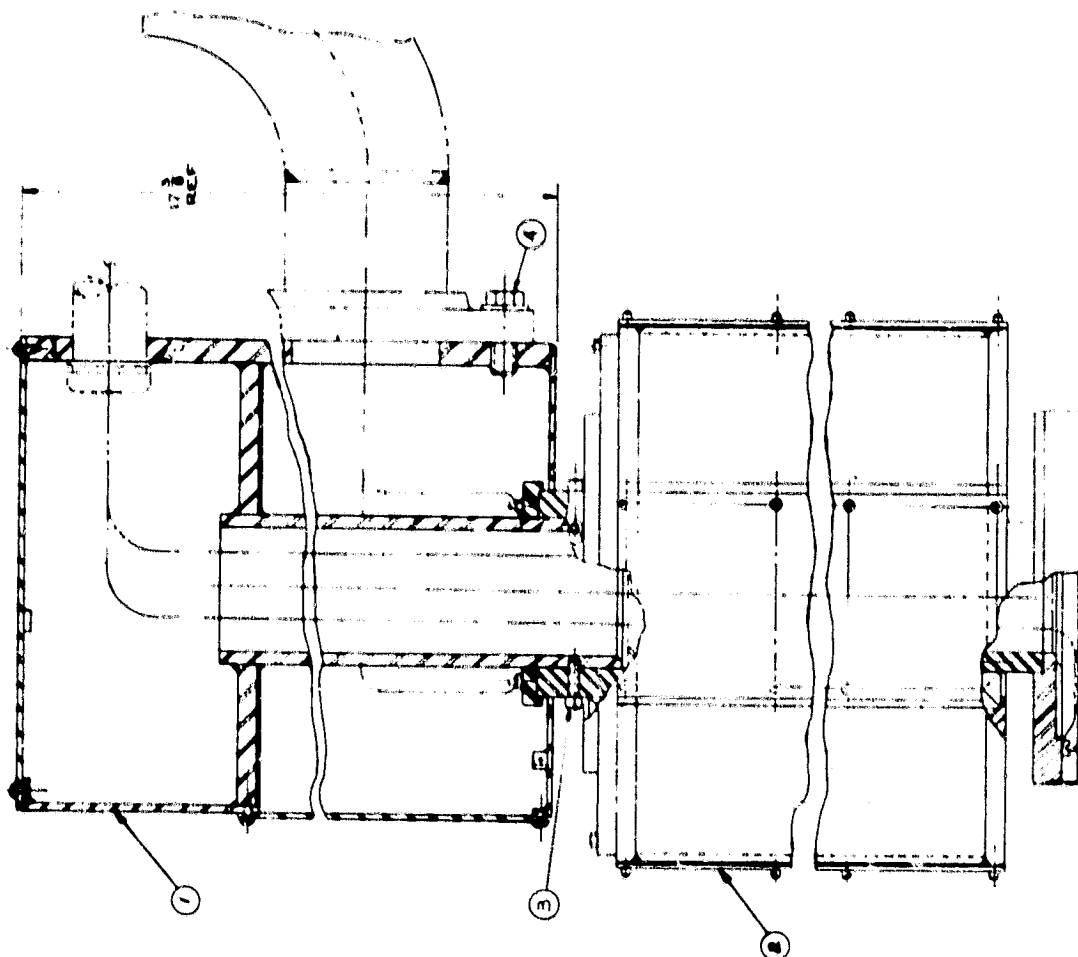






MATERIALS LIST		PARTS LIST	




TABLE 1	1
ON TYPED	AS DONE
REPORTS	

[illegible]

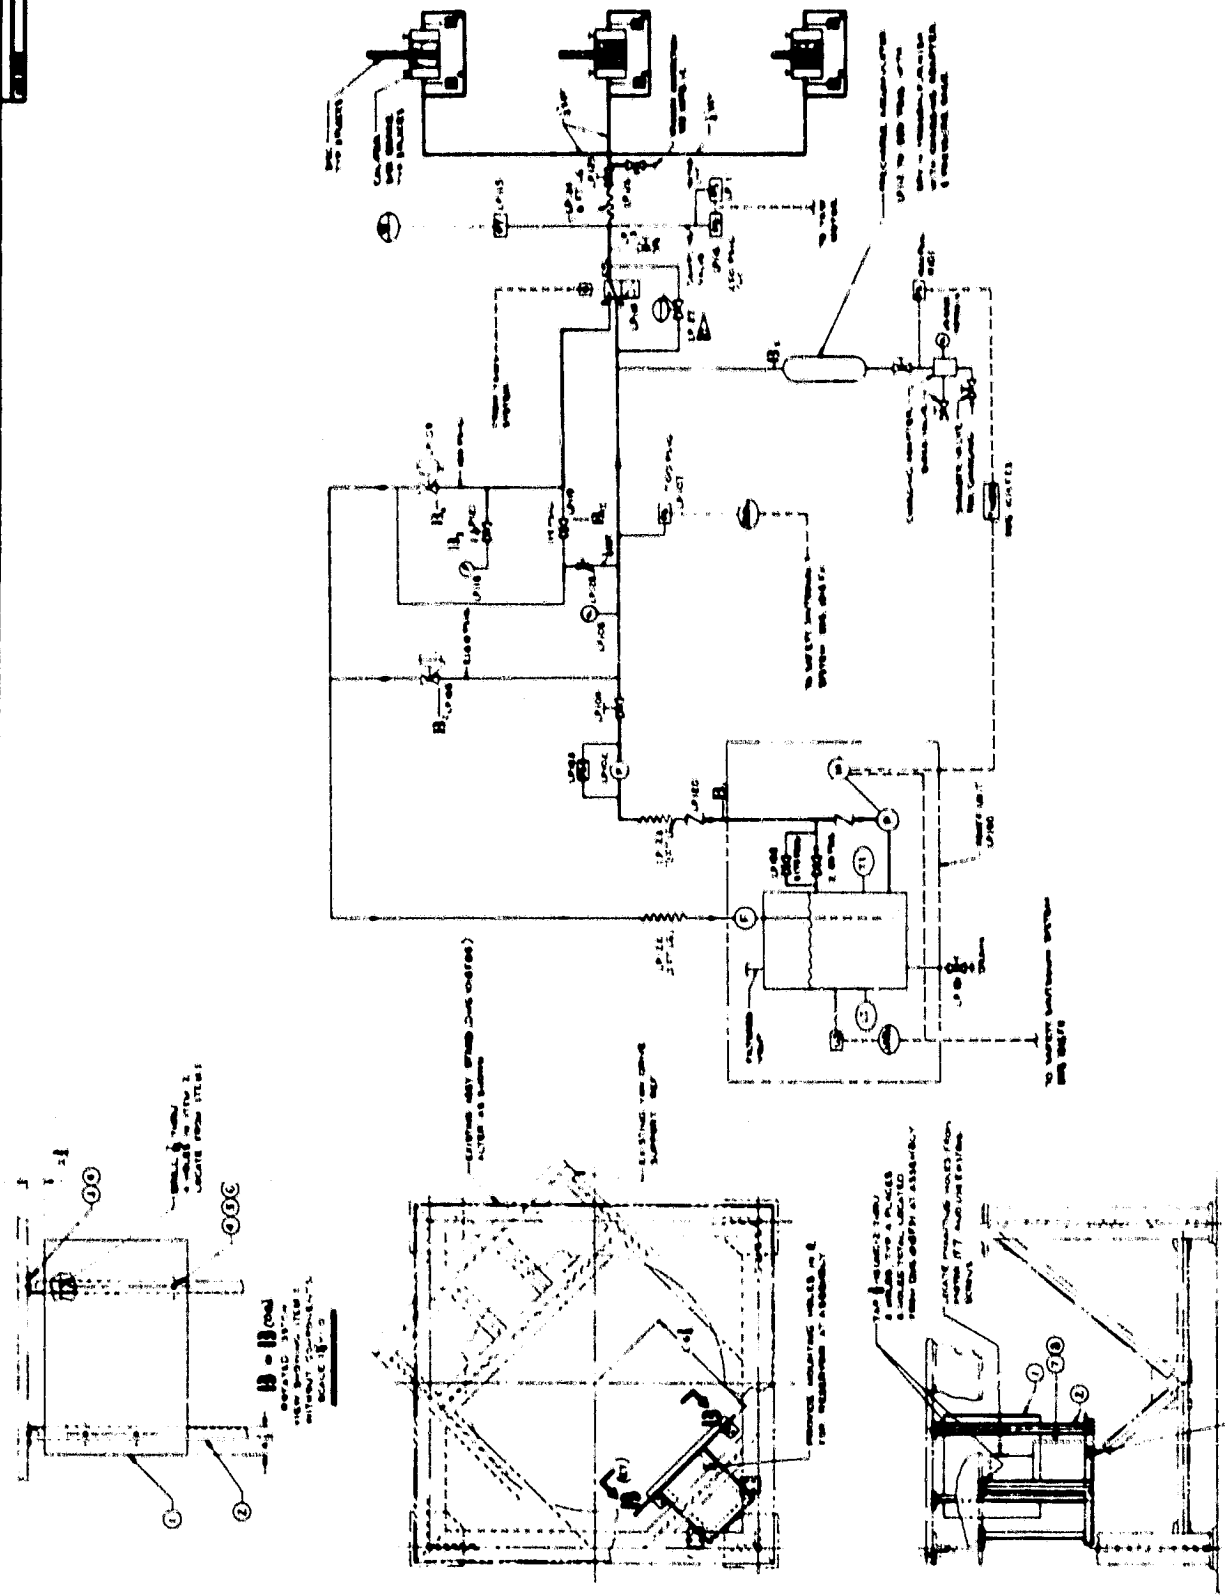


RECEIVED
JAN 10 1964

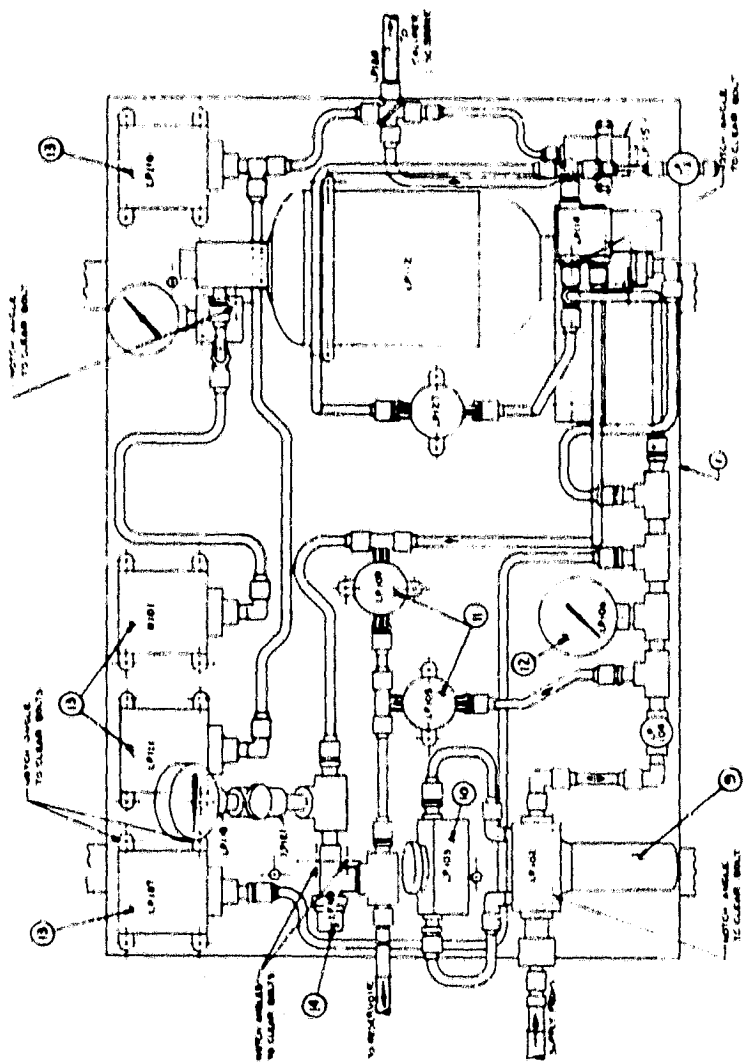


PANEL ASSEMBLY
SCALE 1/8"

1 2 3 4 5 6 7 8

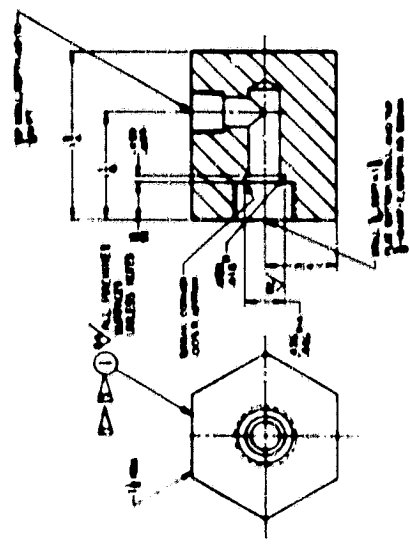

SCALE 1/2"

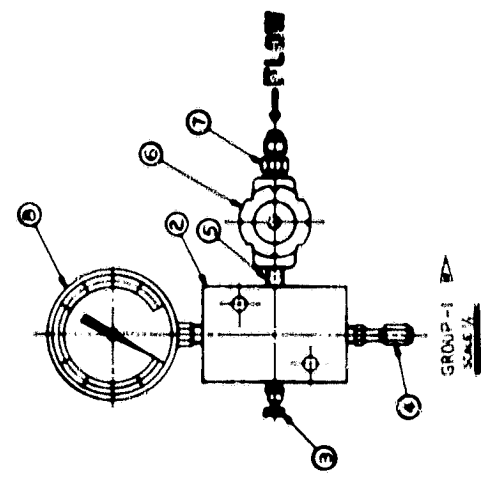


GROUP-1
SCALE 1/2"




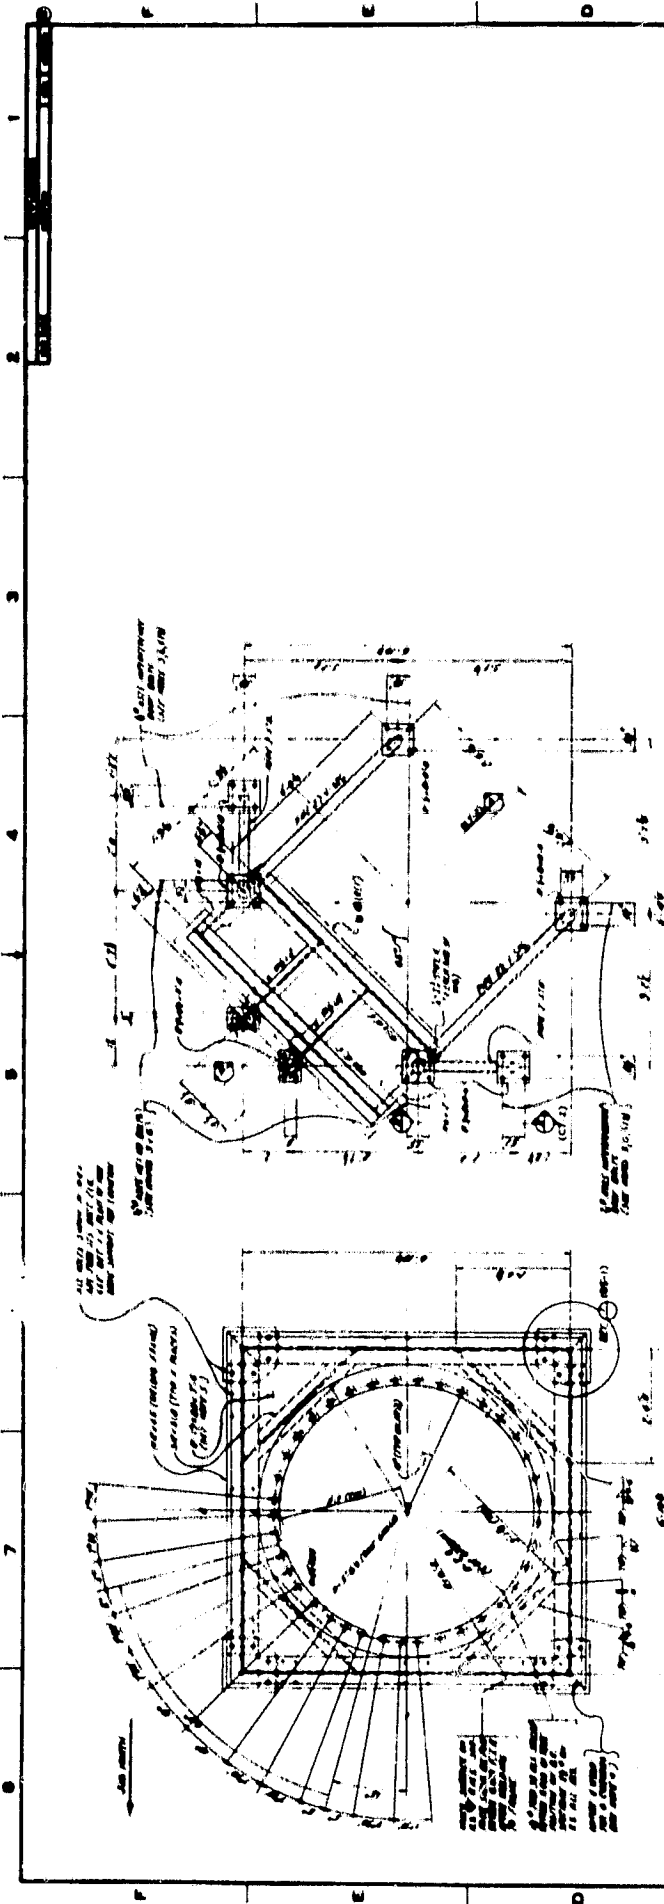

PLAN OF THE DRIVE SUPPORT
 1/2" = 1'-0"

PLAN OF MOUNTING FRAME
 1/2" = 1'-0"



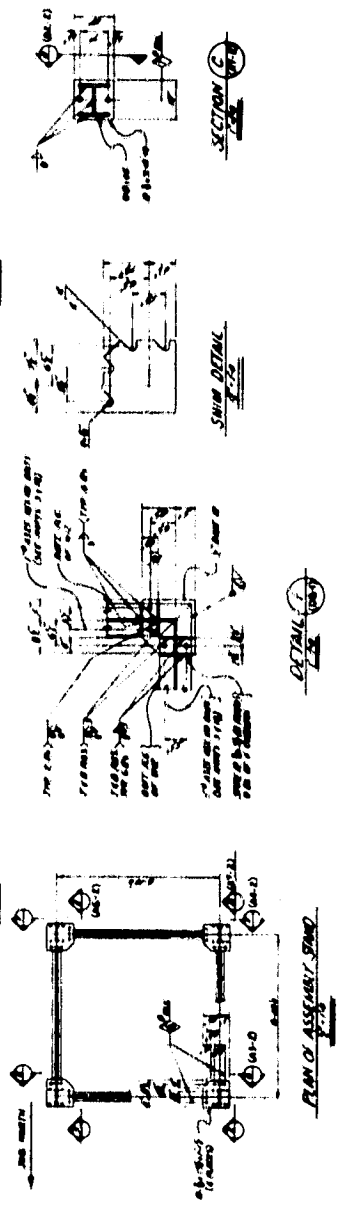





58 J5101 1000

1015F85

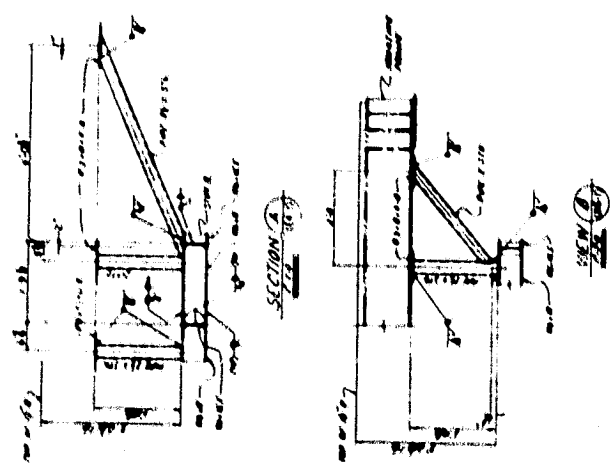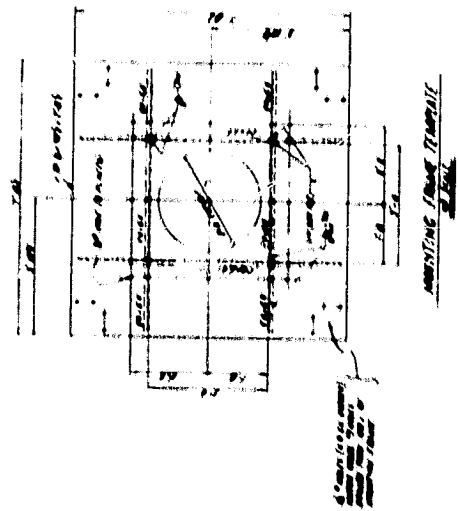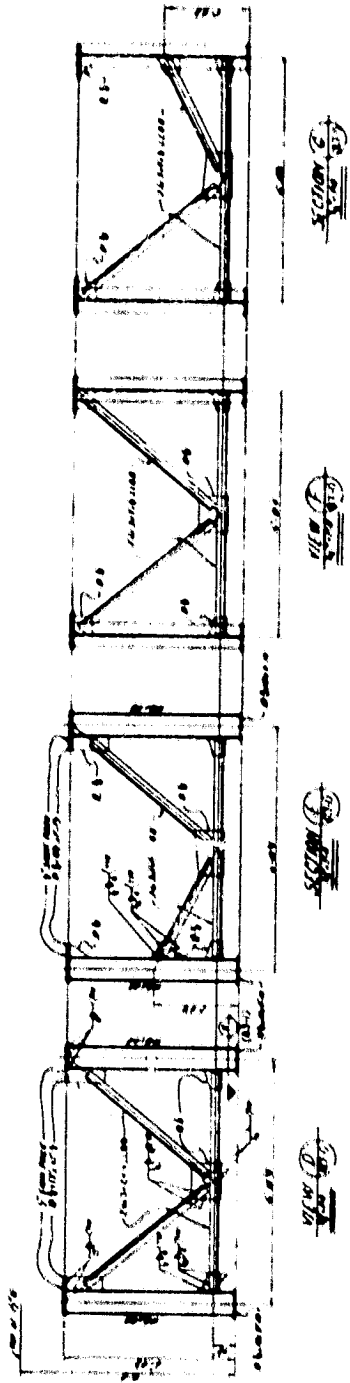


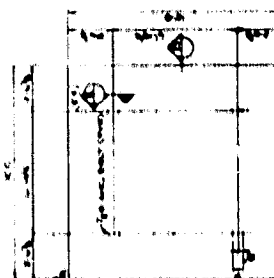

SECTION 54

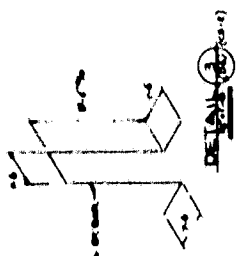


18-52-2003

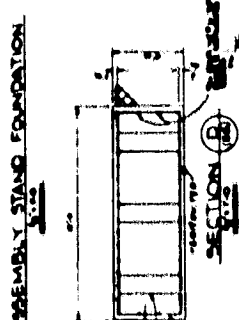



⑤



DEAL 4
(547) (6-6-8)

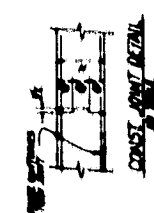


14730 JUNE 15 1960

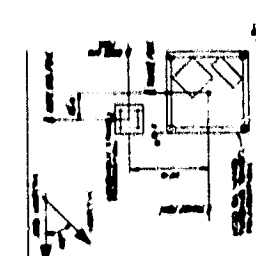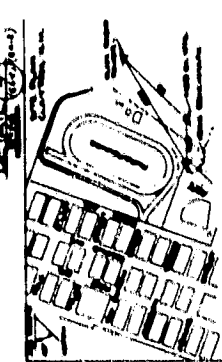

~~CONFIDENTIAL~~

[illegible]

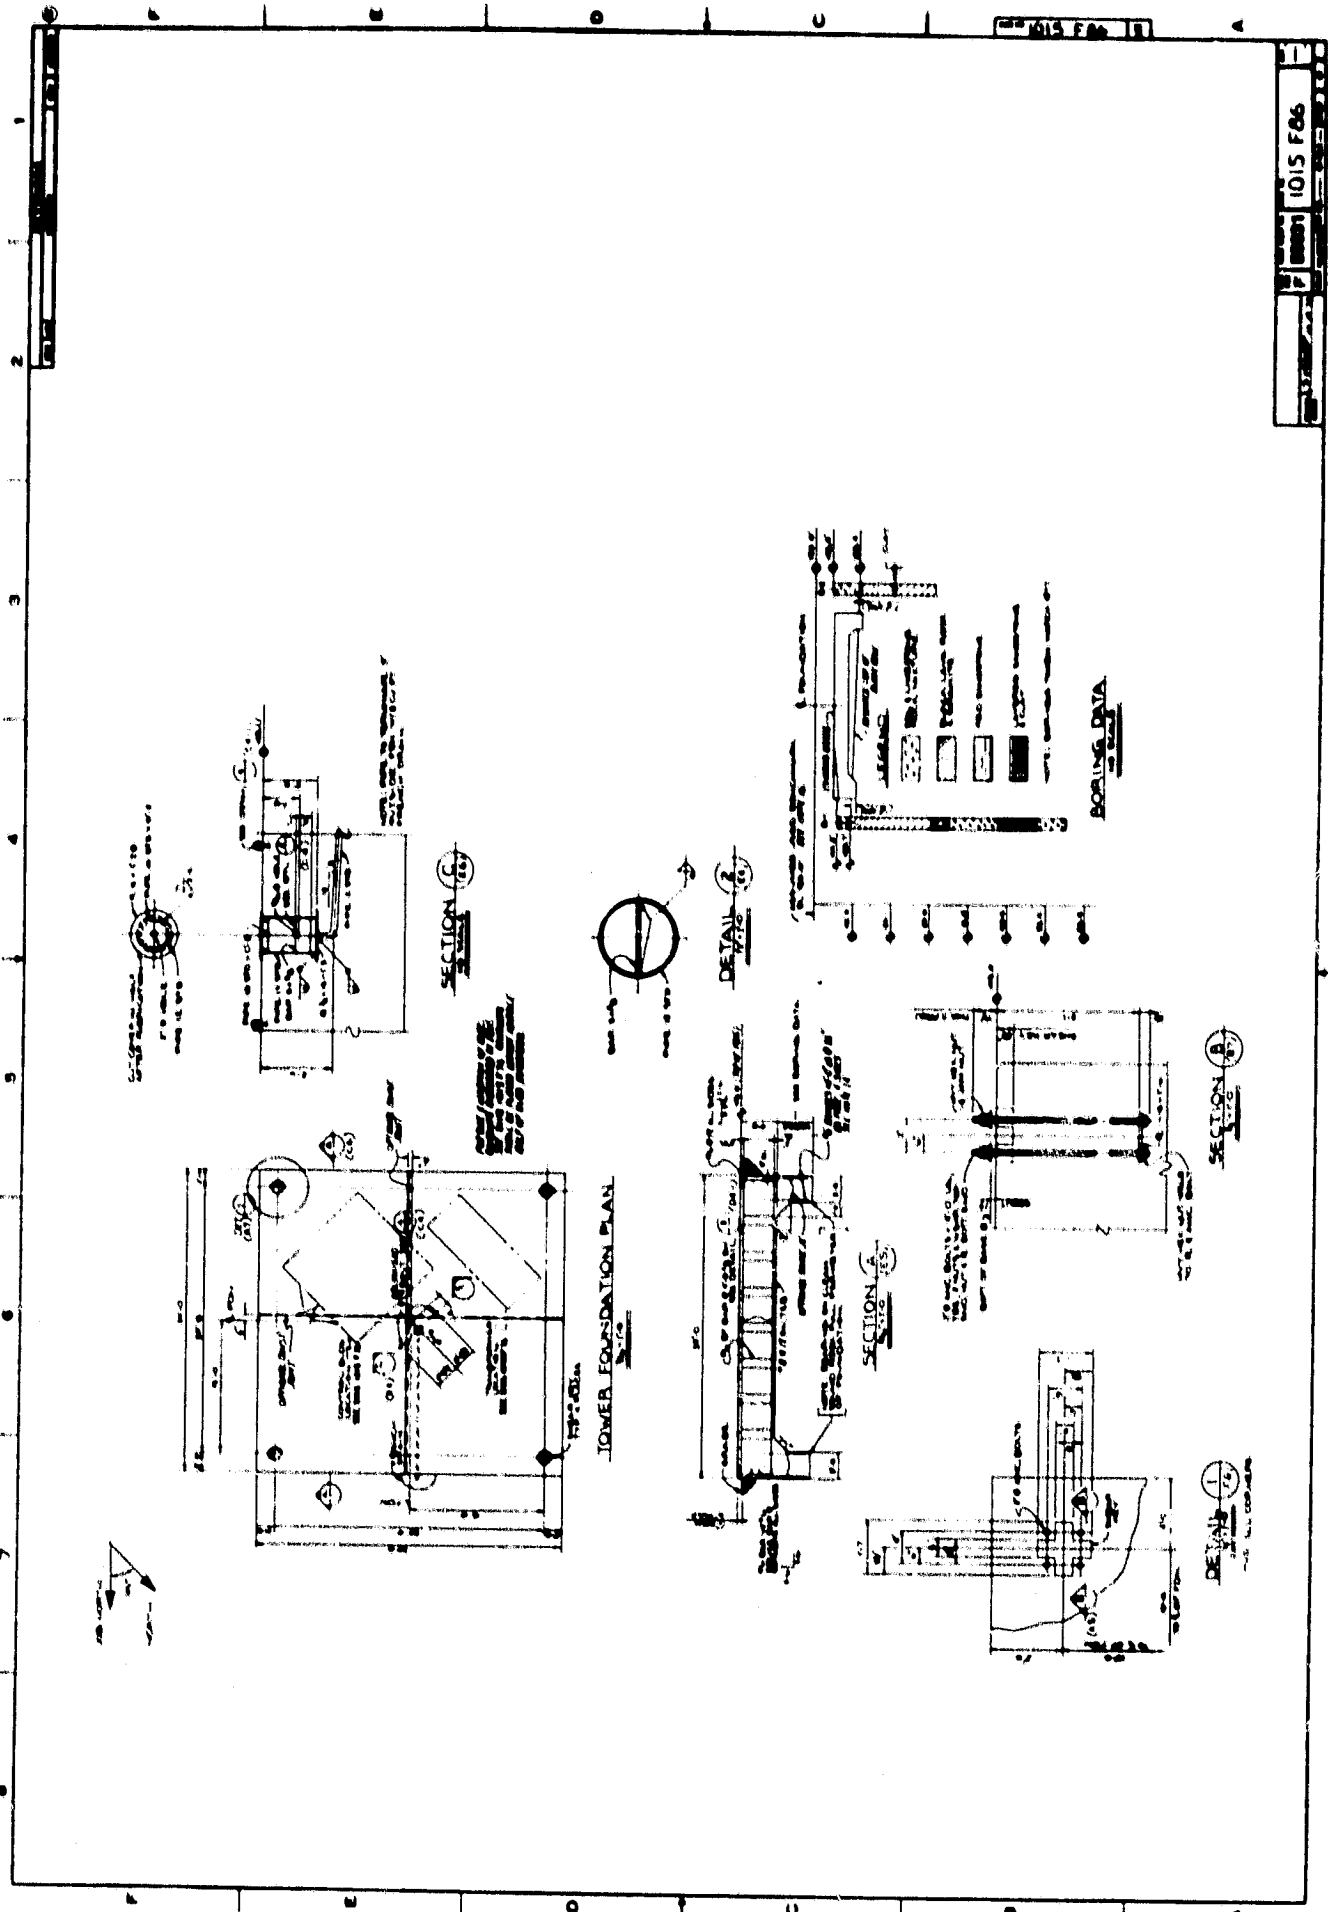



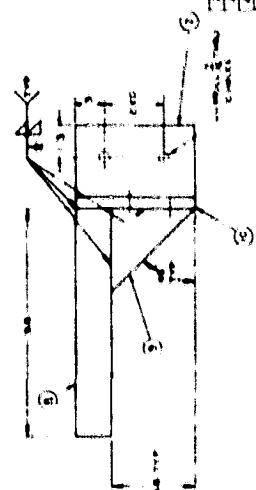



TABLE 1	
GROUP NO.	PER NO.
1	058800
2	058800

[illegible]

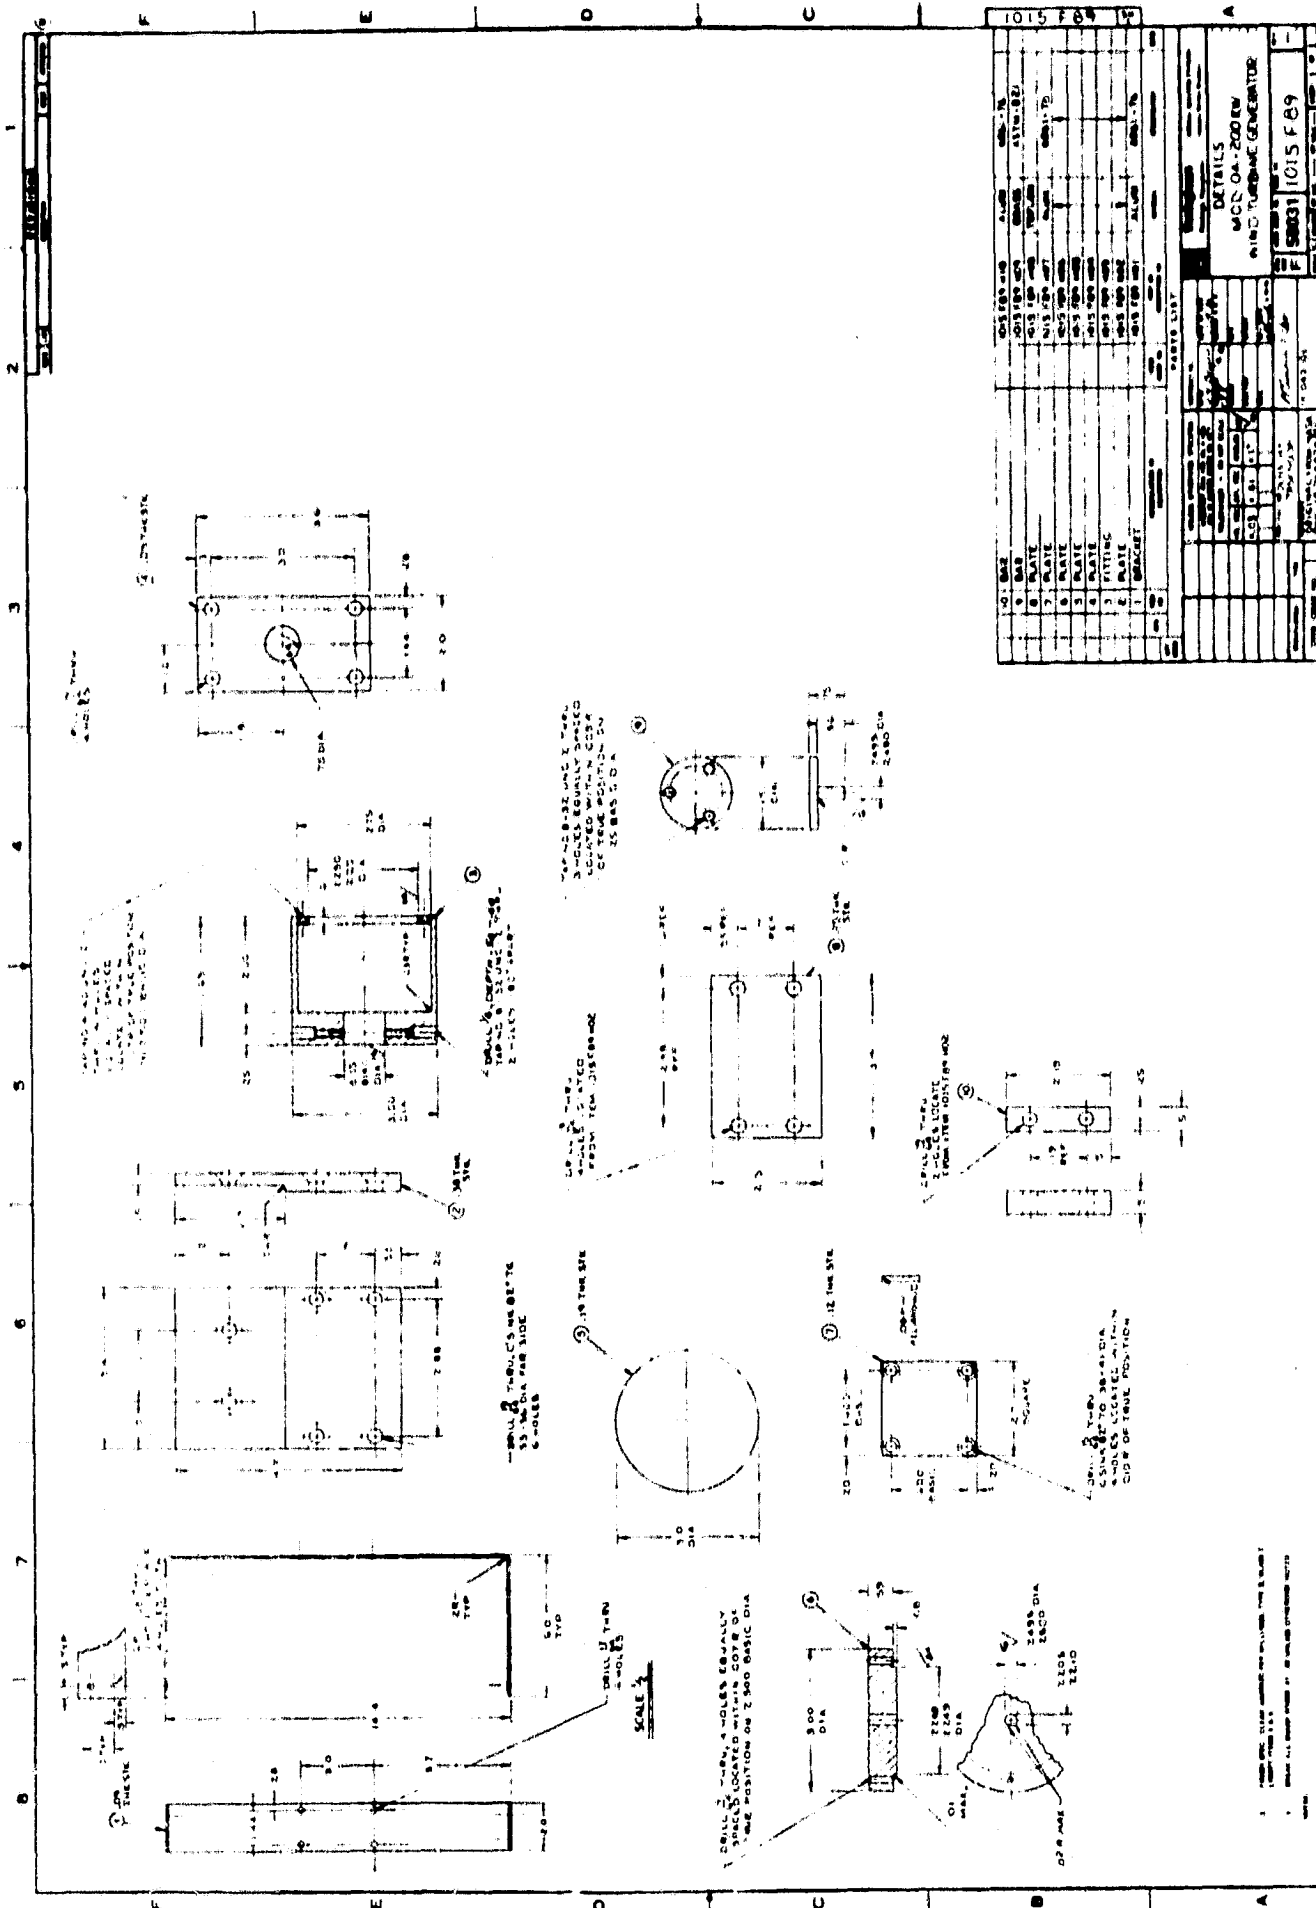

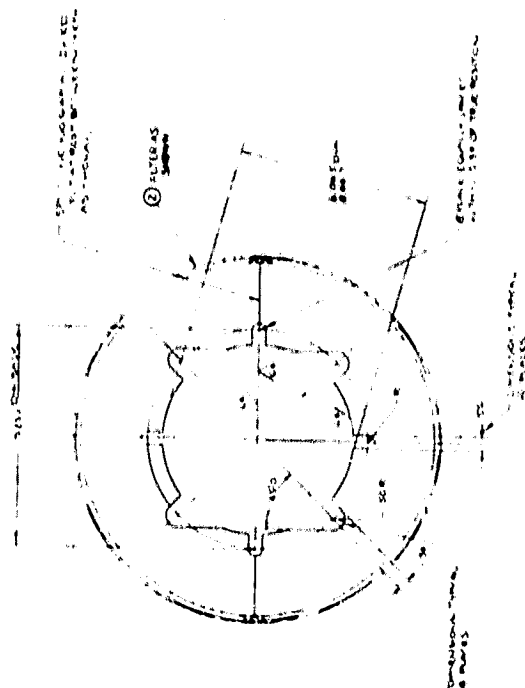

• A A A A

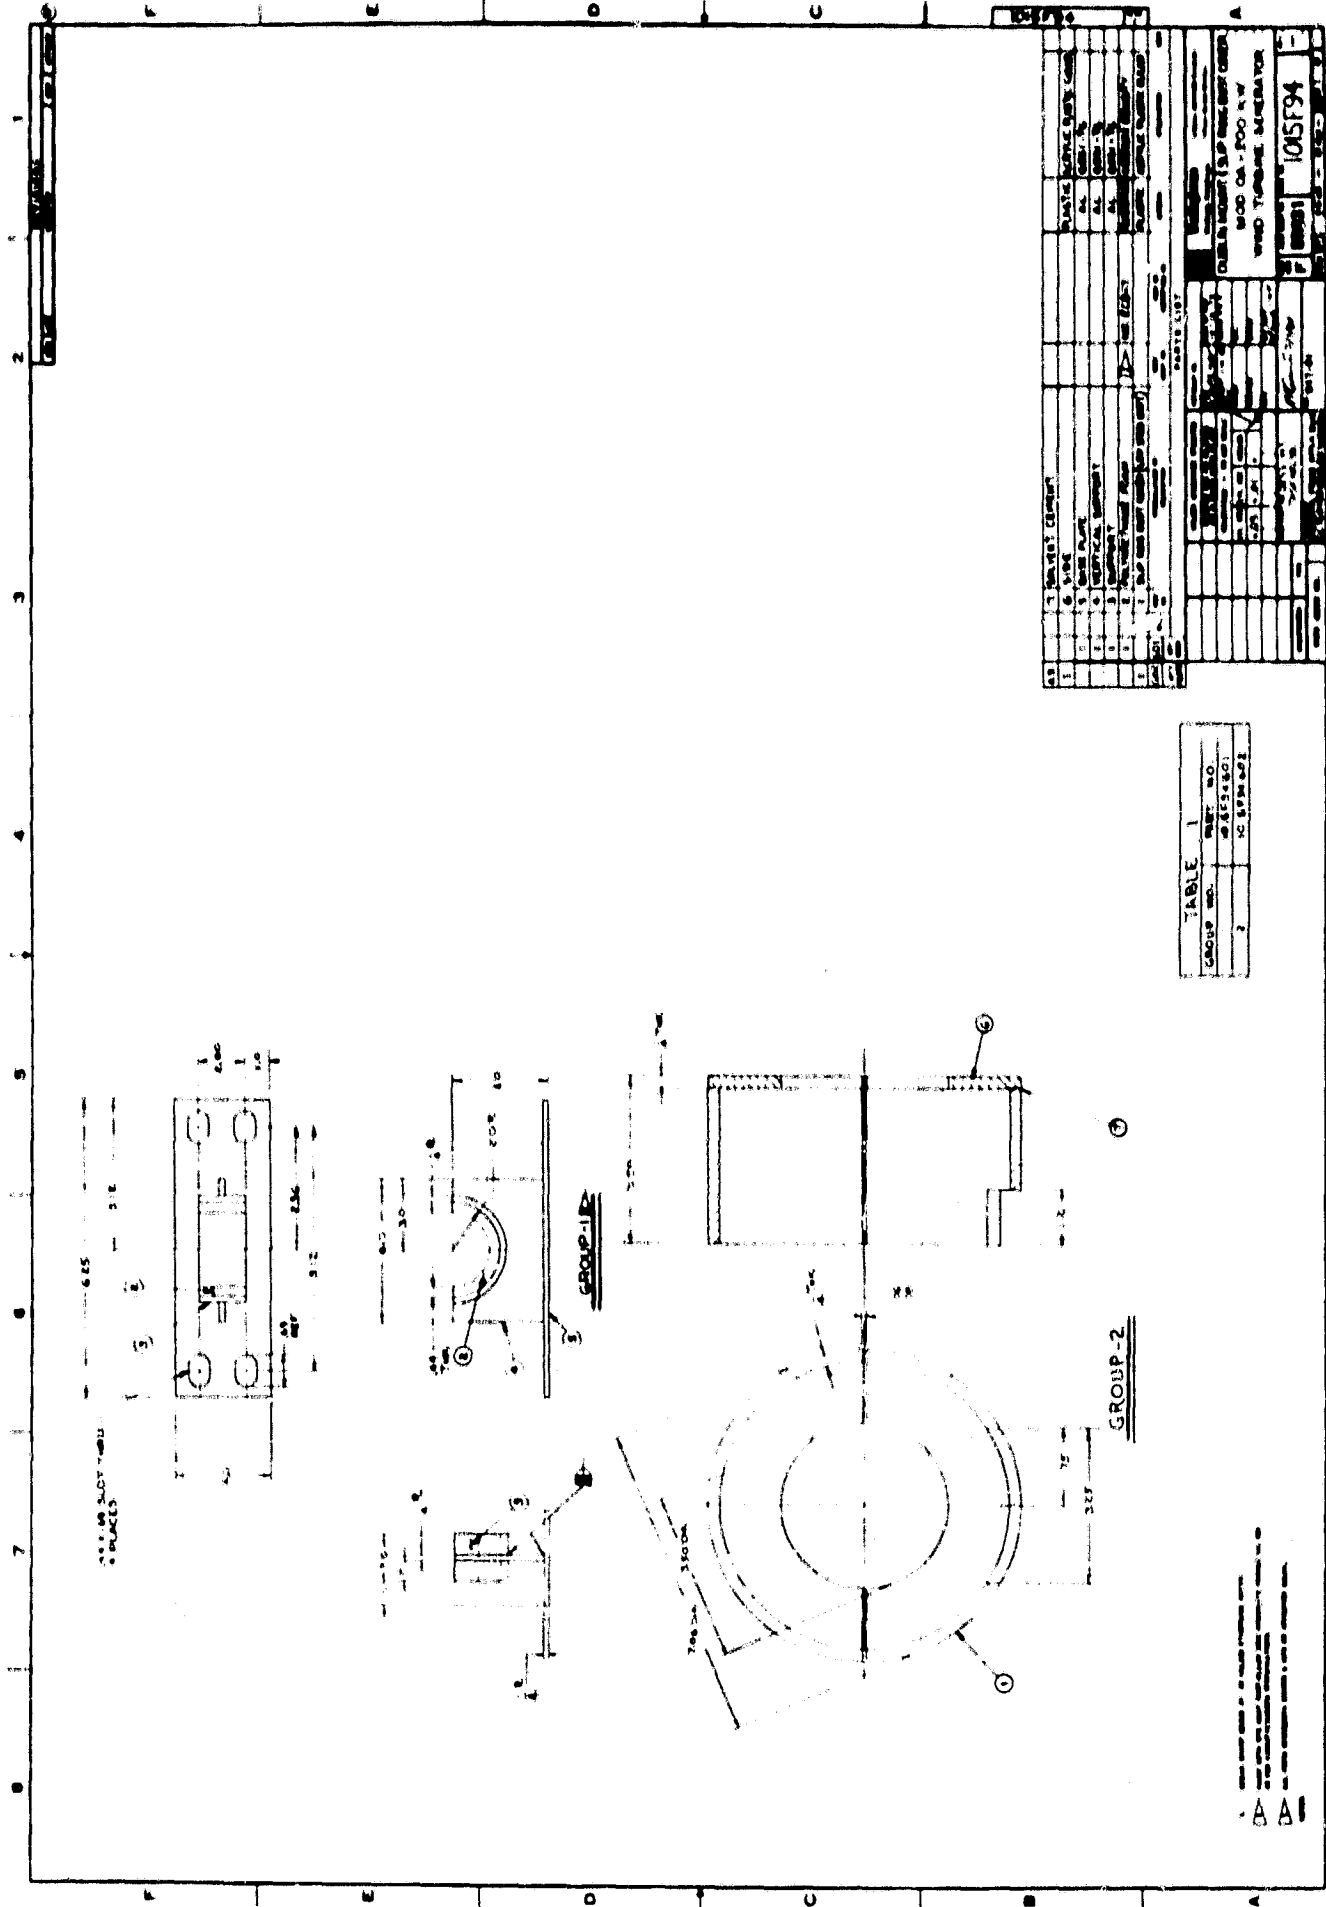




1	
2	
1015145















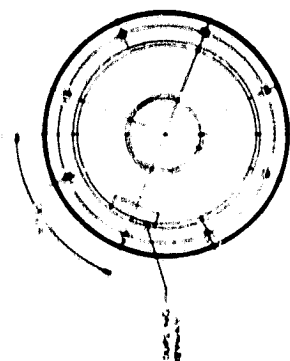 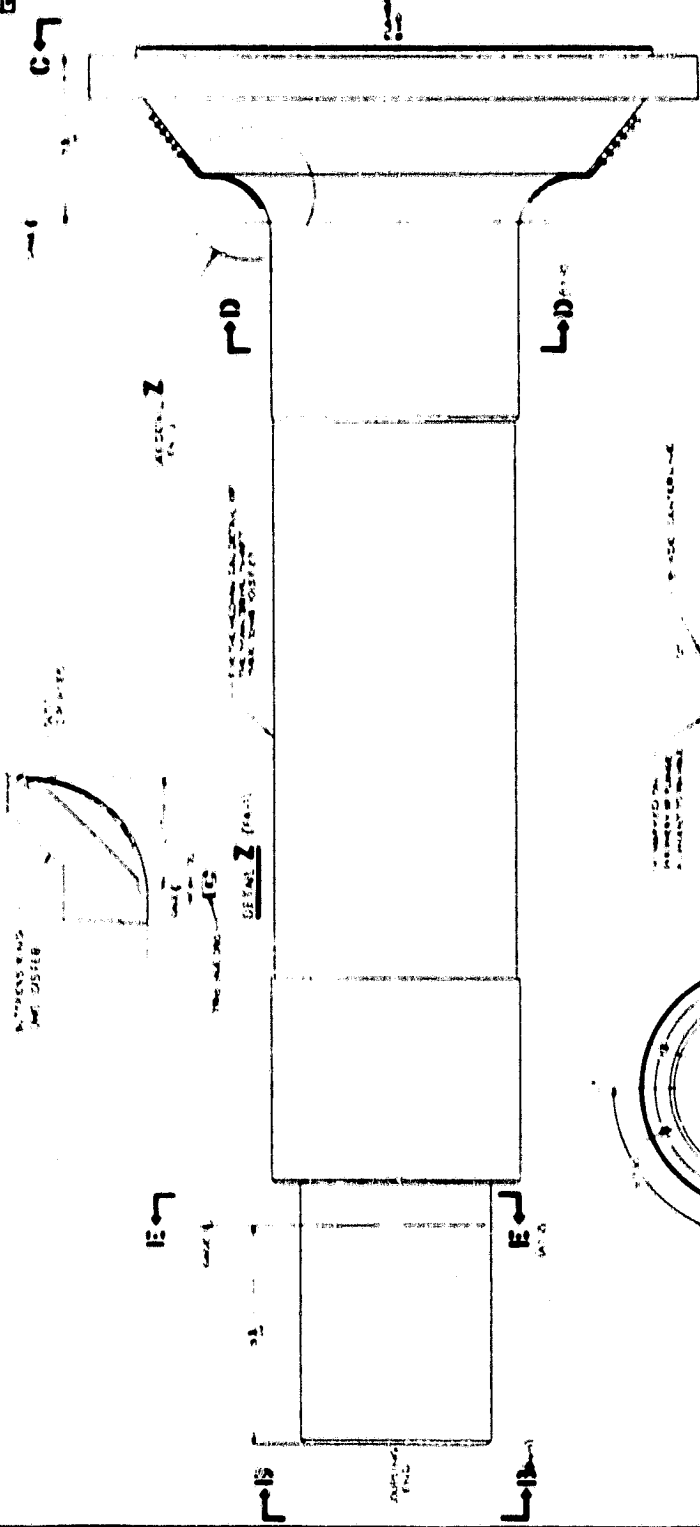

C-3

B-13

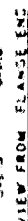

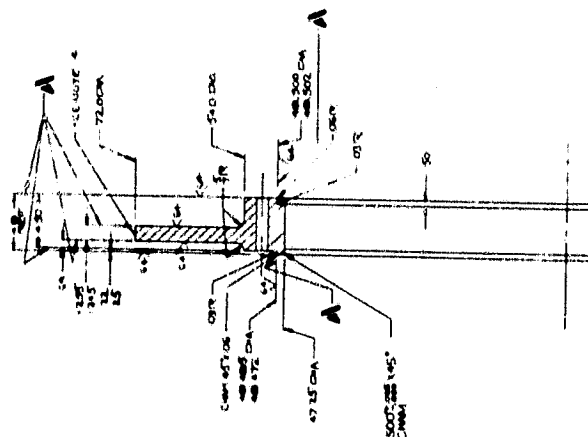[illegible]





[illegible]


TABLE 1	
GROUP NO.	PART NO.
1	01872030

13-13

1. **A** - [illegible]
2. [illegible]
3. [illegible]
[illegible][illegible]

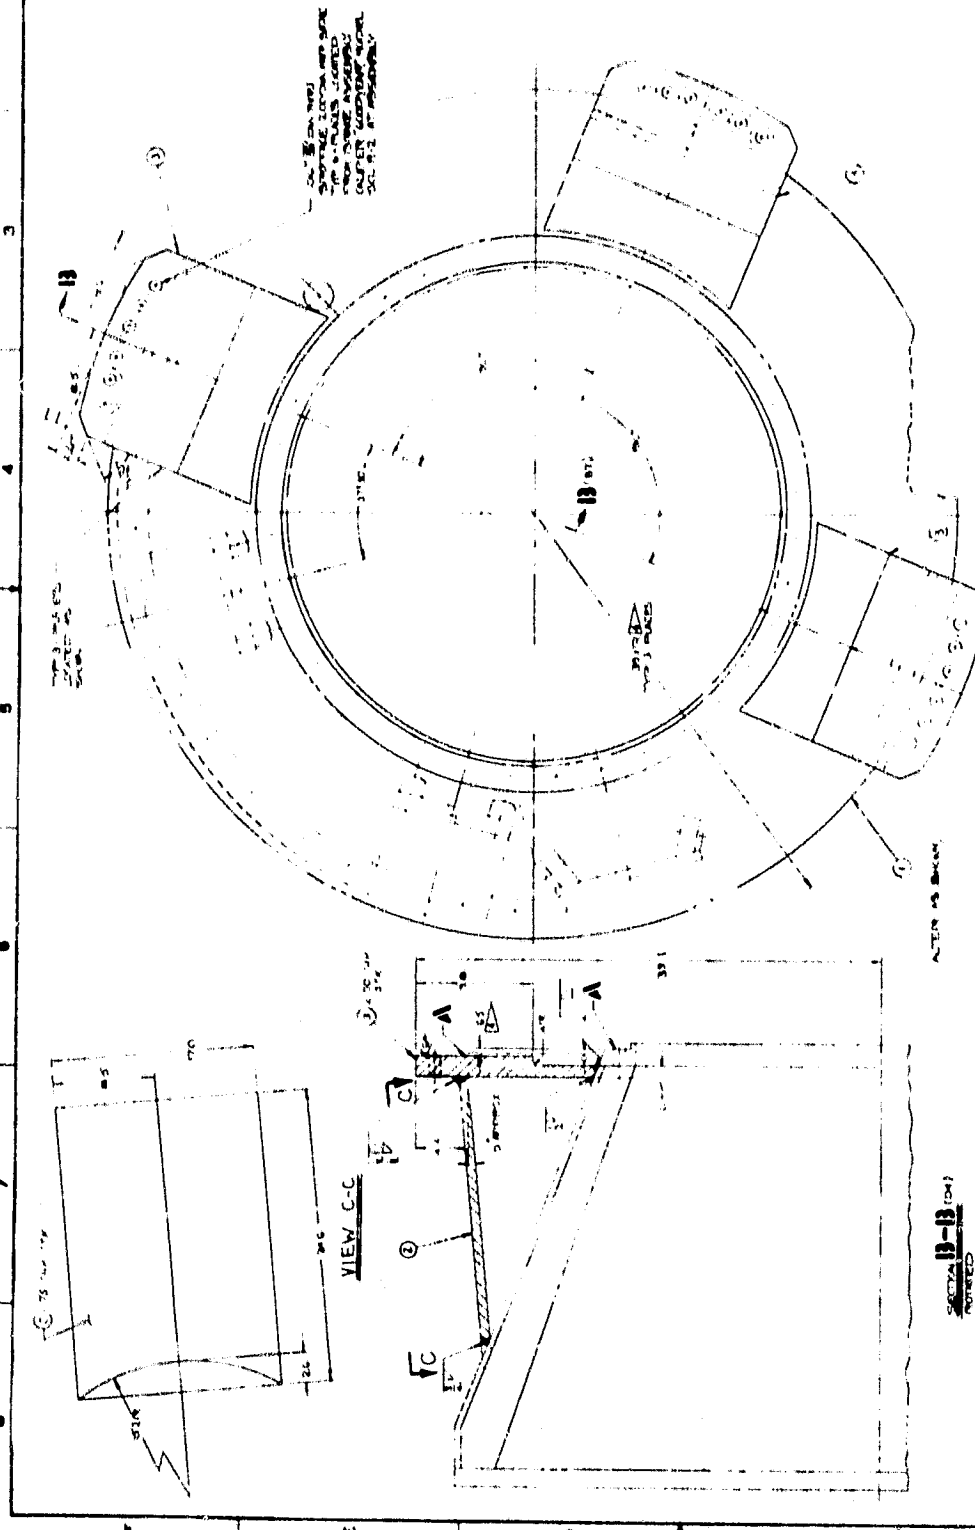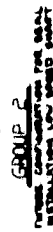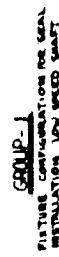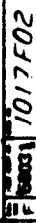

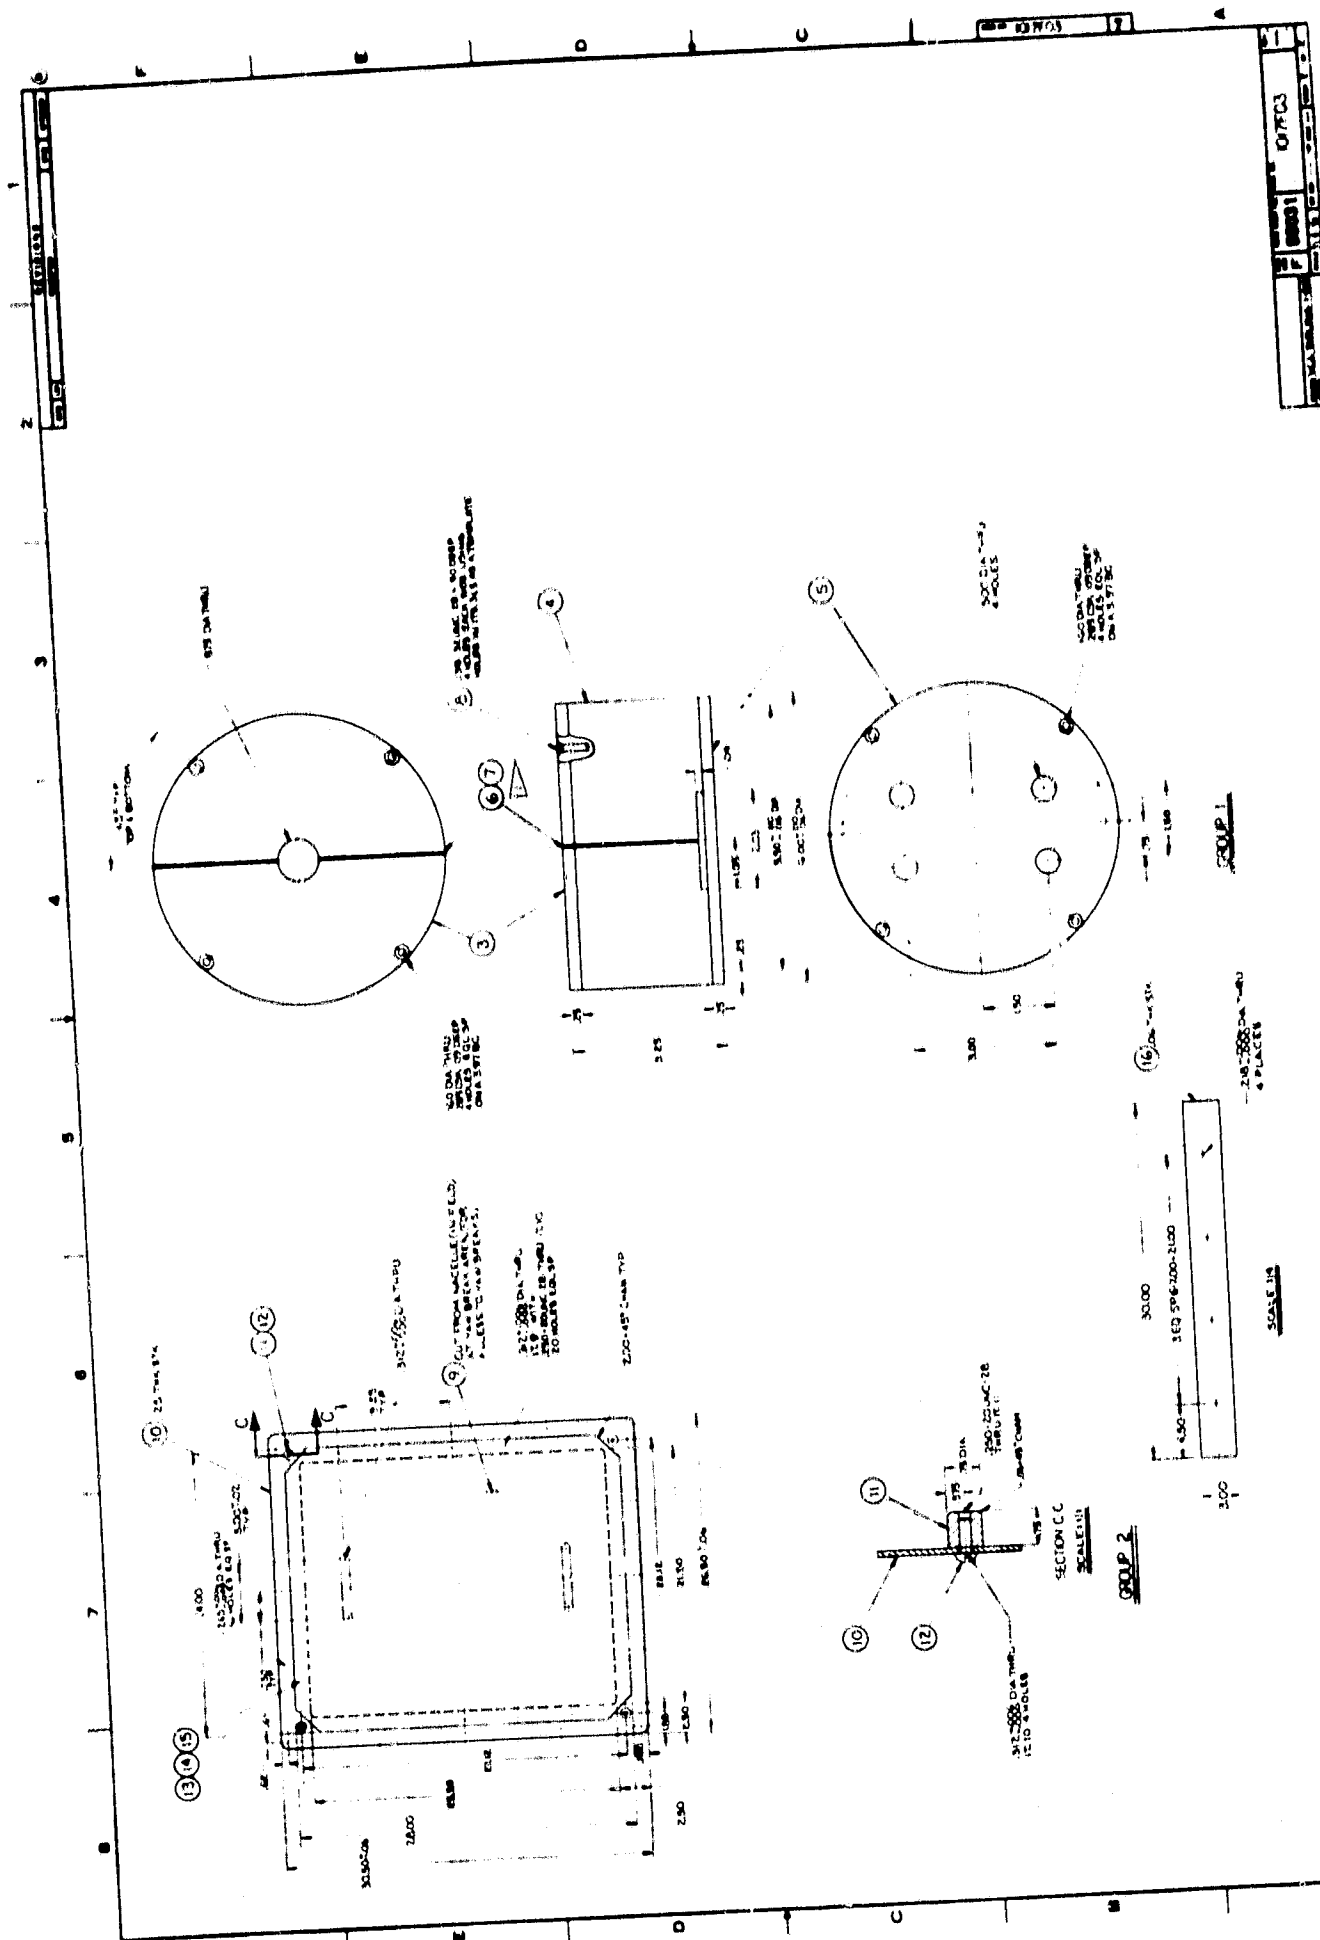




GROUP NO.	DATE NO.
1	107704601


[illegible]

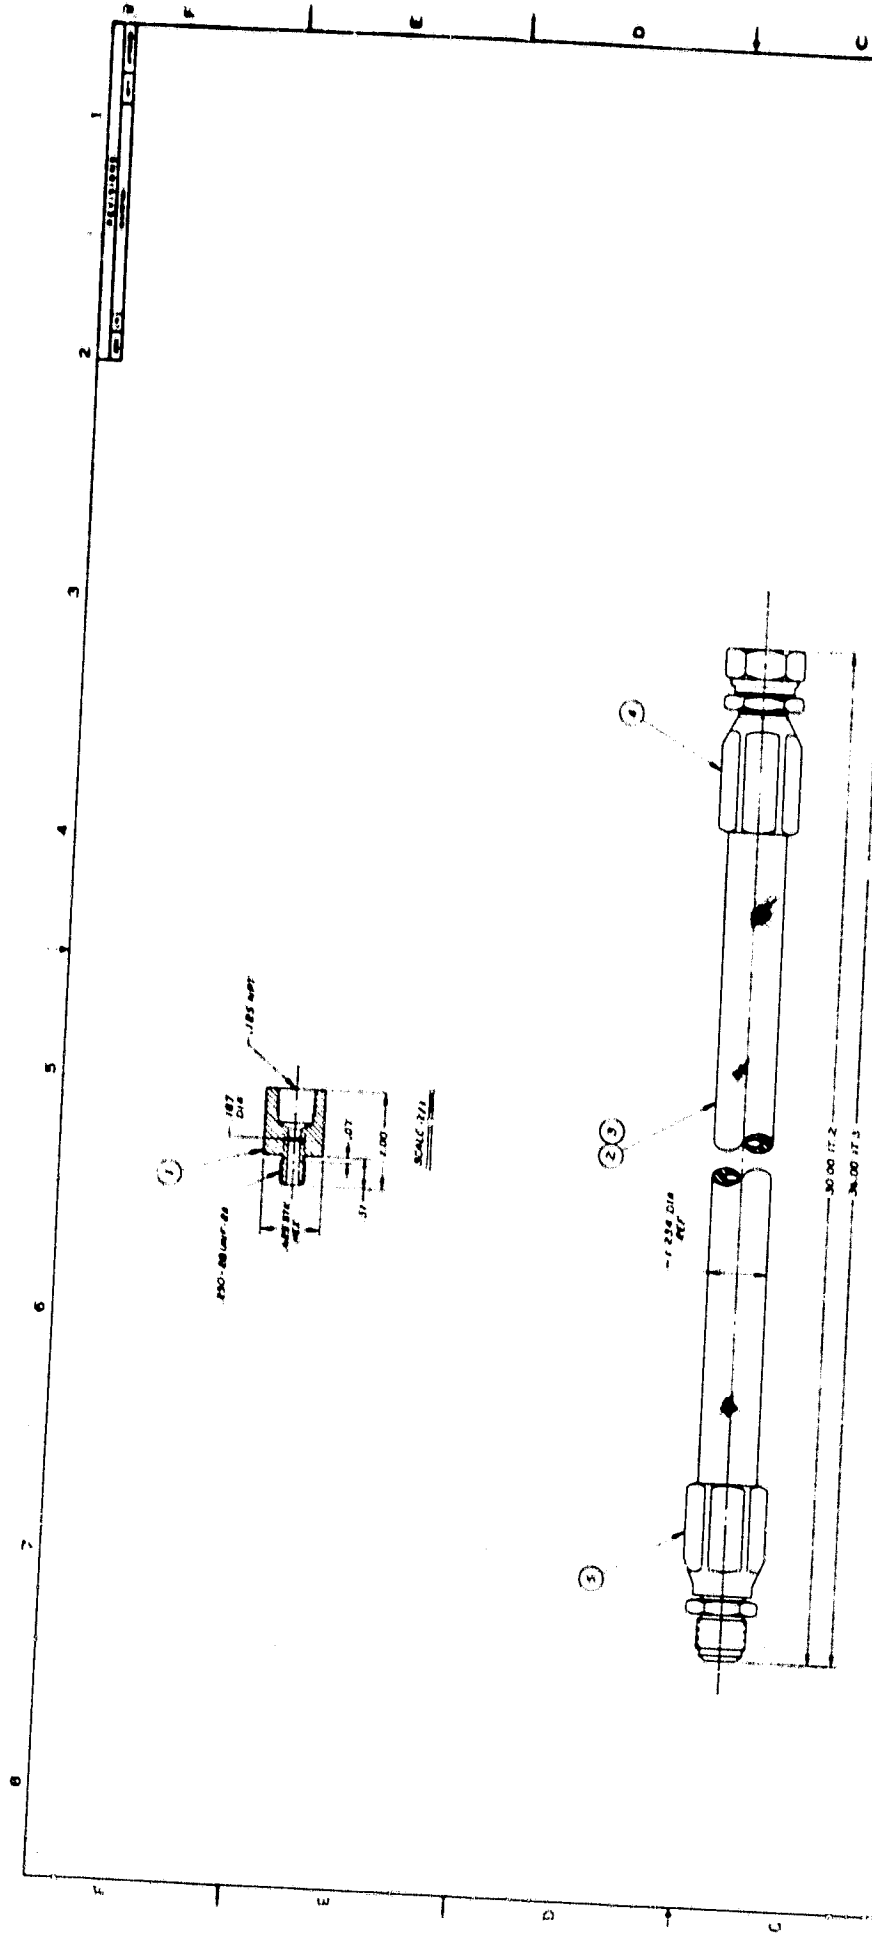

GROUP-1c2
SCALE 1/1

TABLE 1




GROUP NO	ITEM NO	DESCRIPTION
1	1	10170302

1017703	
1	FLAME TIGHT FITTING
2	FLAME TIGHT FITTING
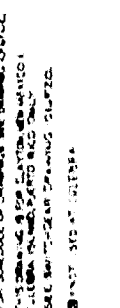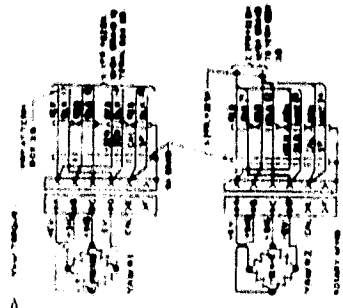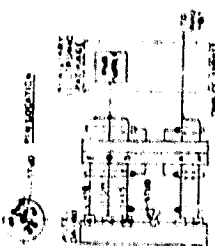





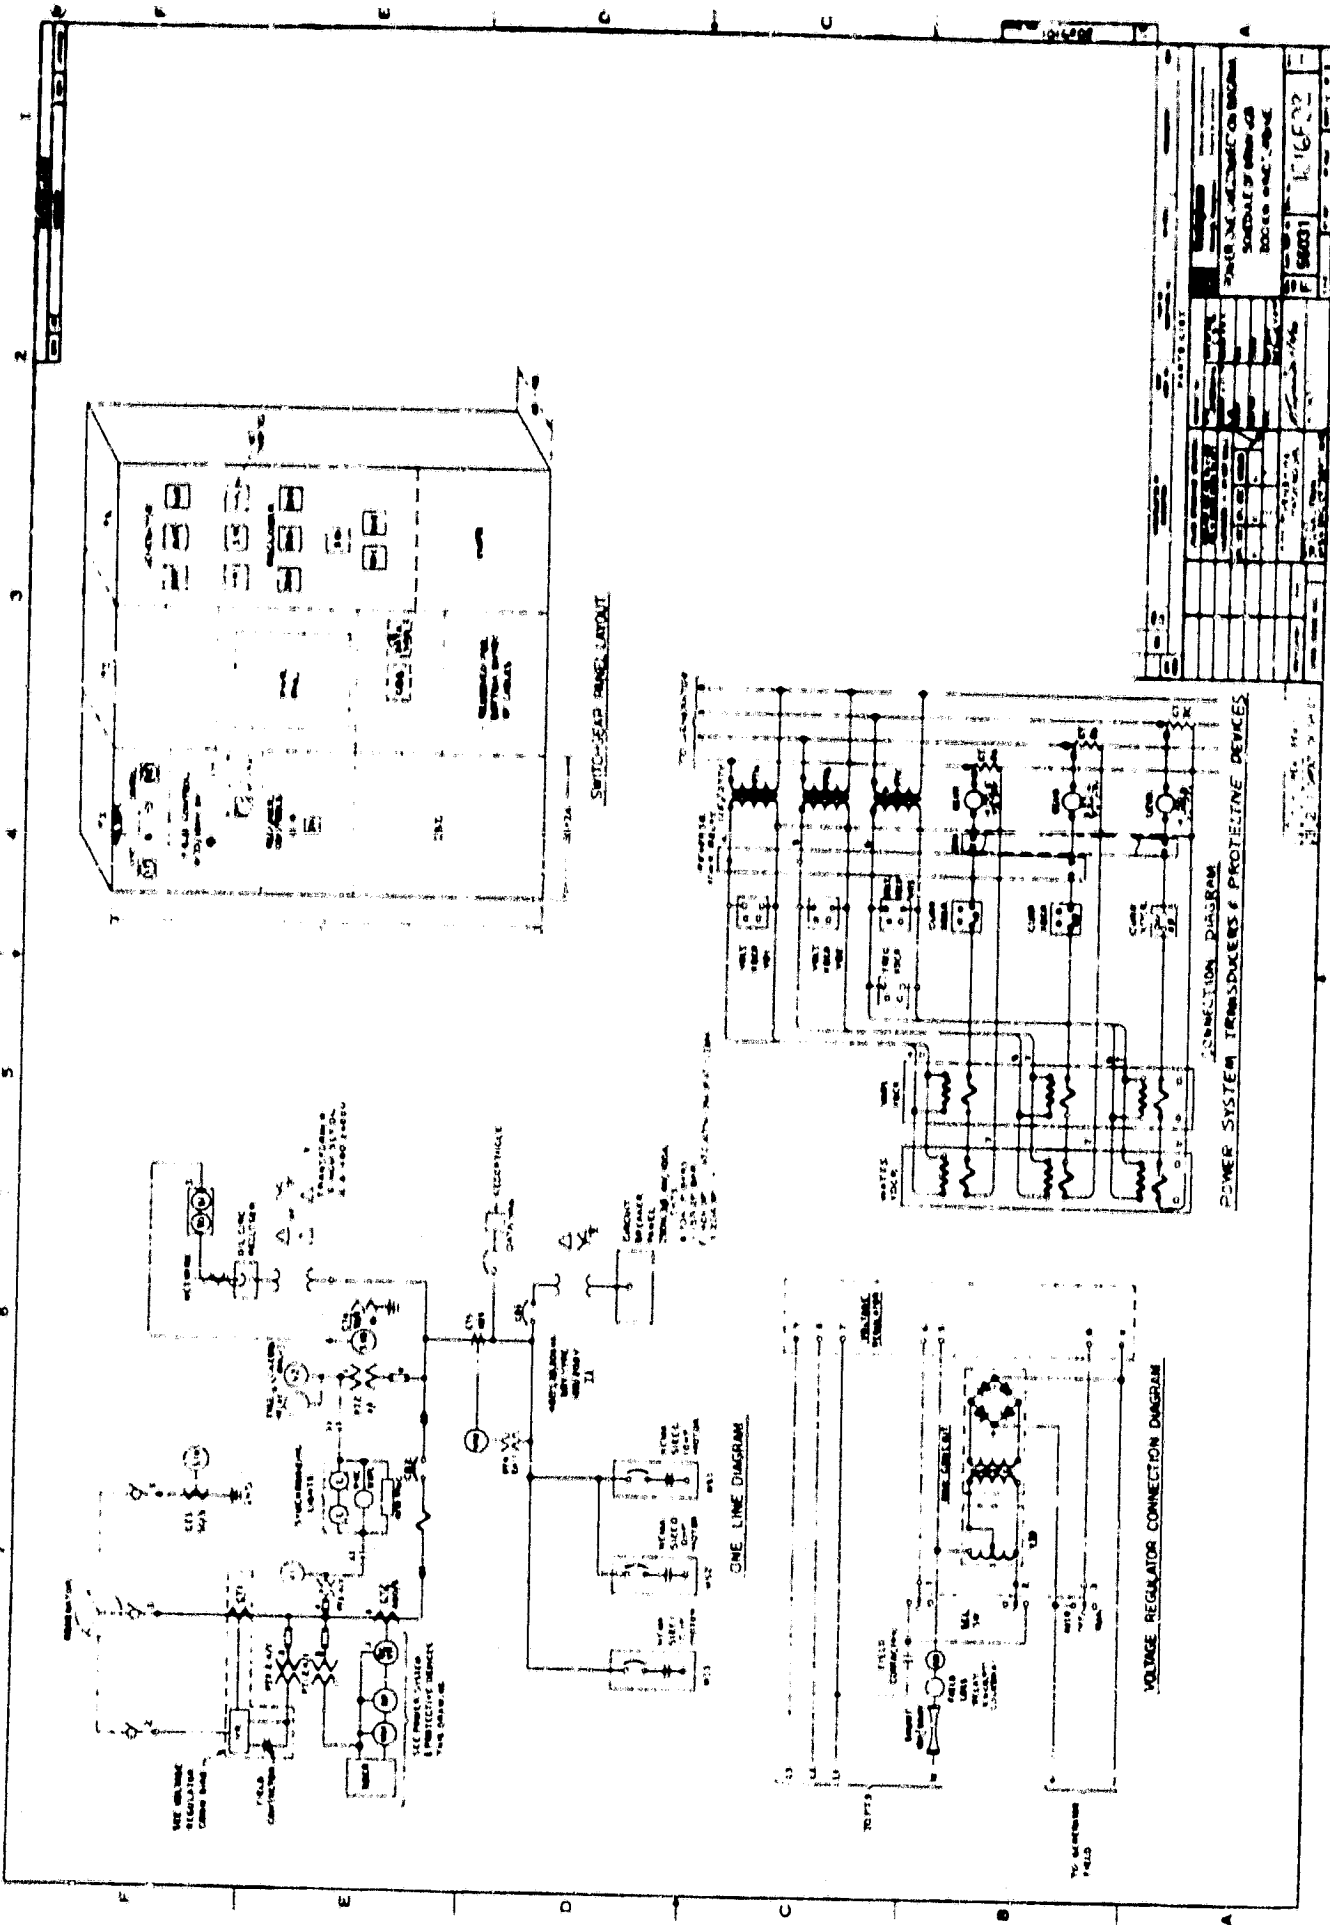



[illegible]

1		2		


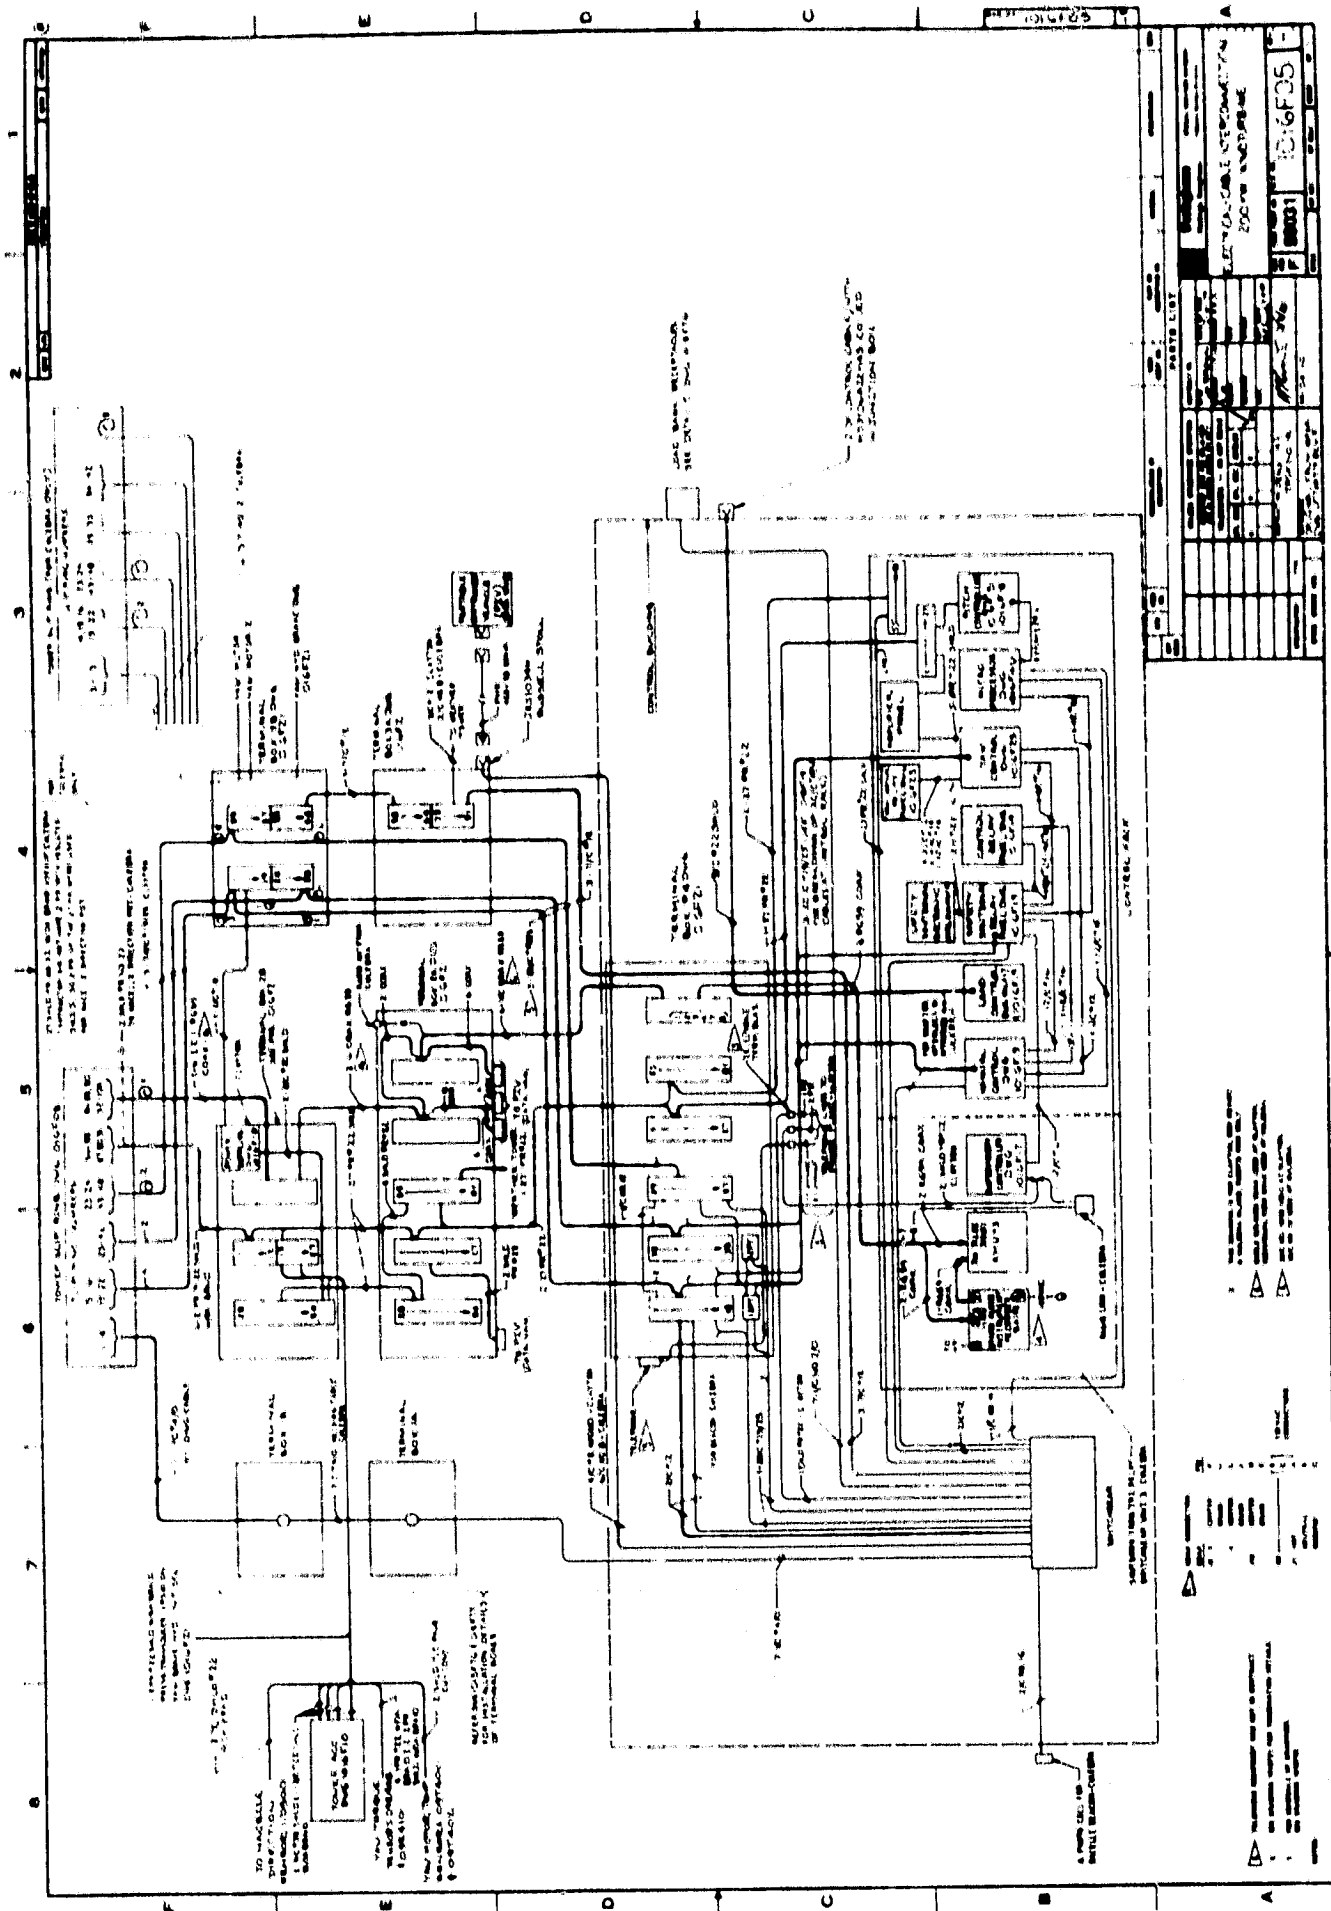


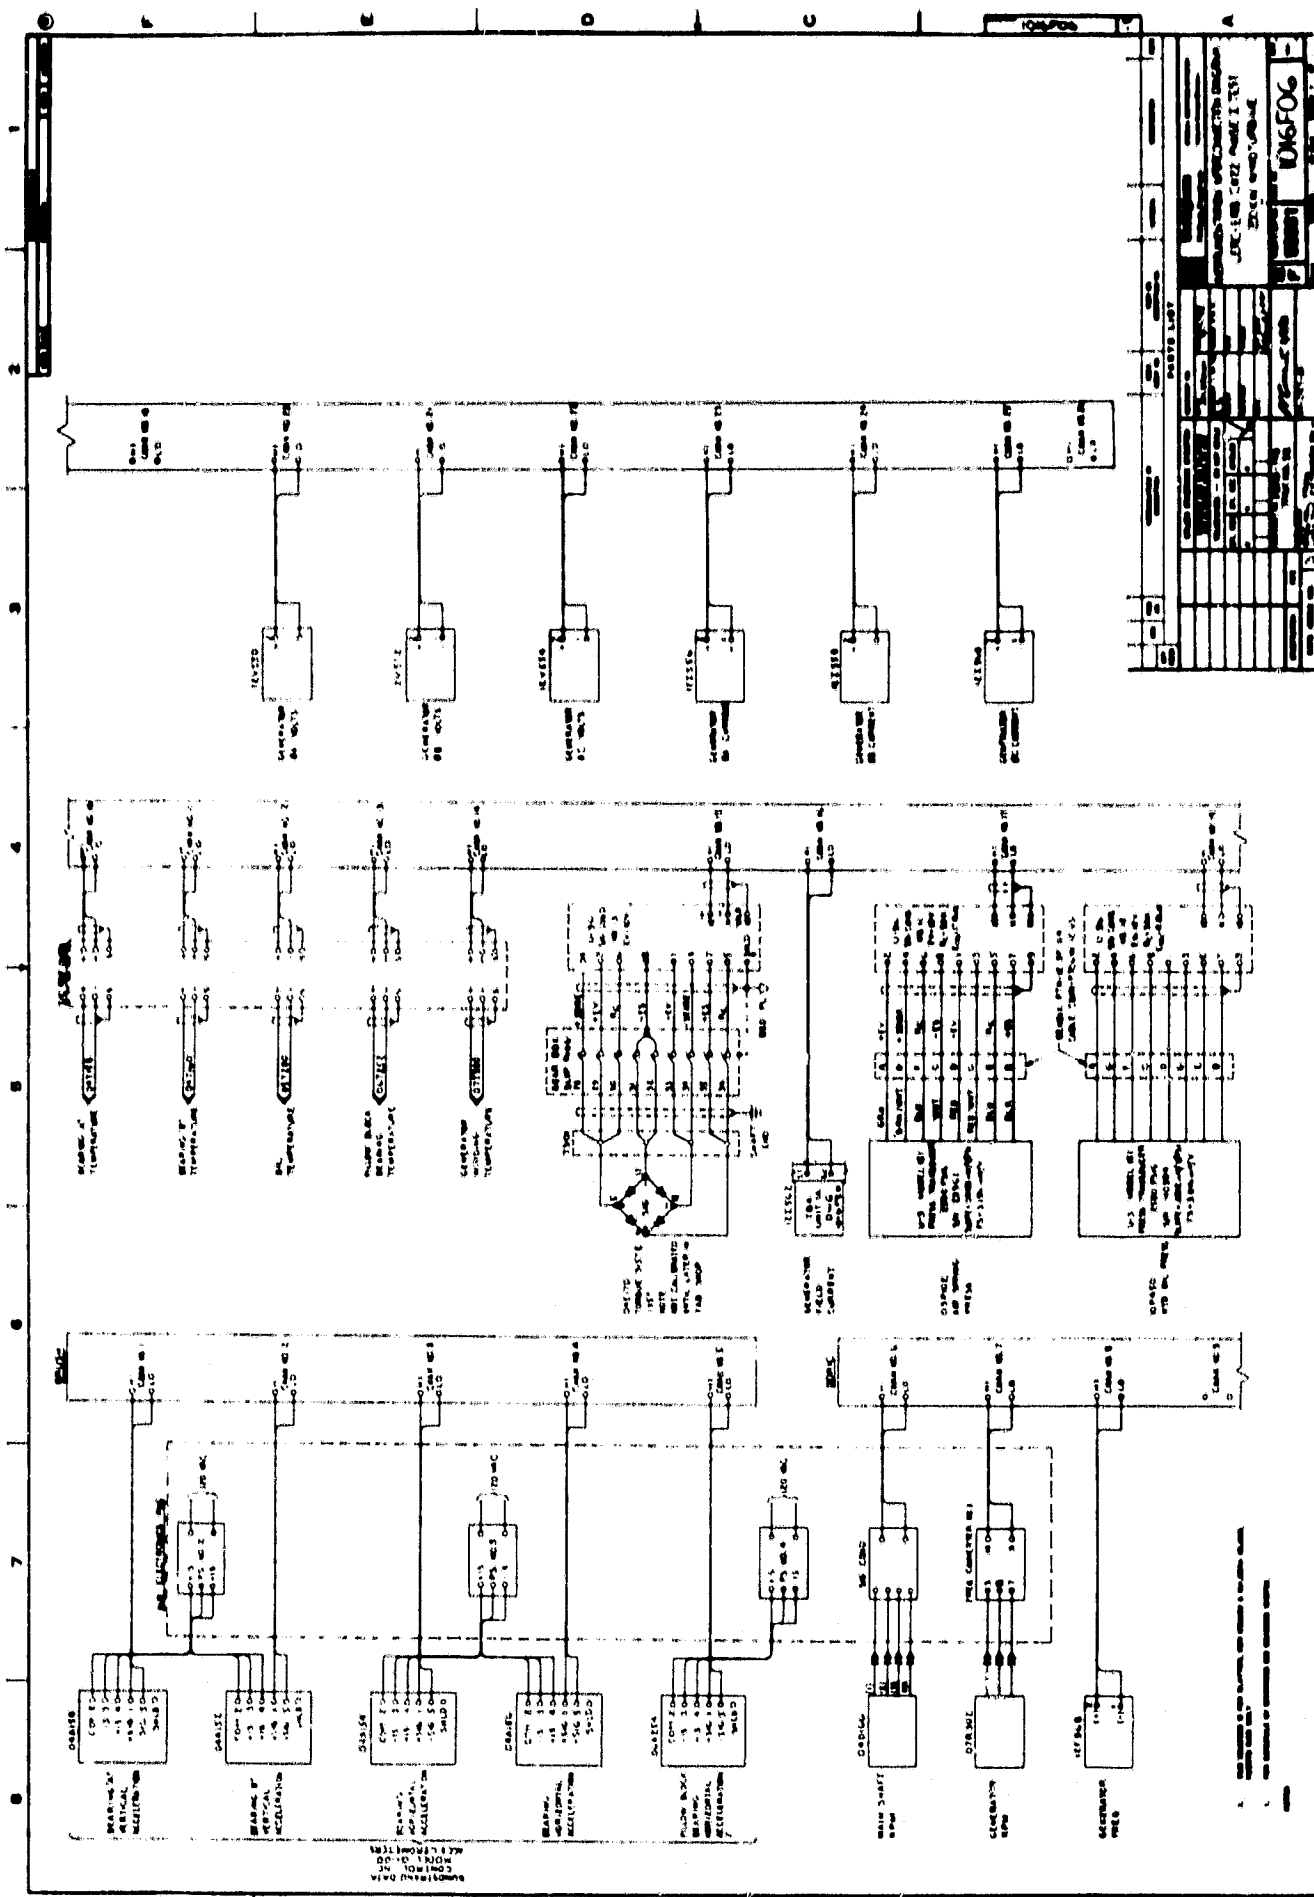


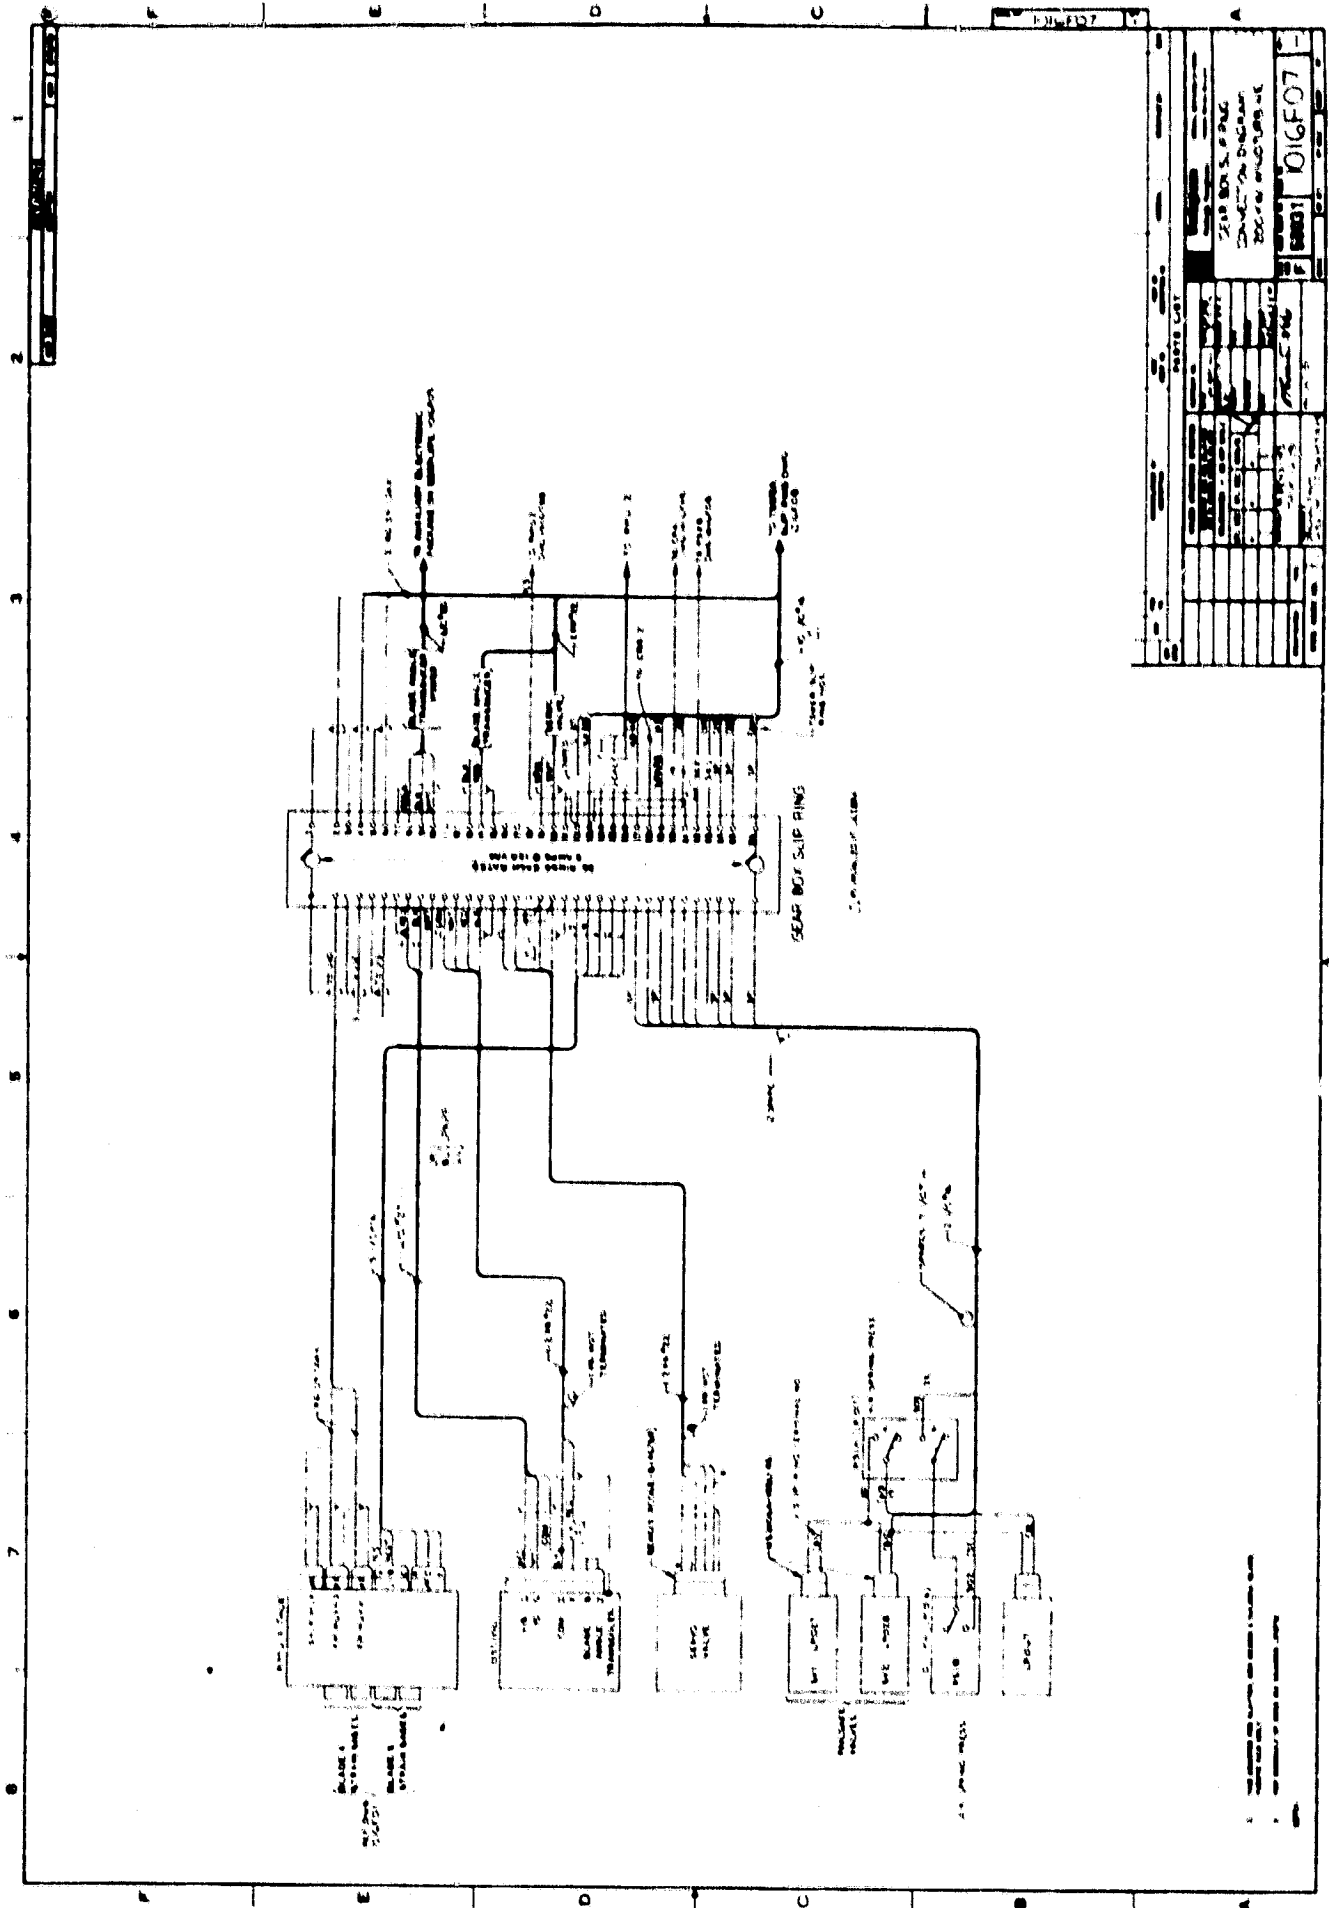

ORIGINAL PAGE IS
OF POOR QUALITY




INSTRUMENT RACK
EQUIPMENT LAYOUT

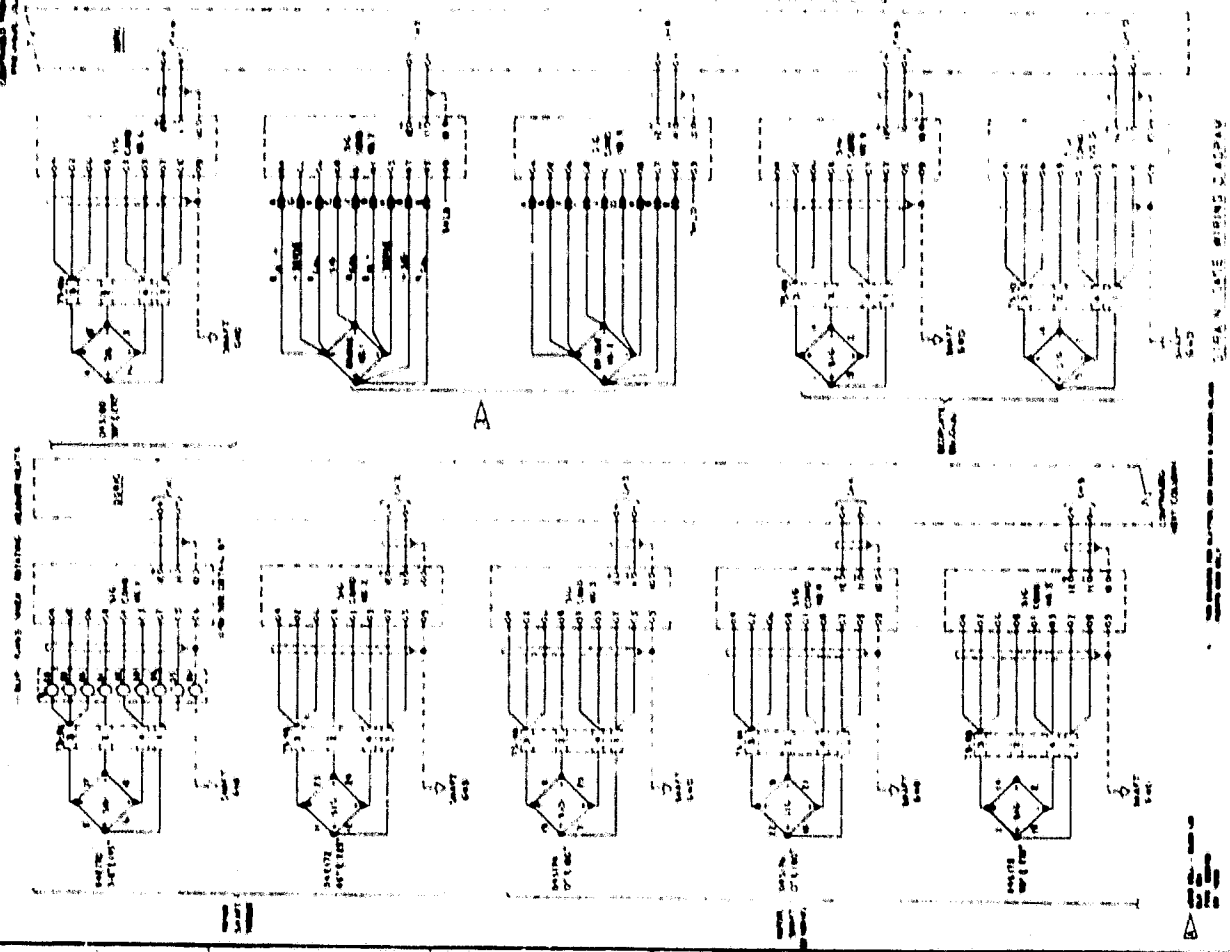
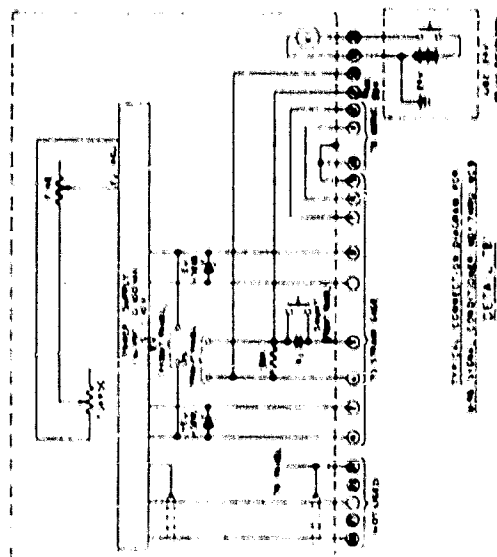



TEST POINT	TEST POINT	TEST POINT
1	2	3


1016F09

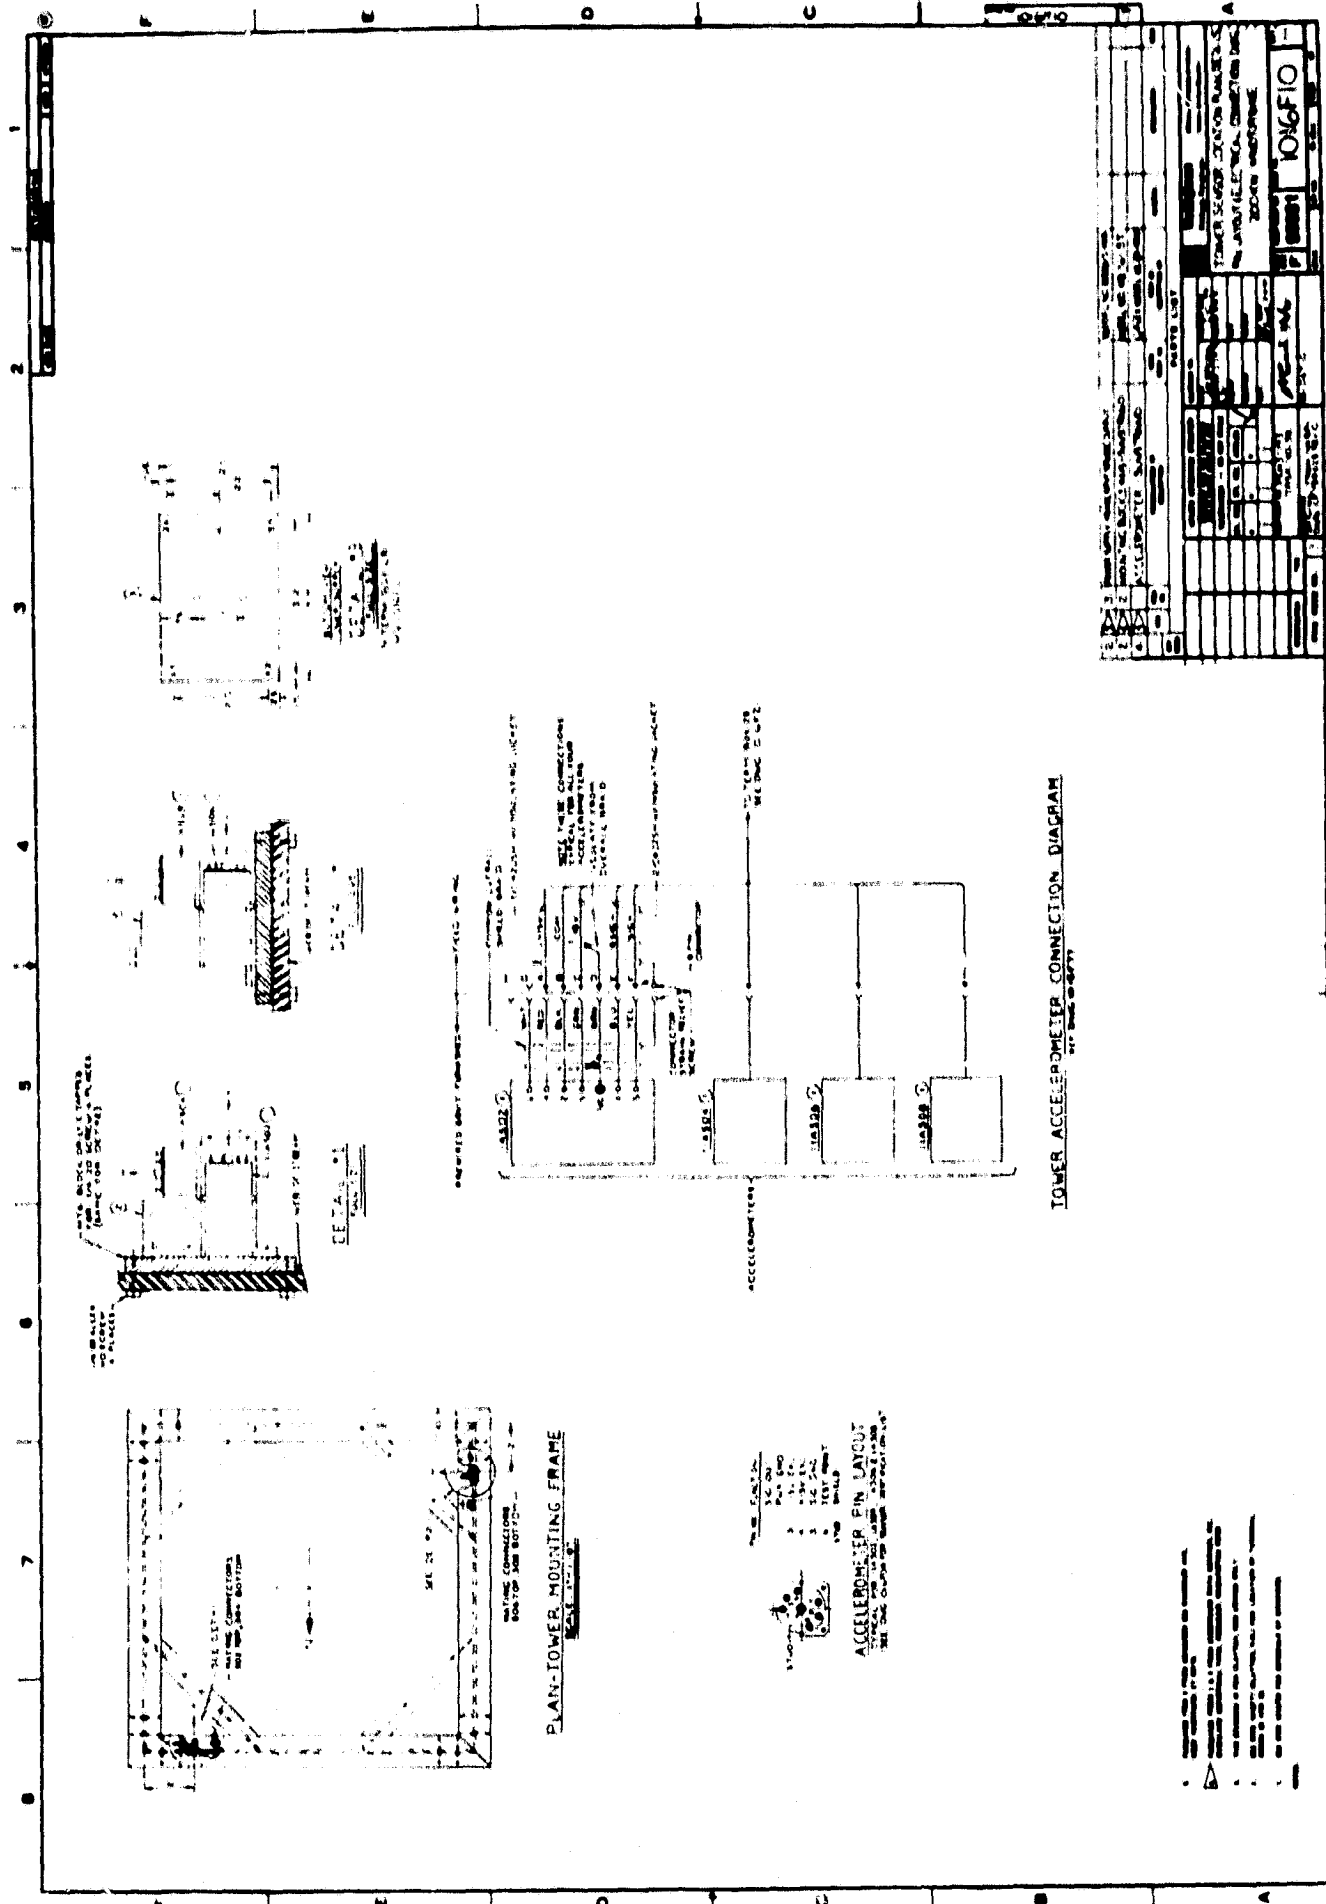


 
[illegible]

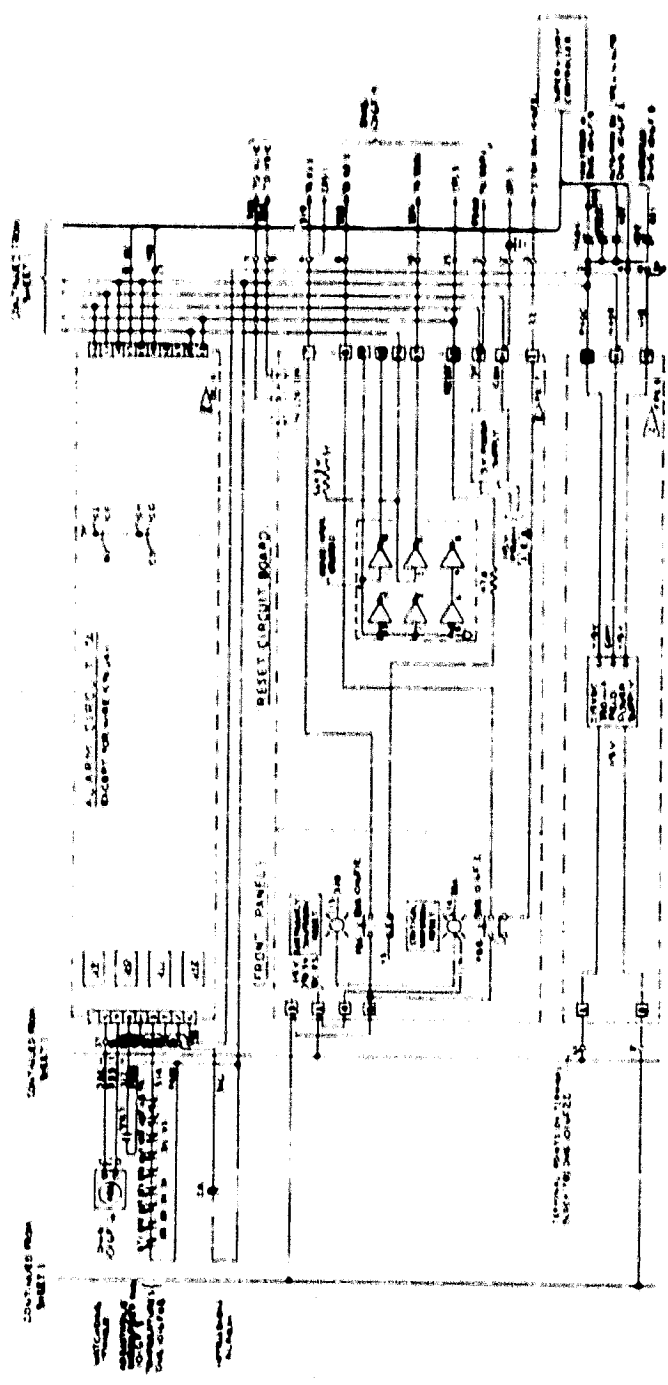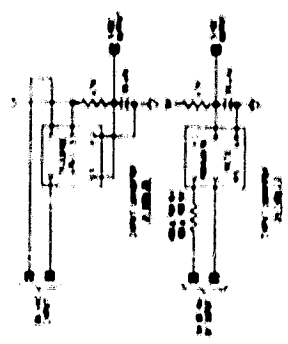

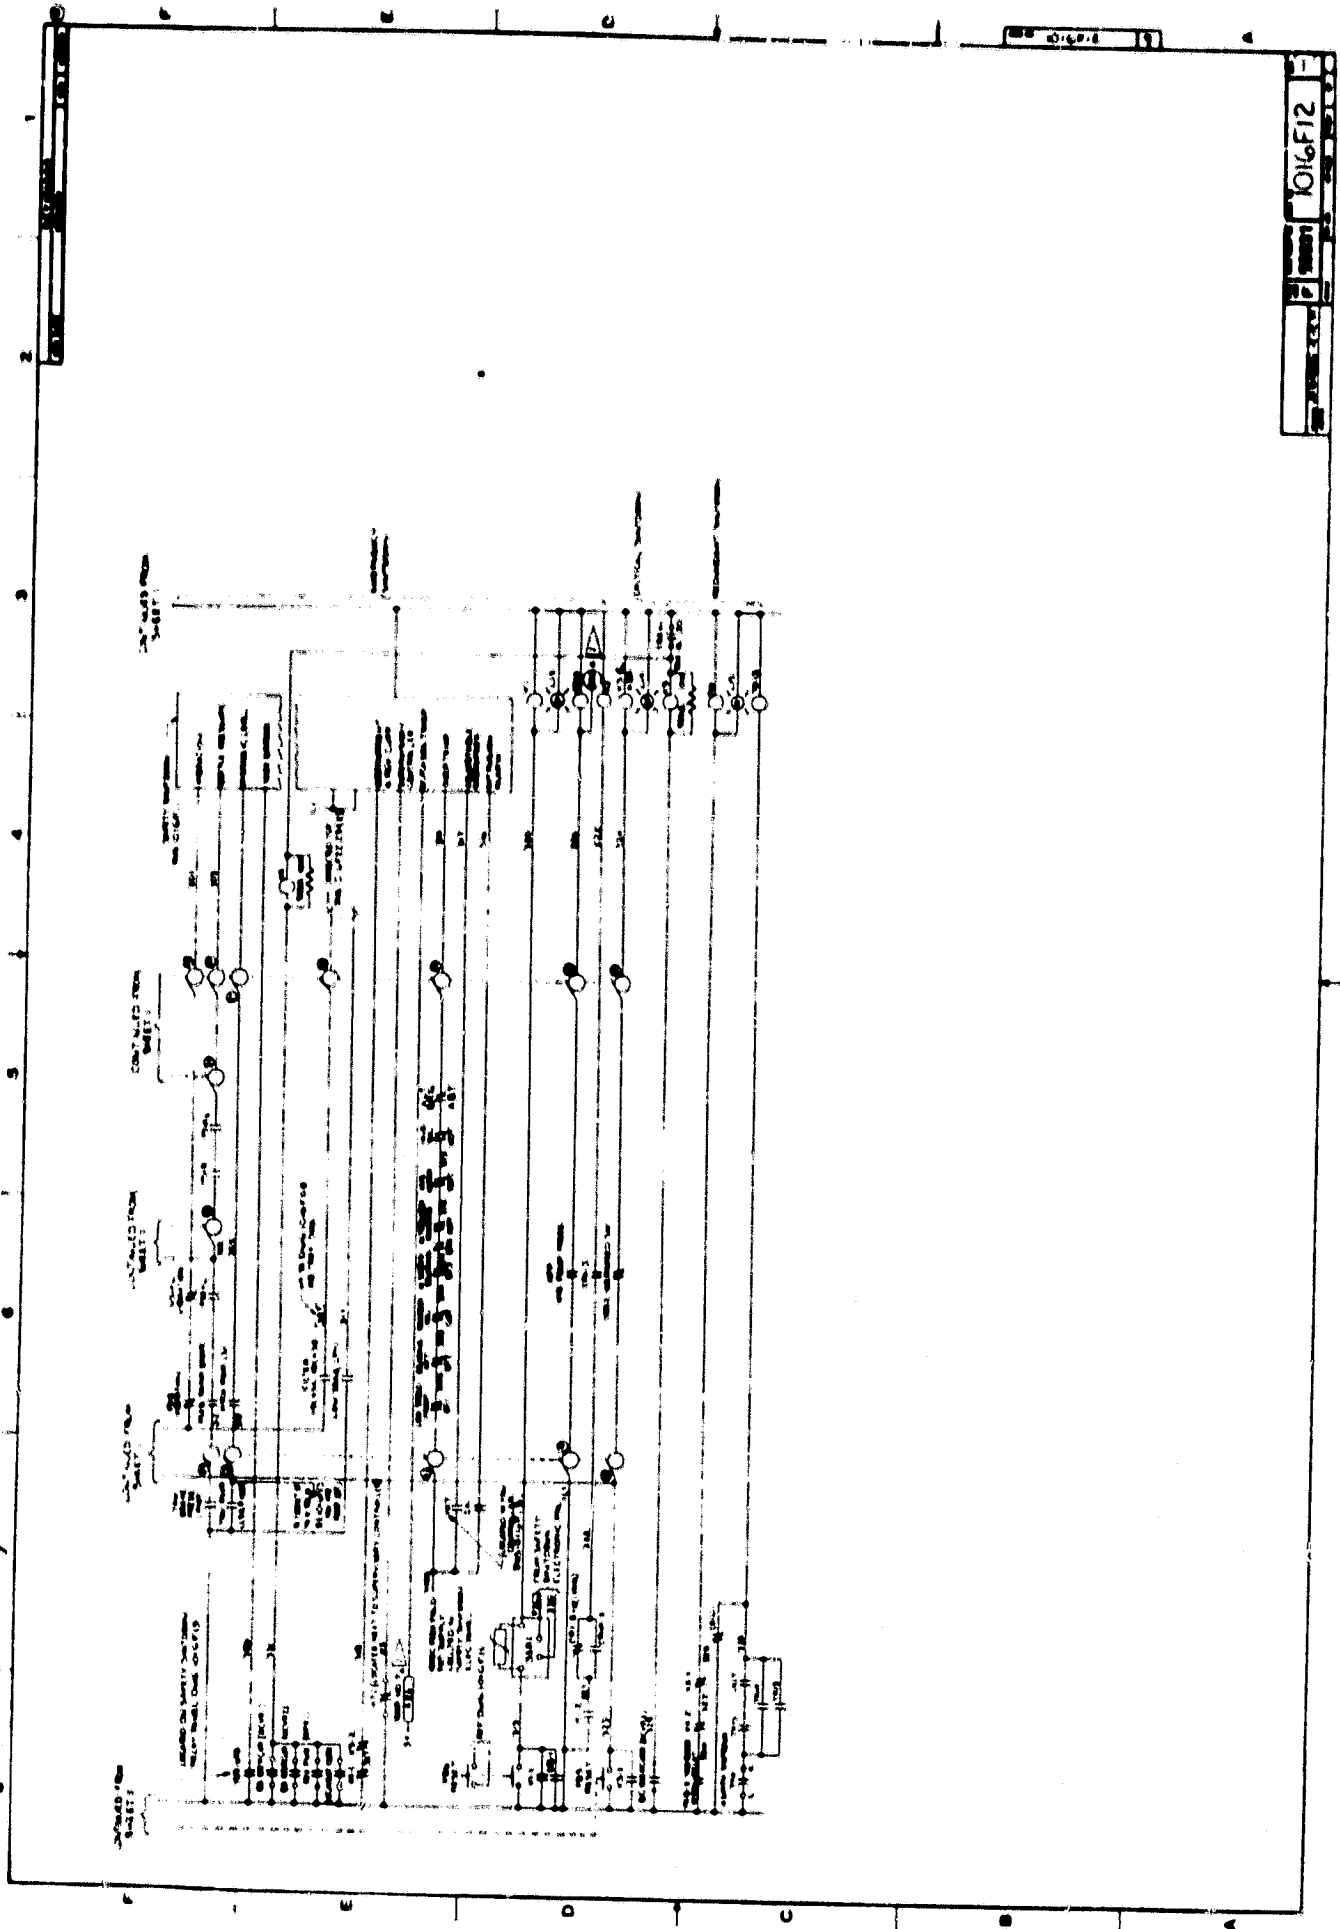

 
[illegible]

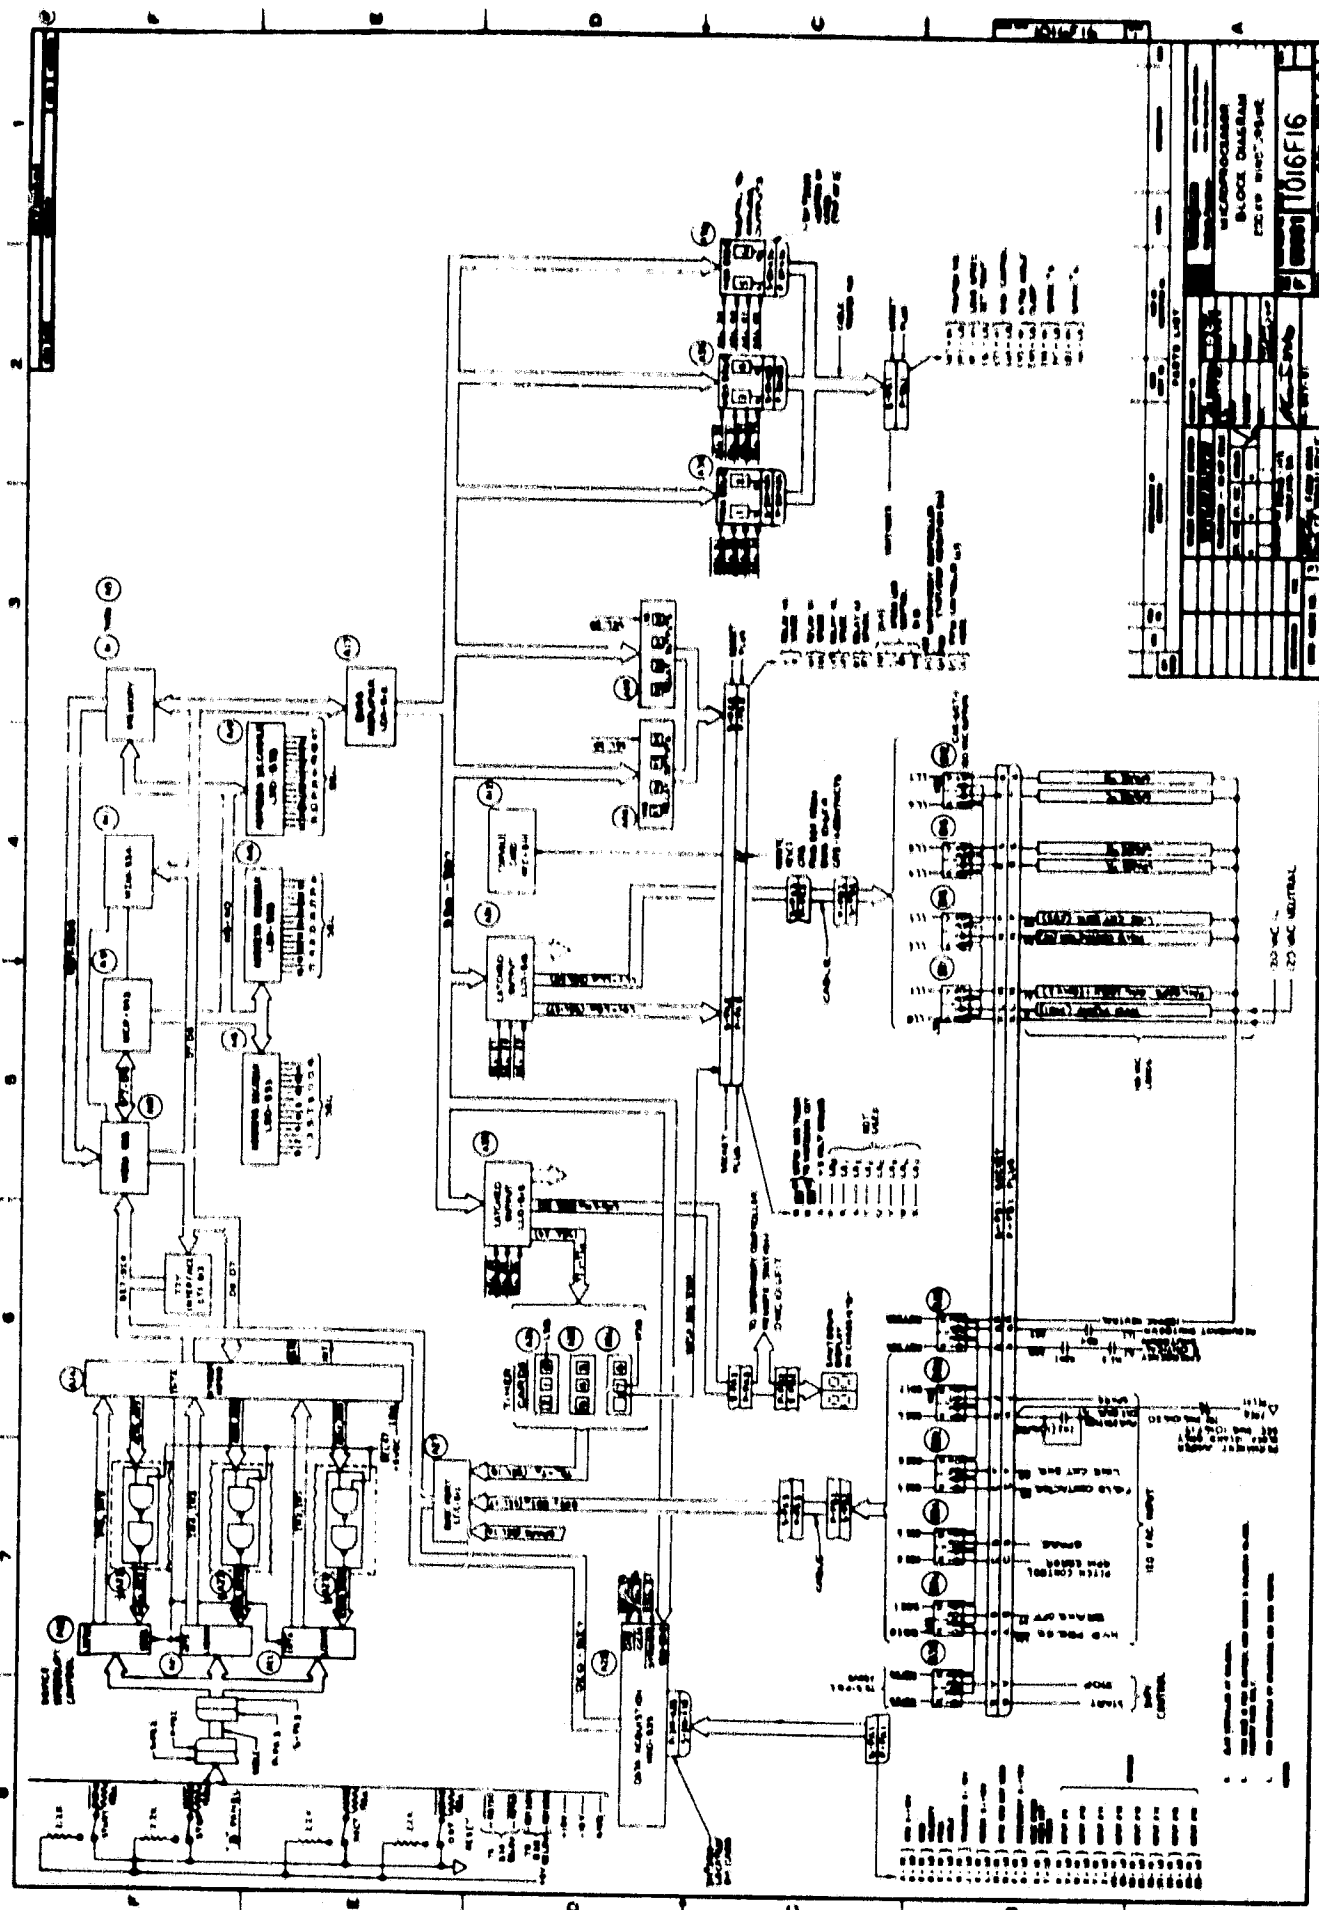

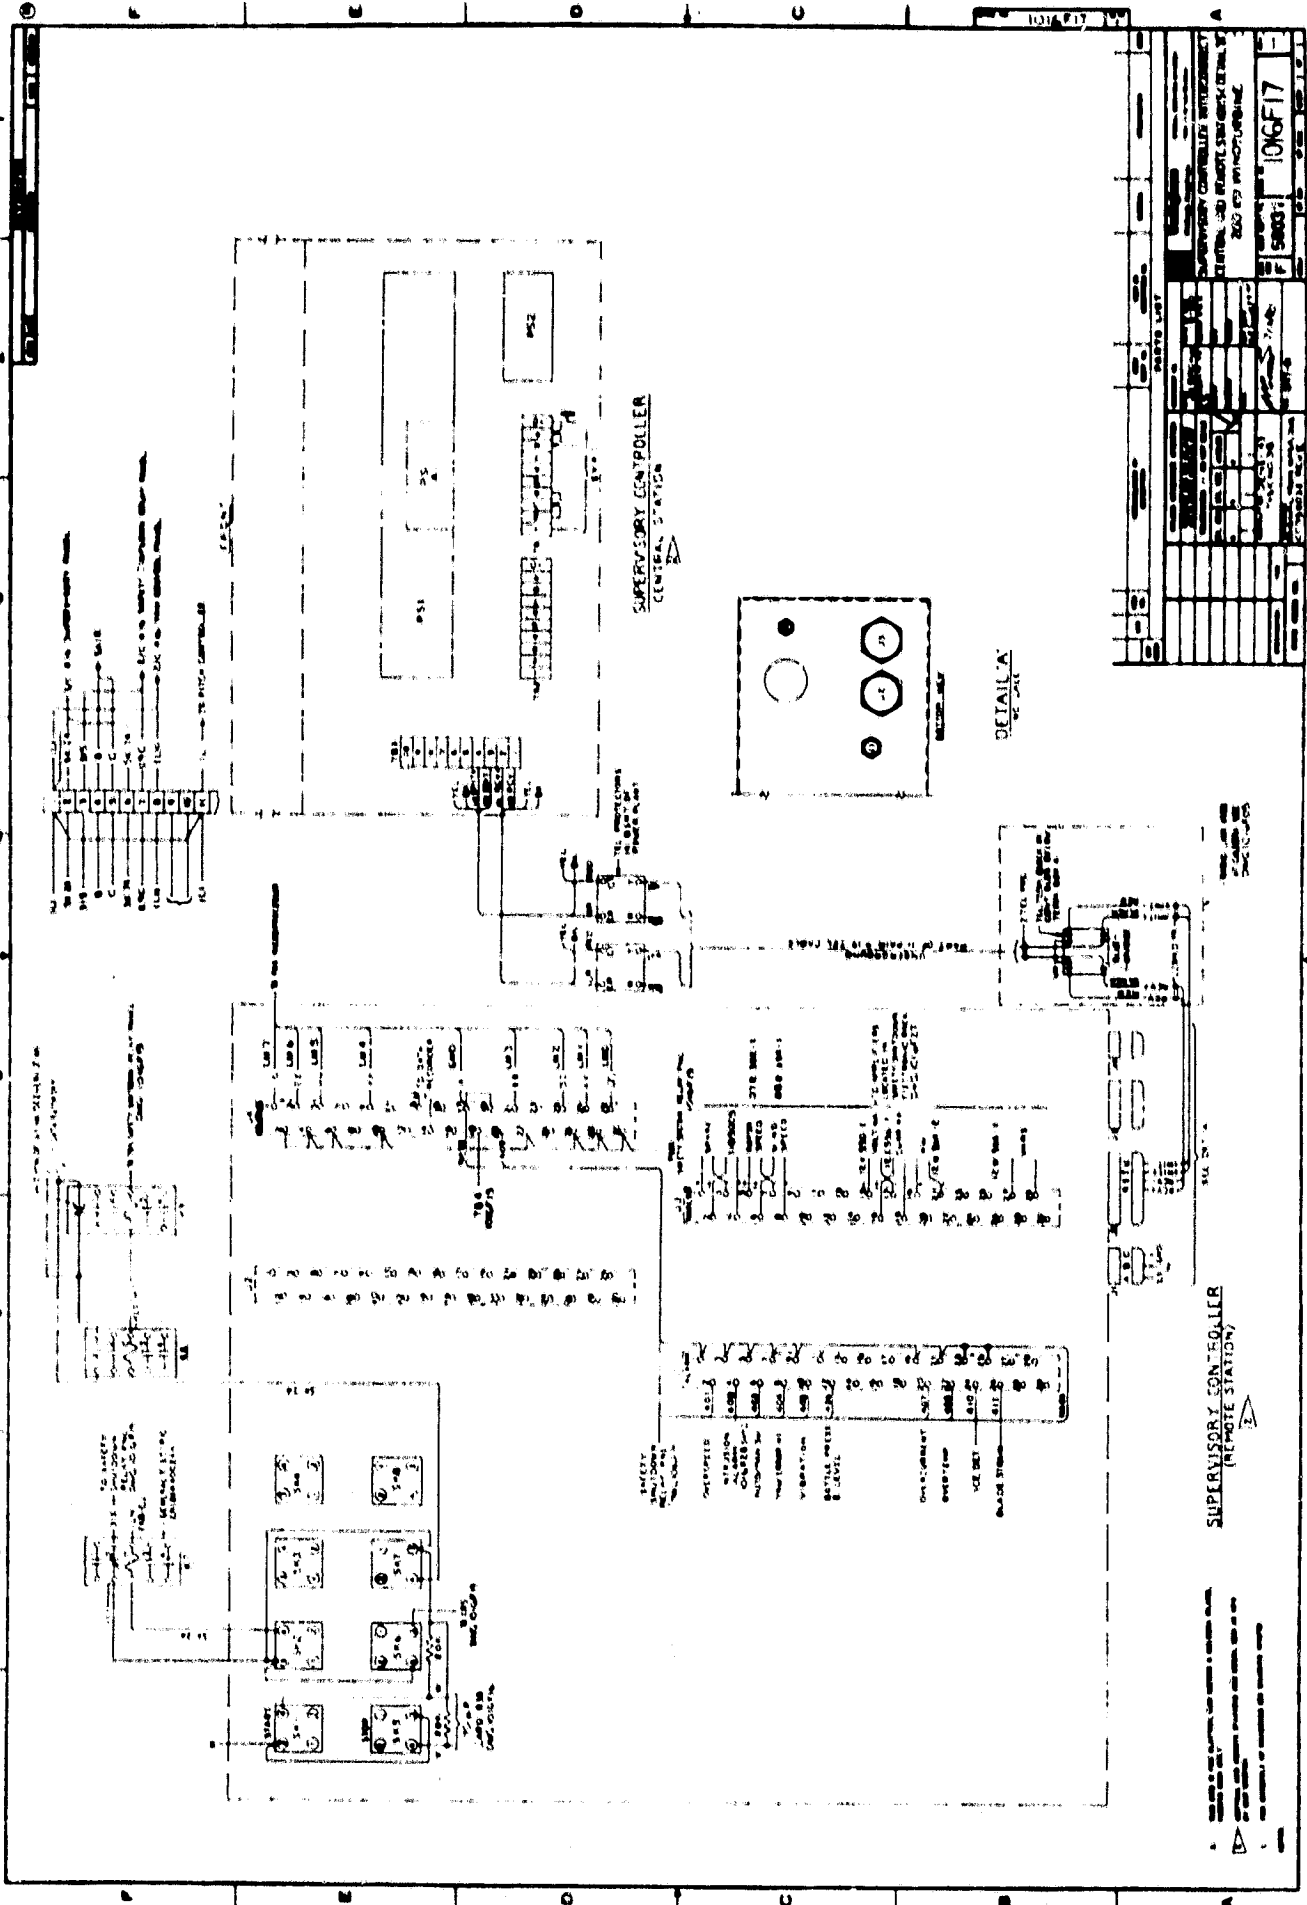

SUPERVISORY CONTROLLER REMOTE STATION	
DATE	10/6/17
BY	5803
REVISION	
DESCRIPTION	
APPROVED	
CHECKED	
DESIGNED	
DRAWN	
TESTED	
ASSEMBLED	

SUPERVISORY CONTROLLER
(REMOTE STATION)

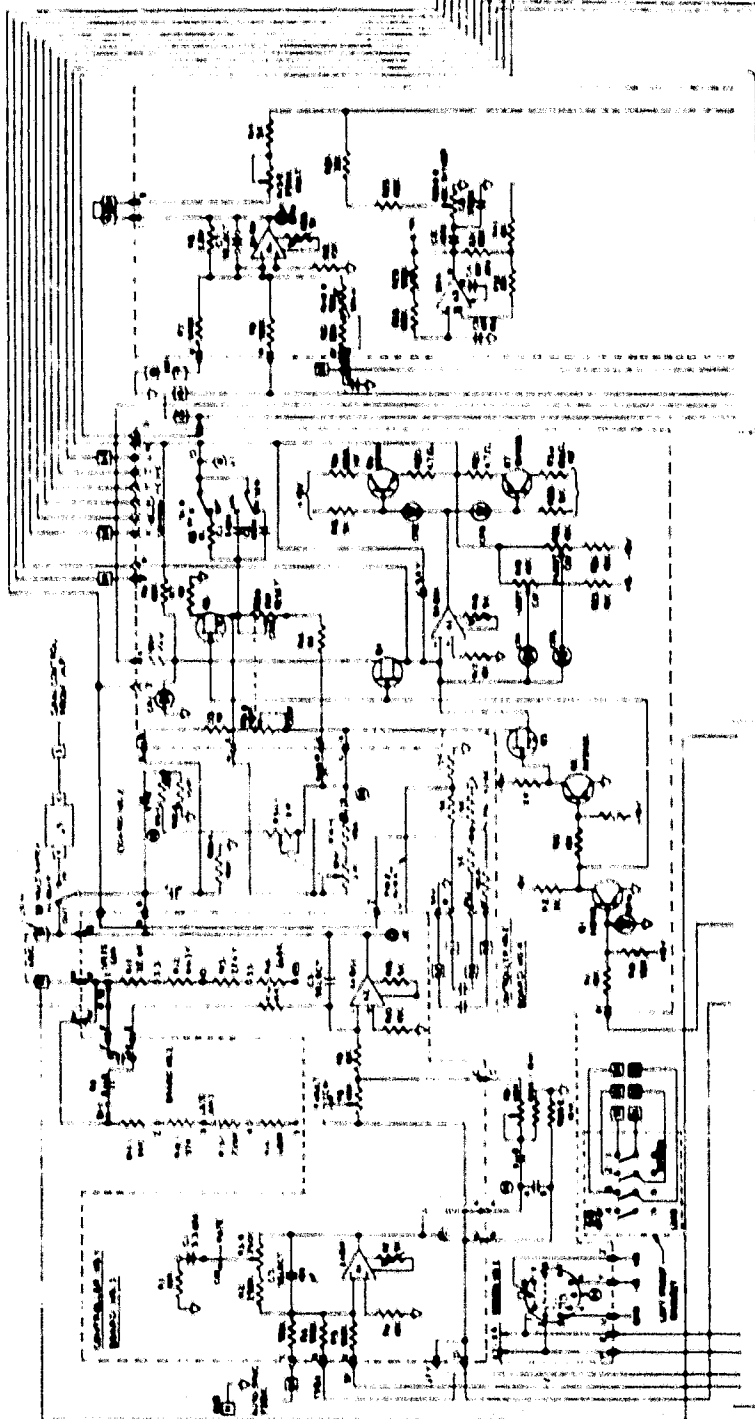


CONTINUED ON SHEET 2




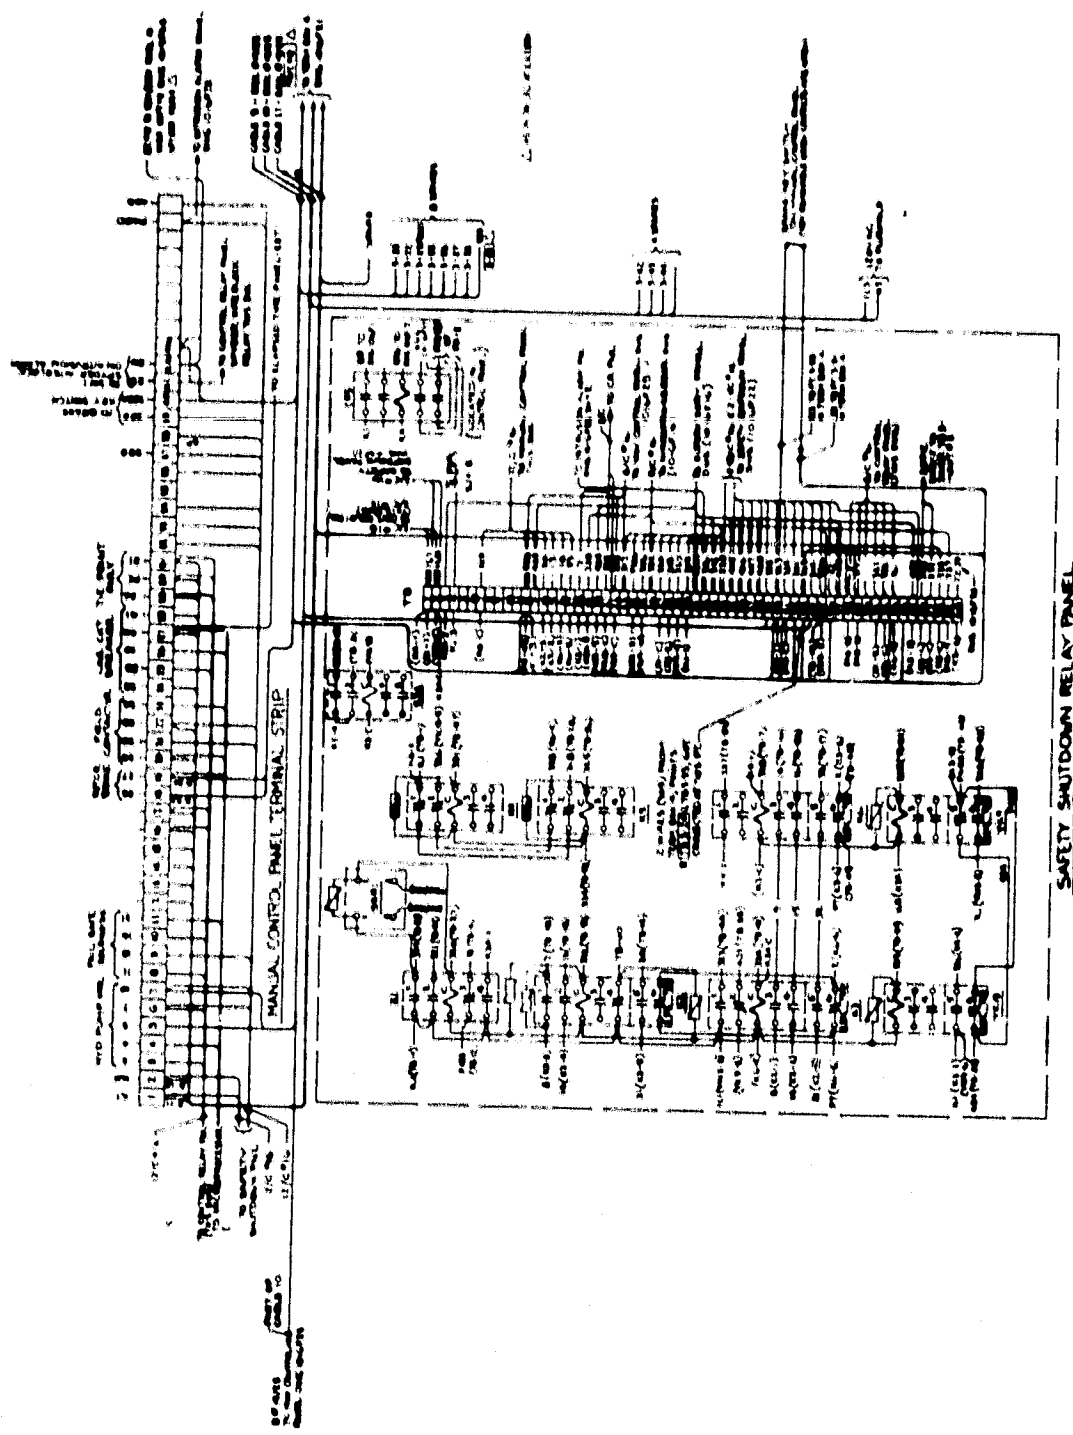


SAFETY SHUTDOWN RELAY PANEL

216



[illegible]

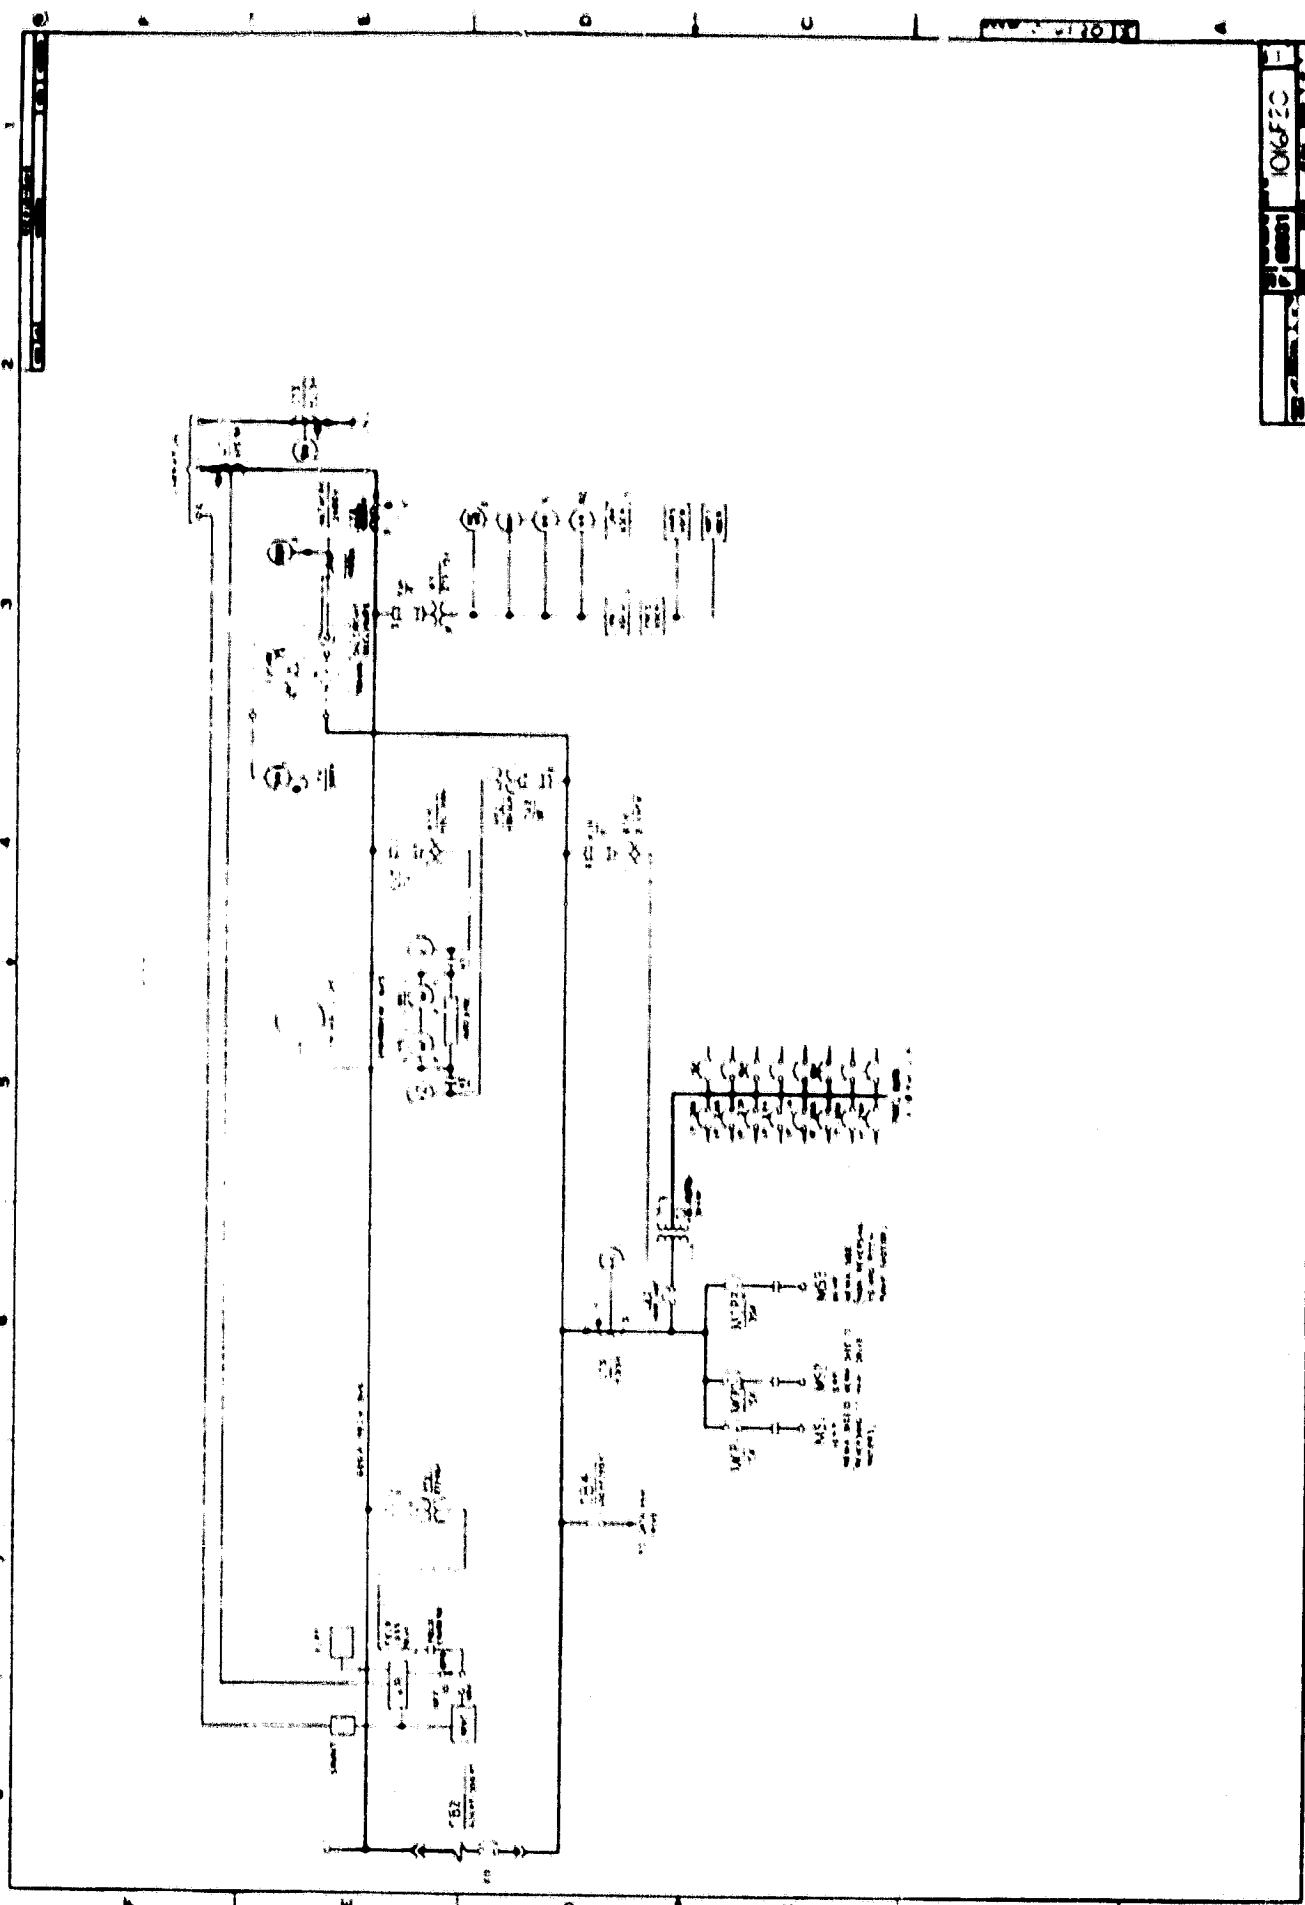


100V 50Hz

100V 50Hz

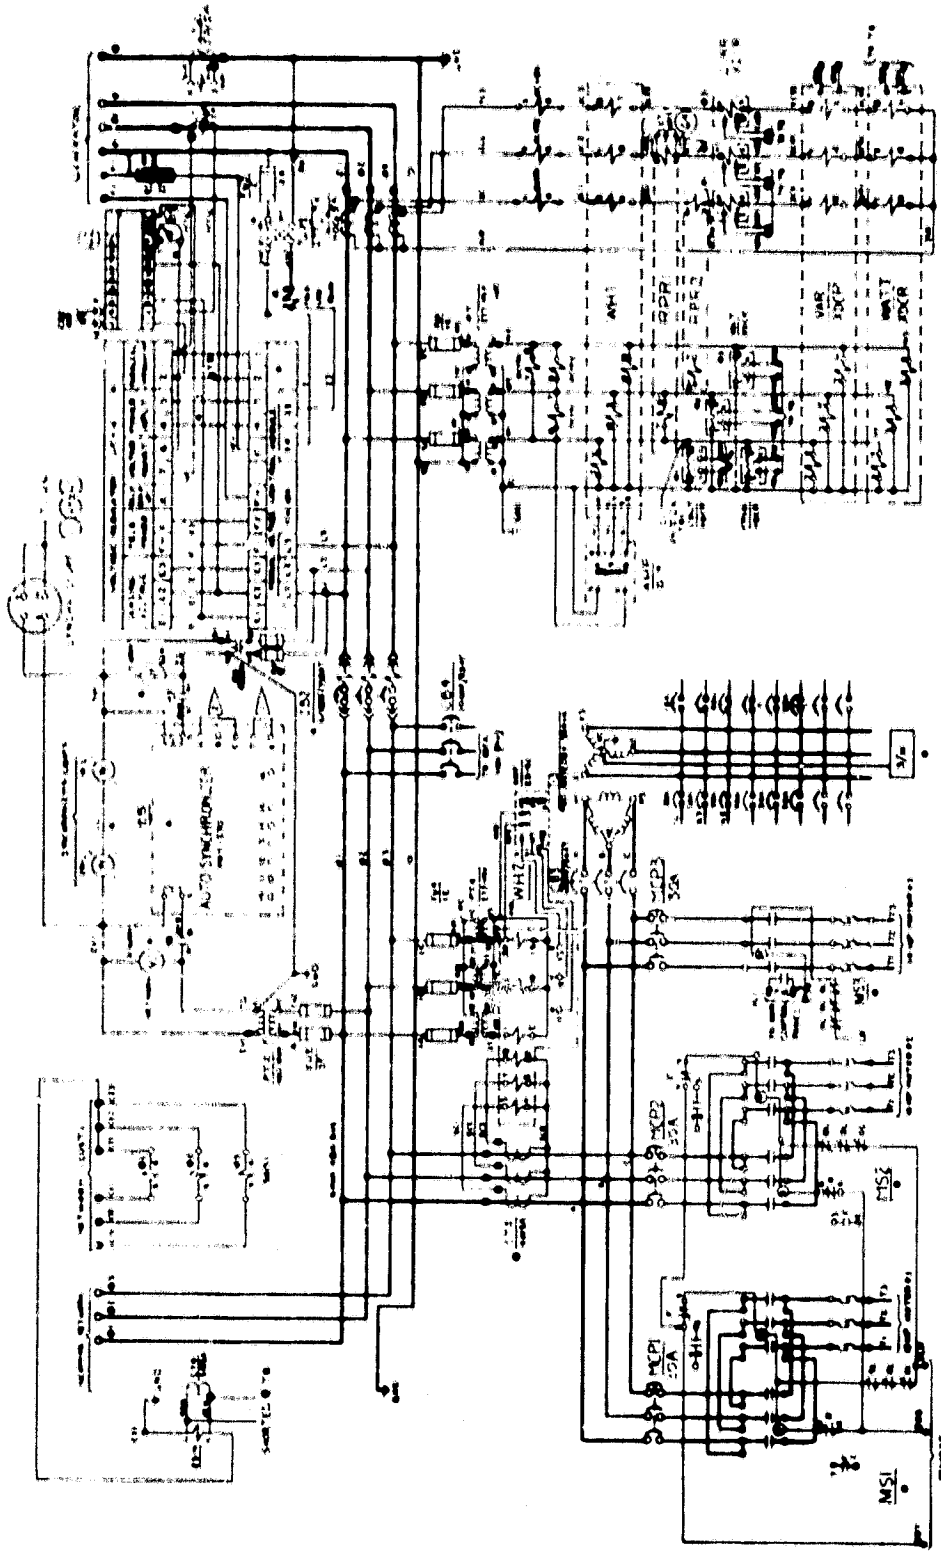


ORIGINAL PAGE IS
OF POOR QUALITY

340

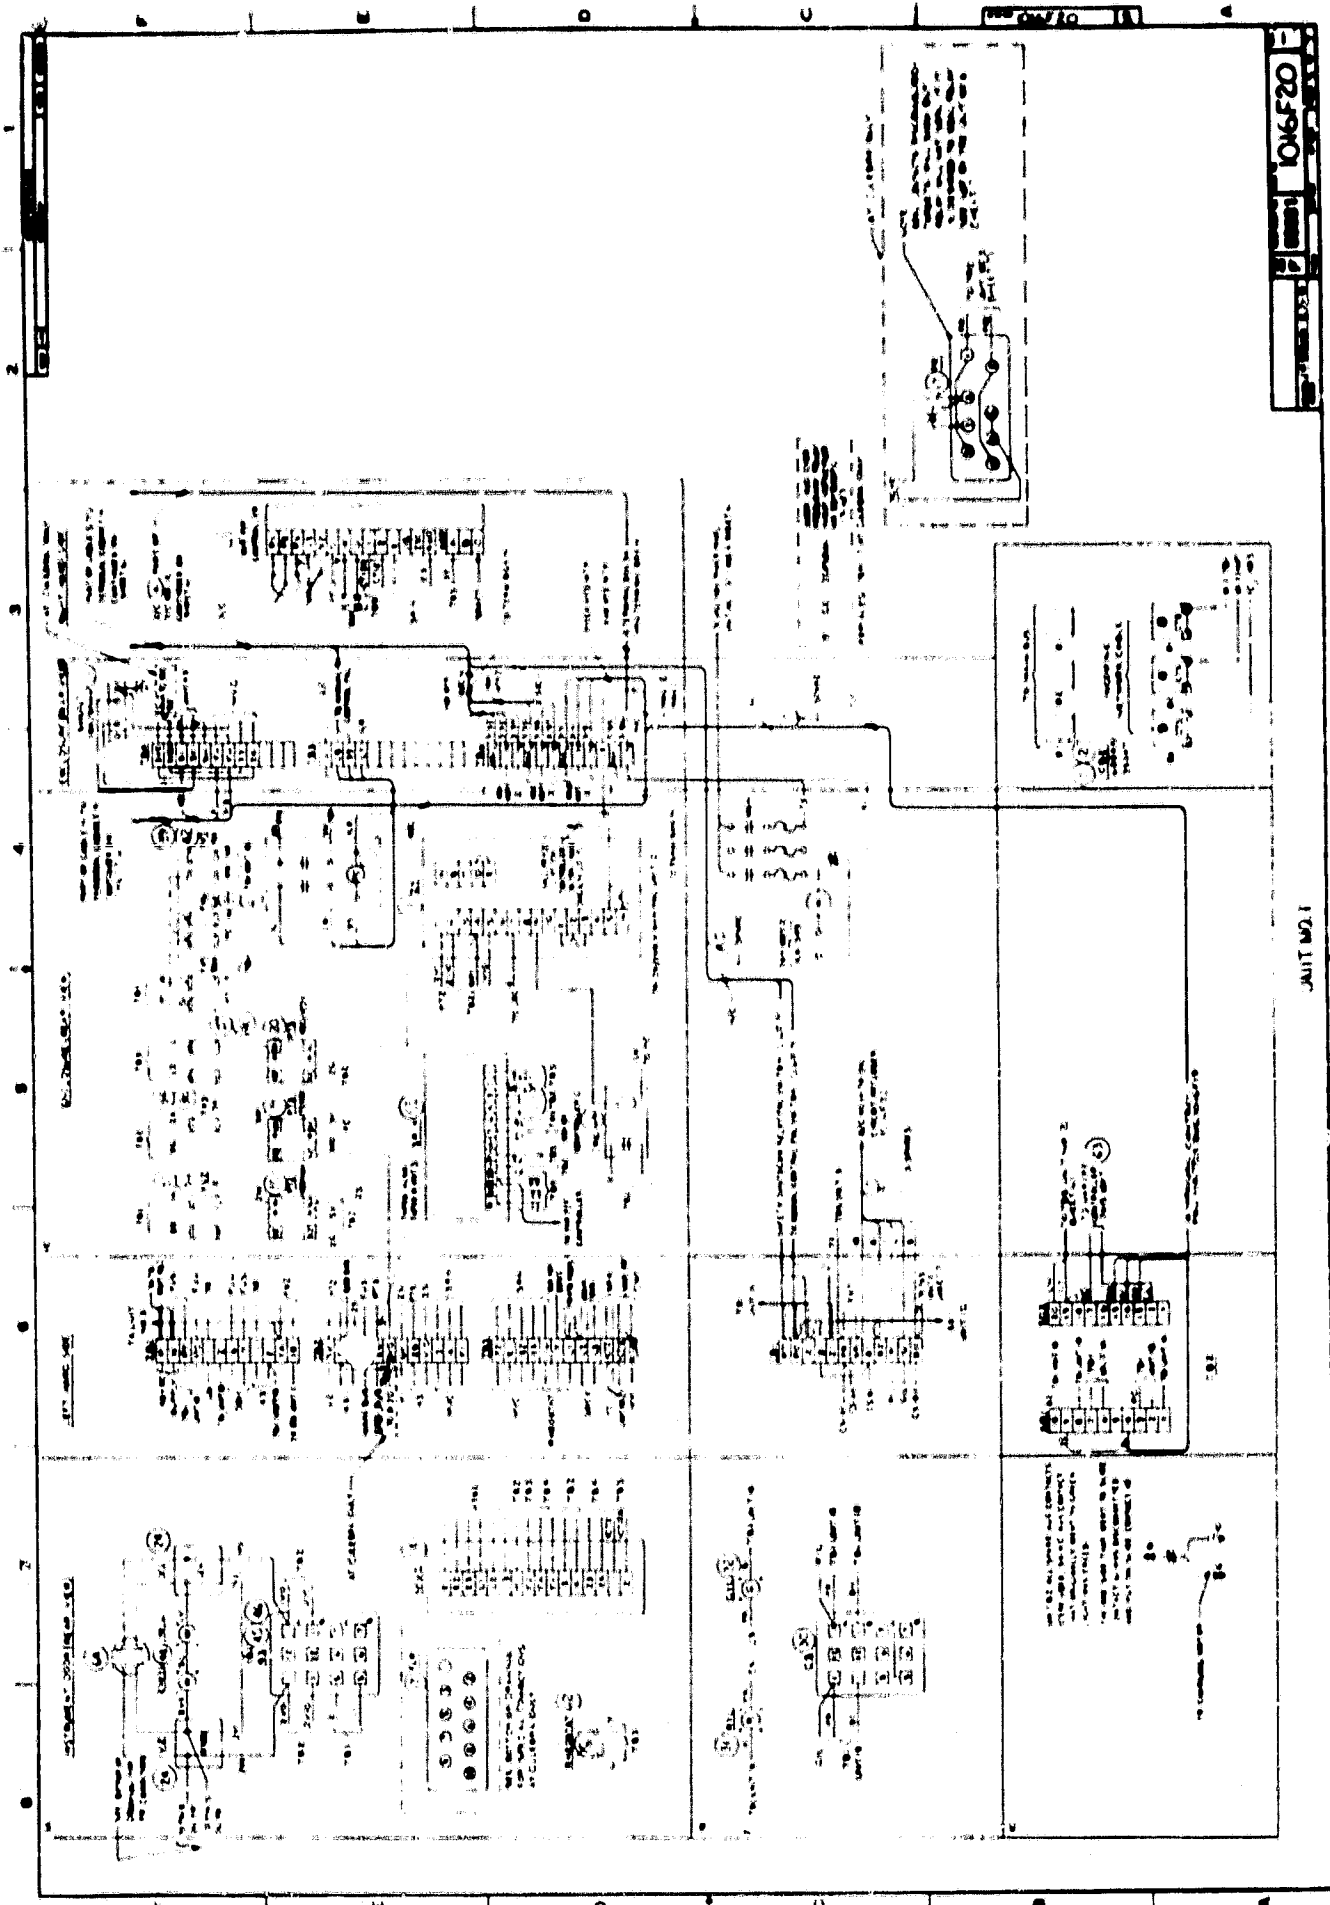


106F20

JUNIT NO. 1

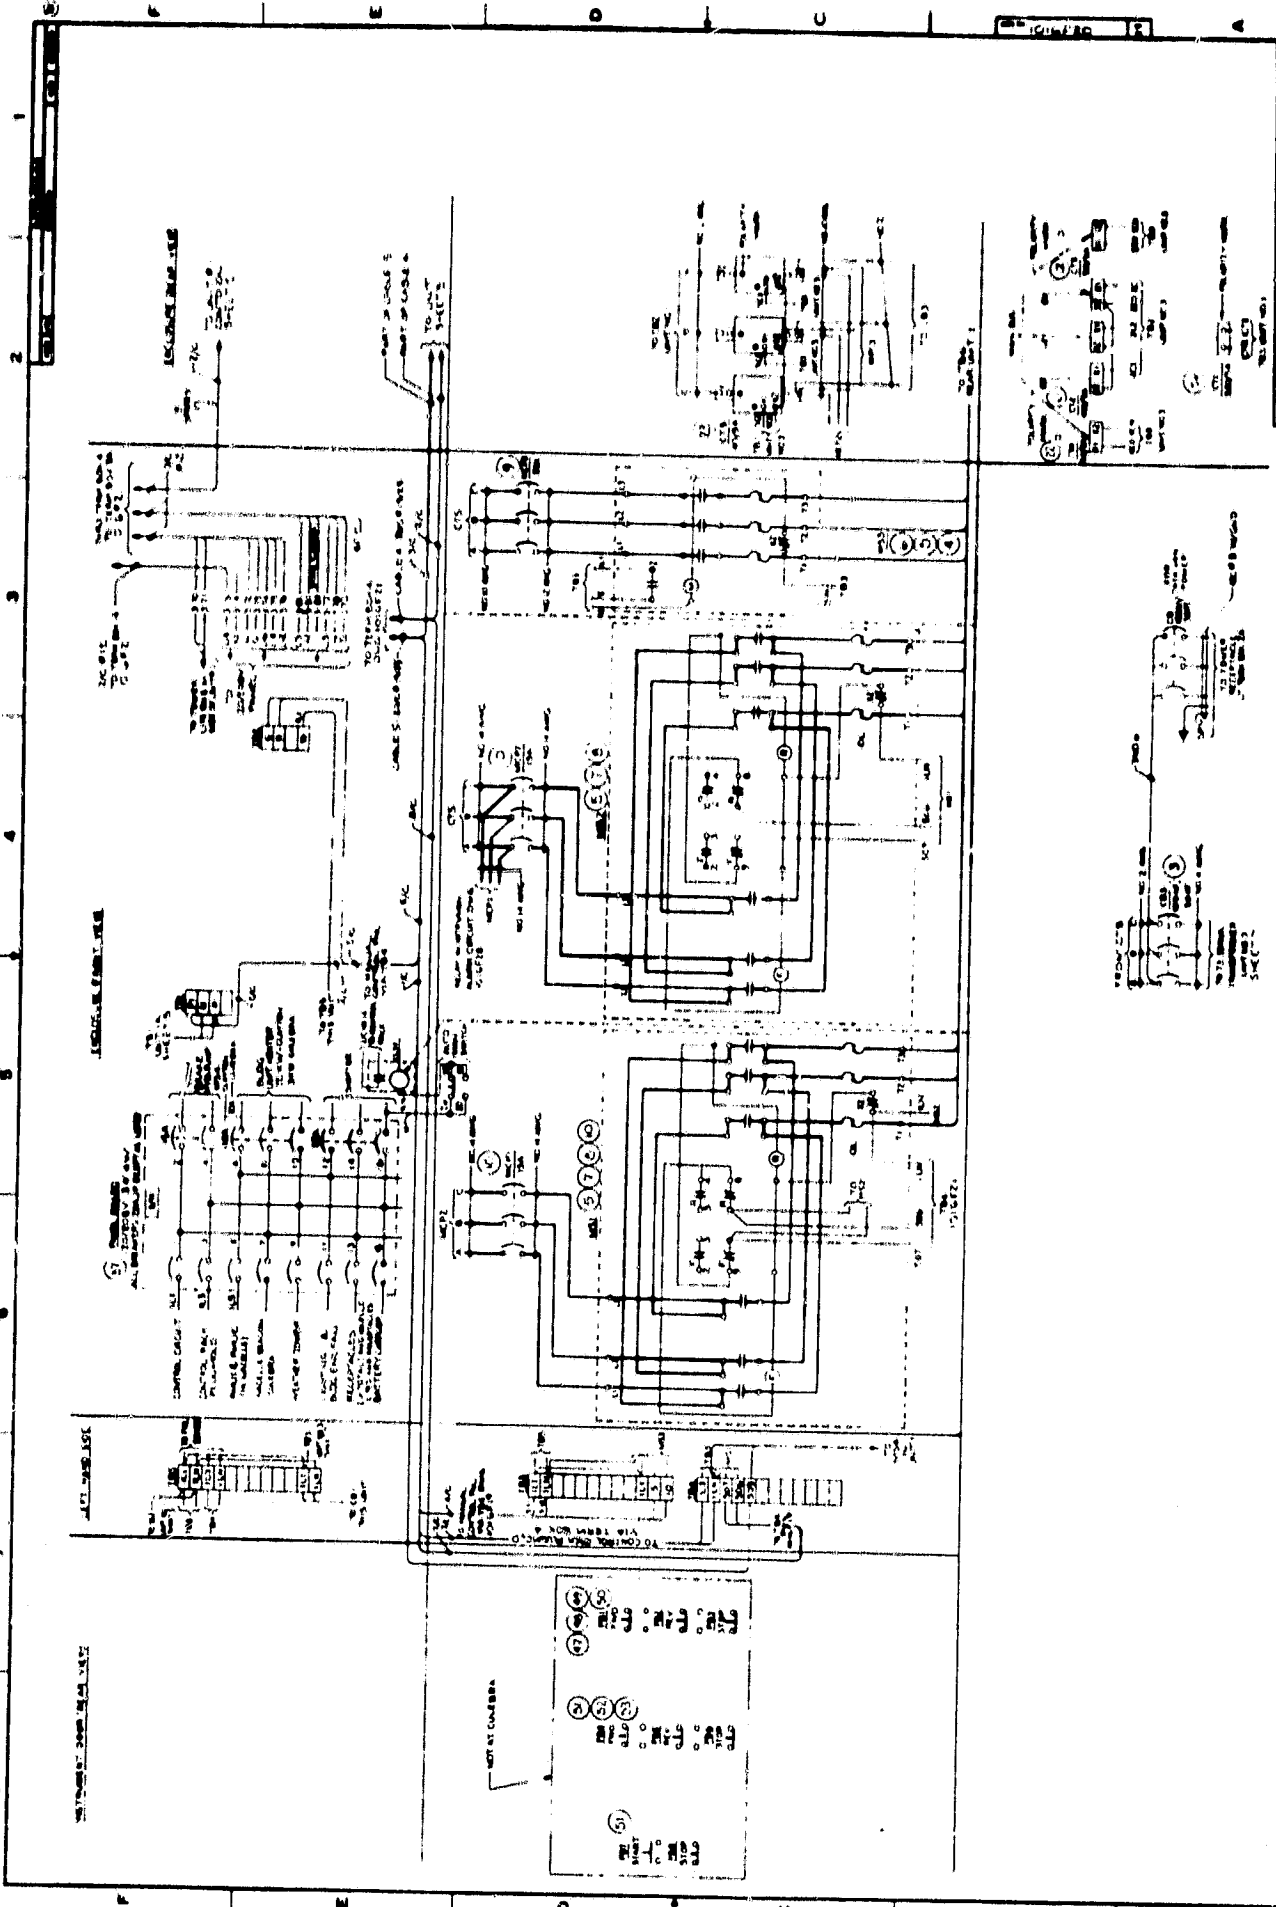

UNIT NO. 2


UNIT NO. 2

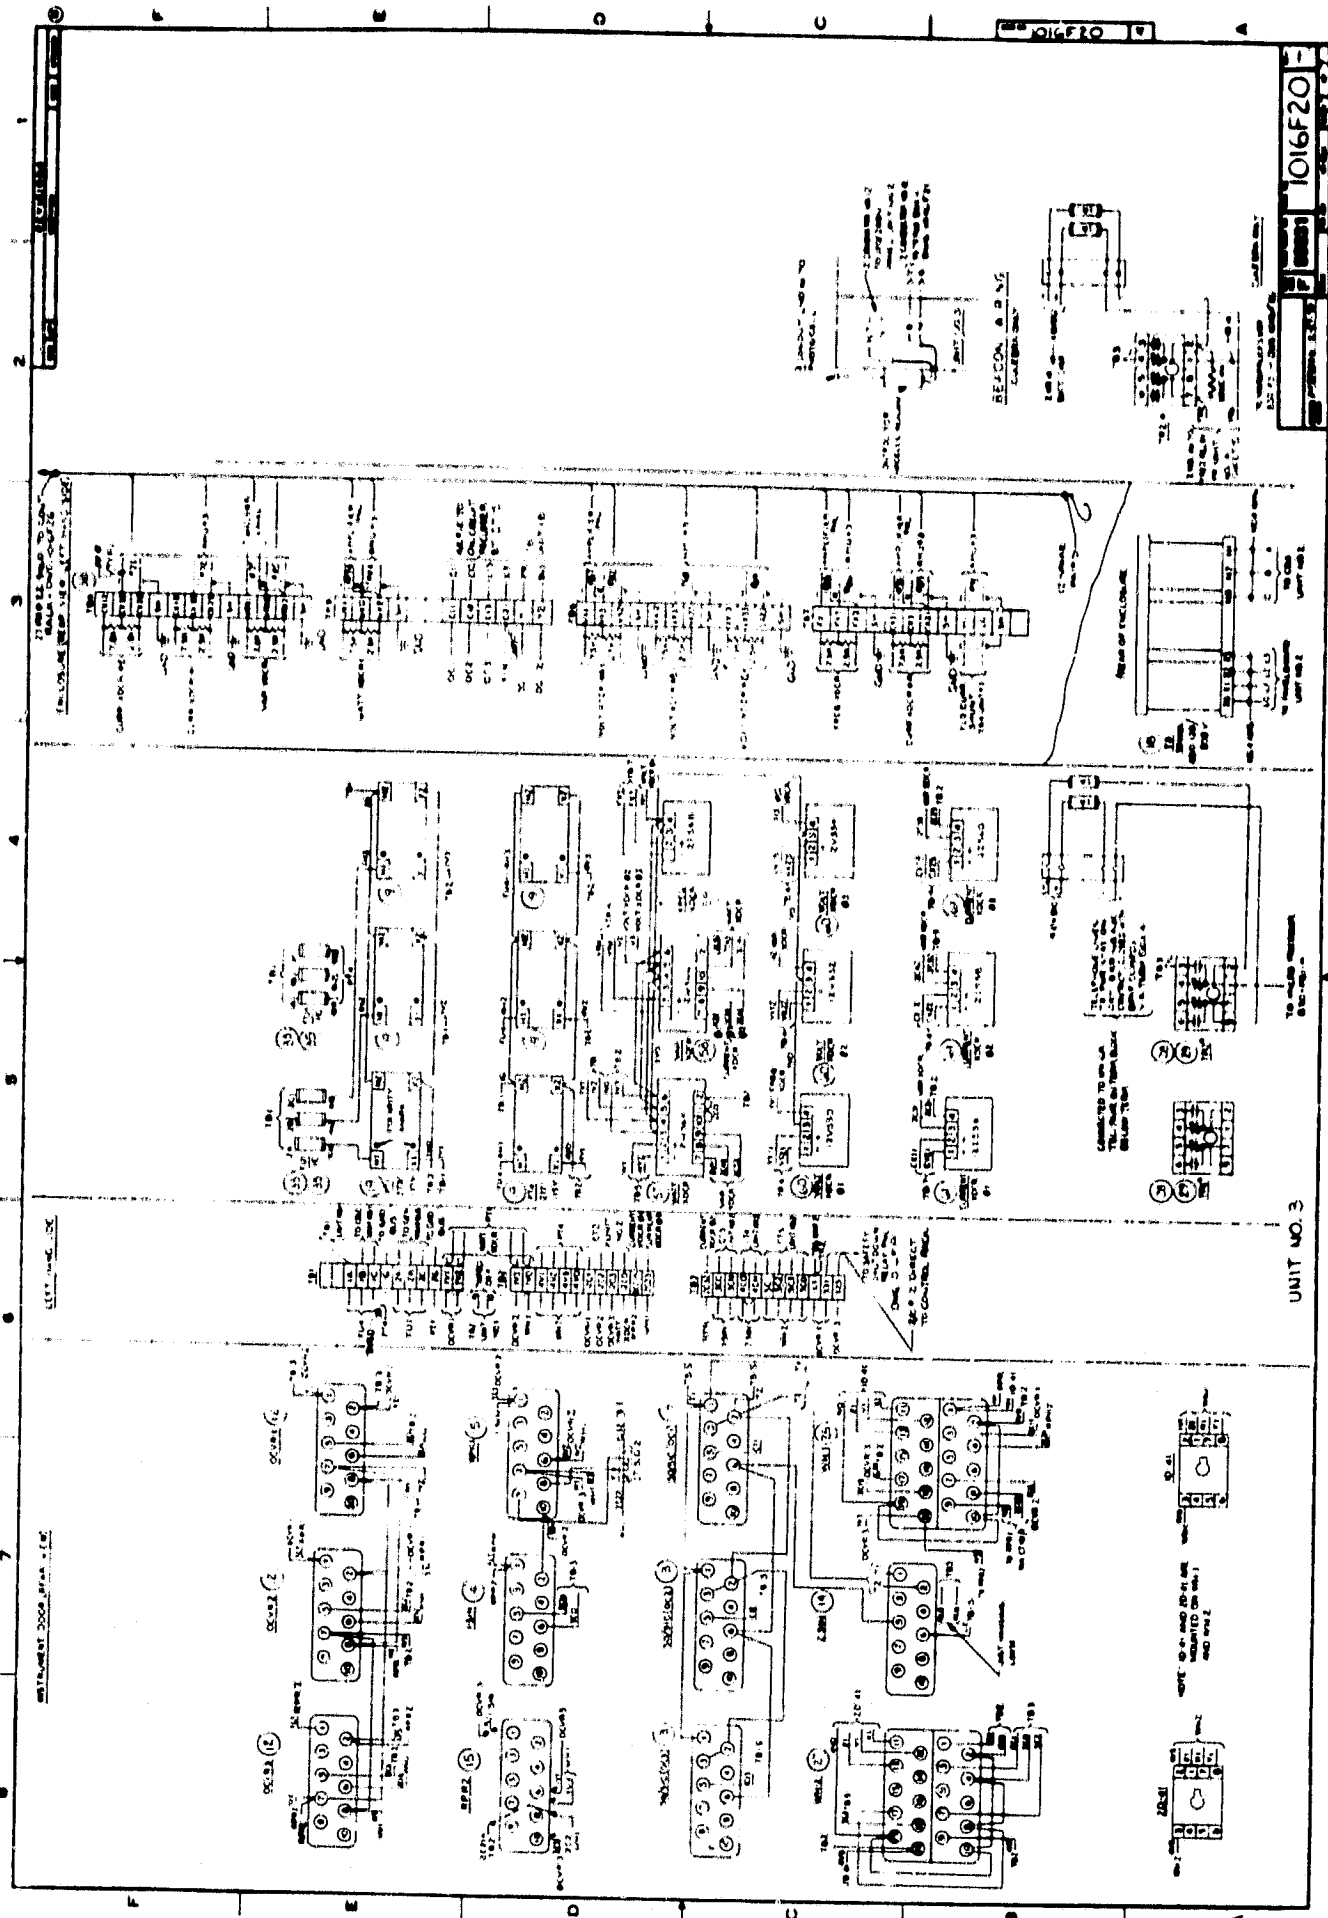


UNIT NO. 3

1016F20


1016F20

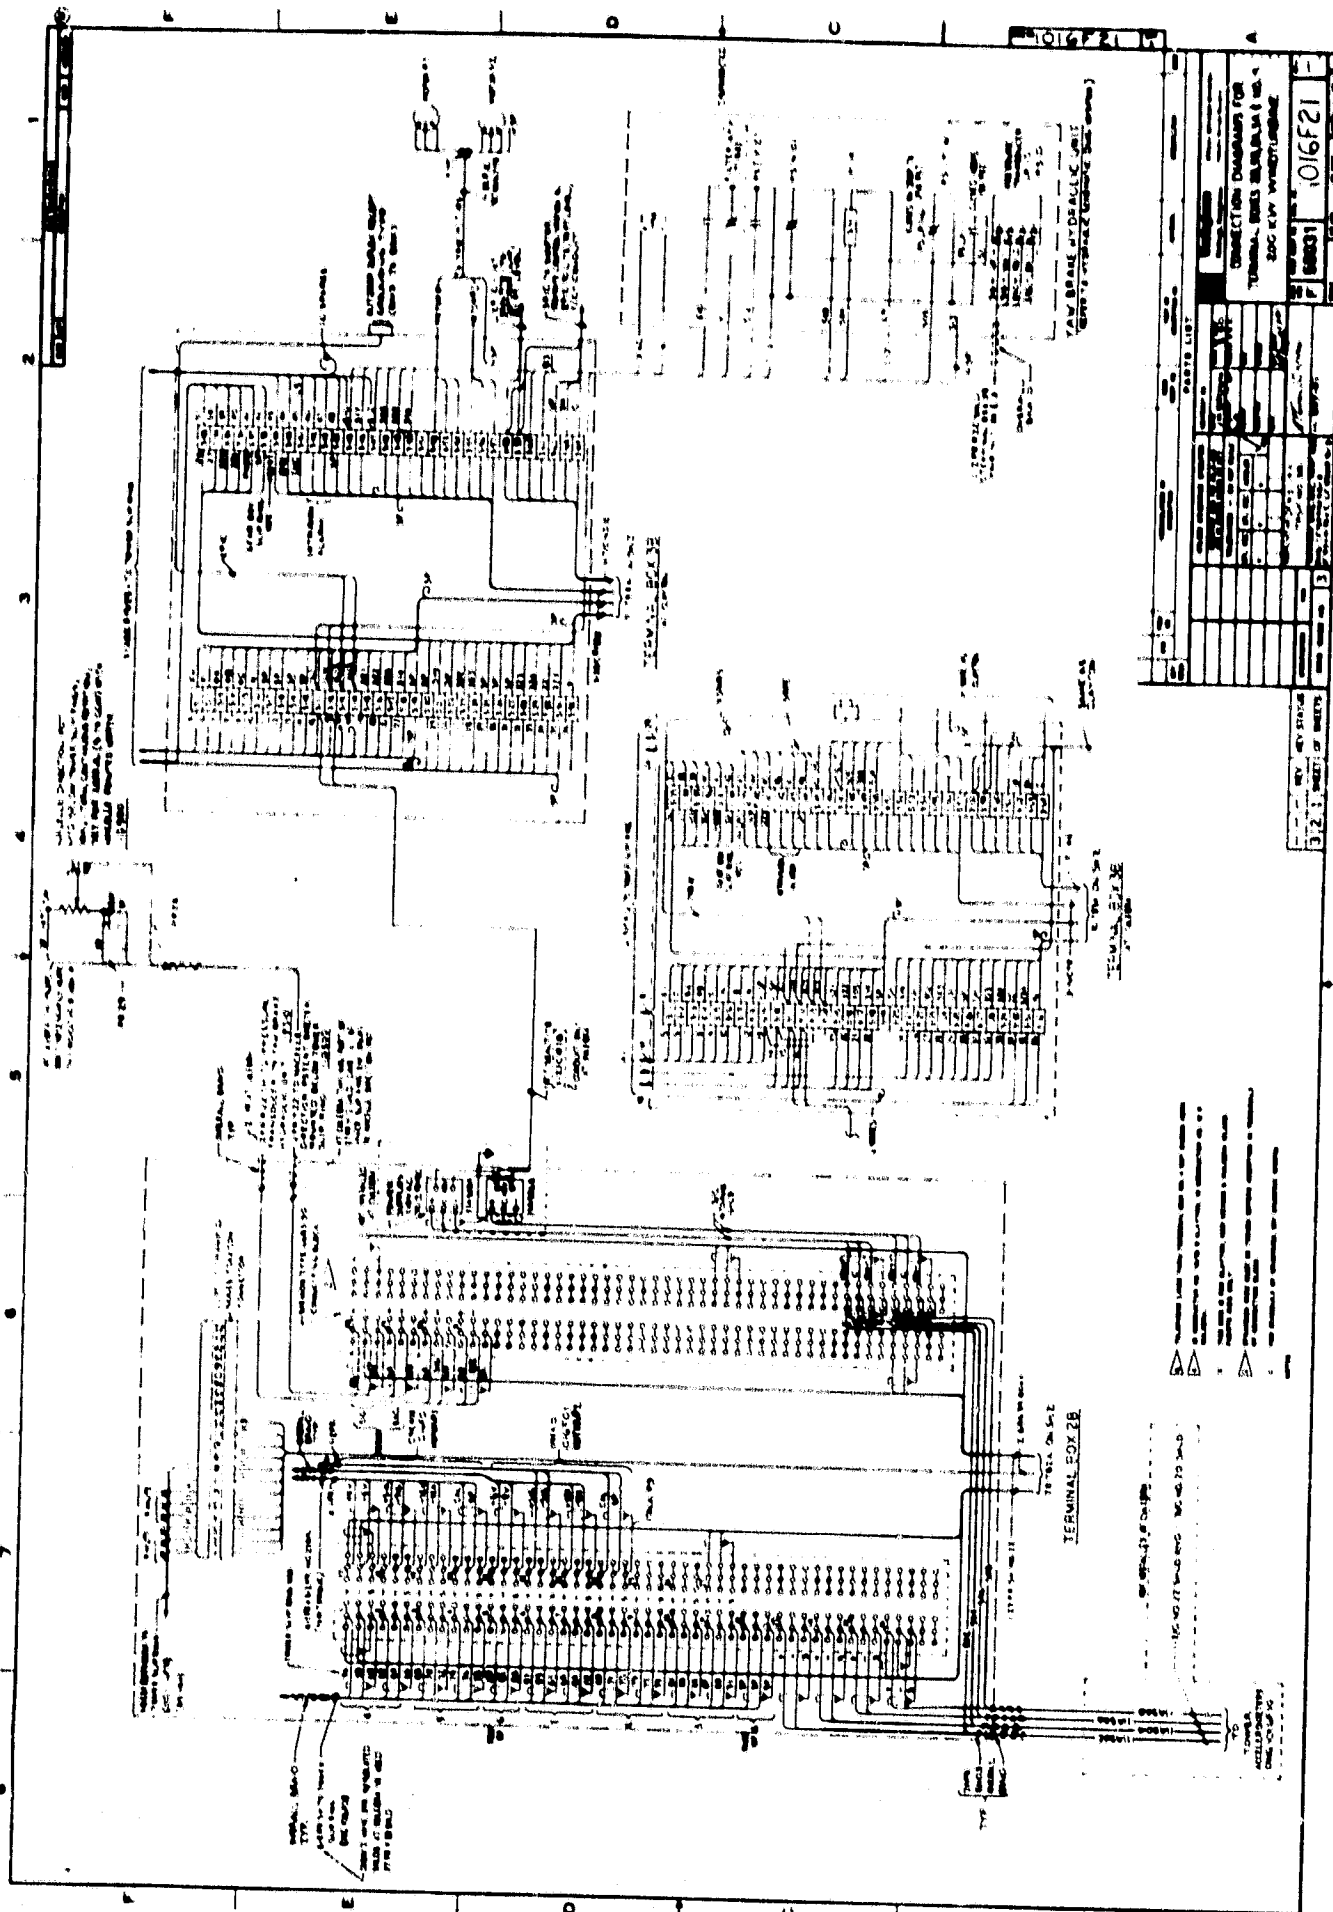

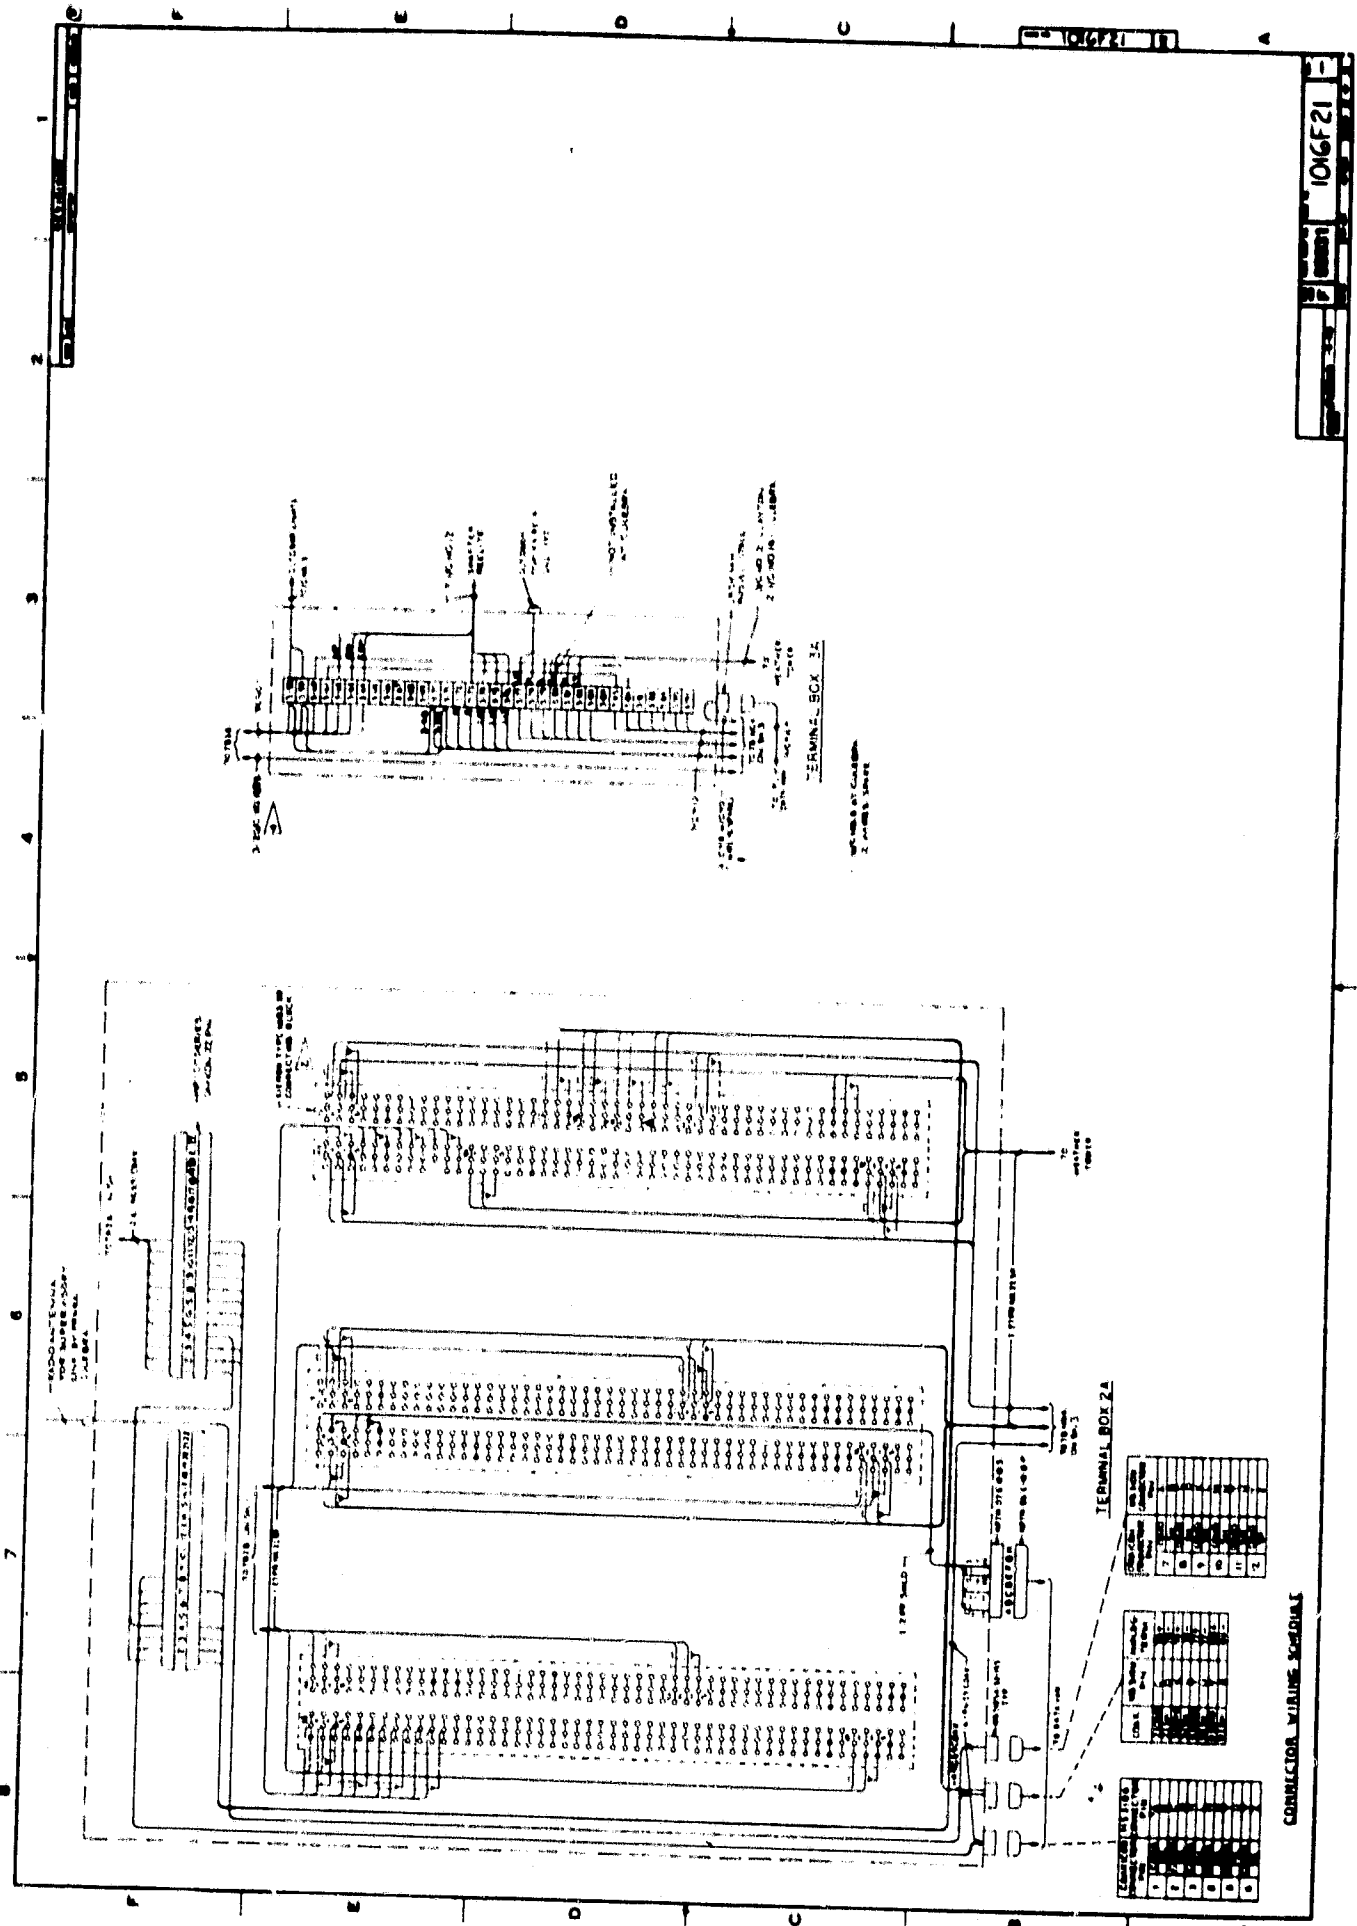


106GF21


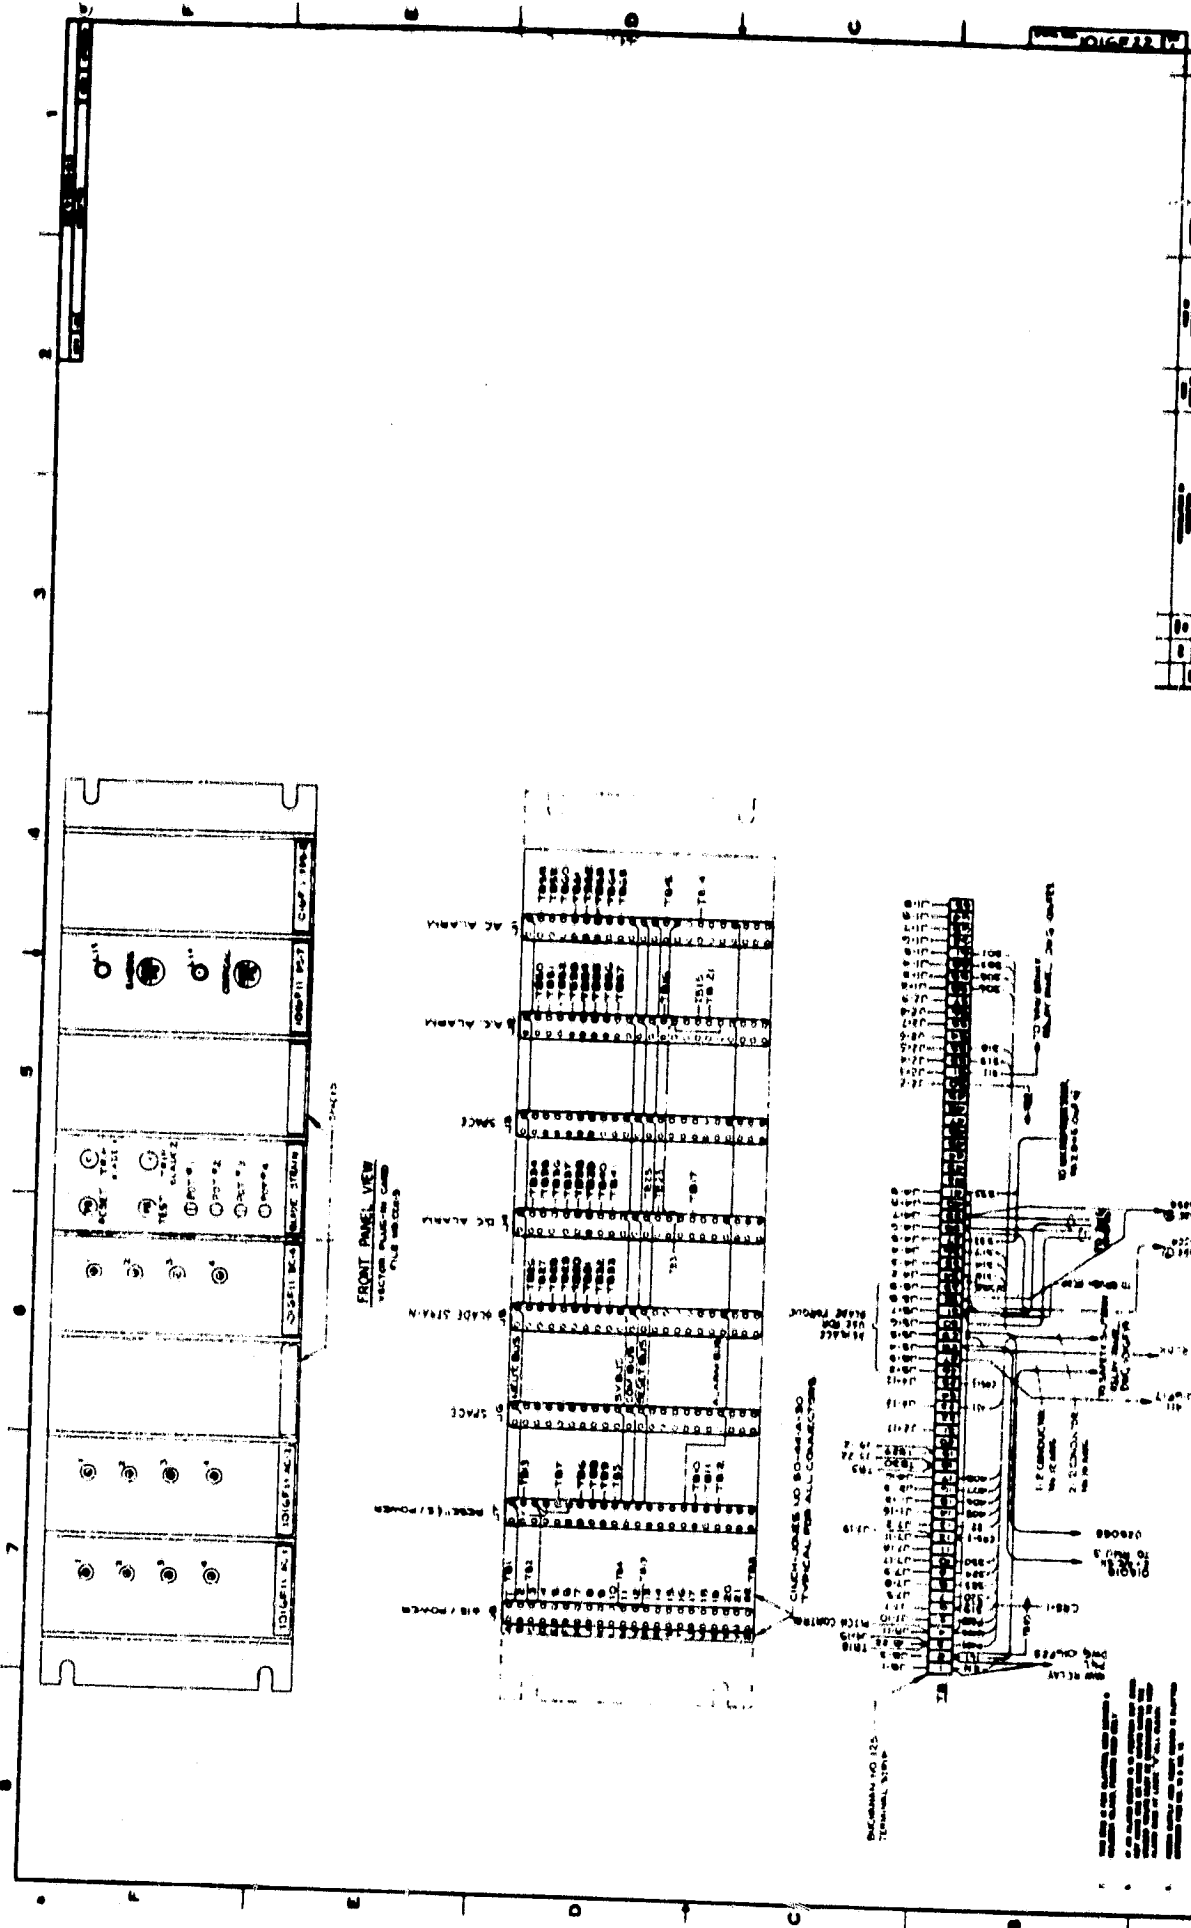



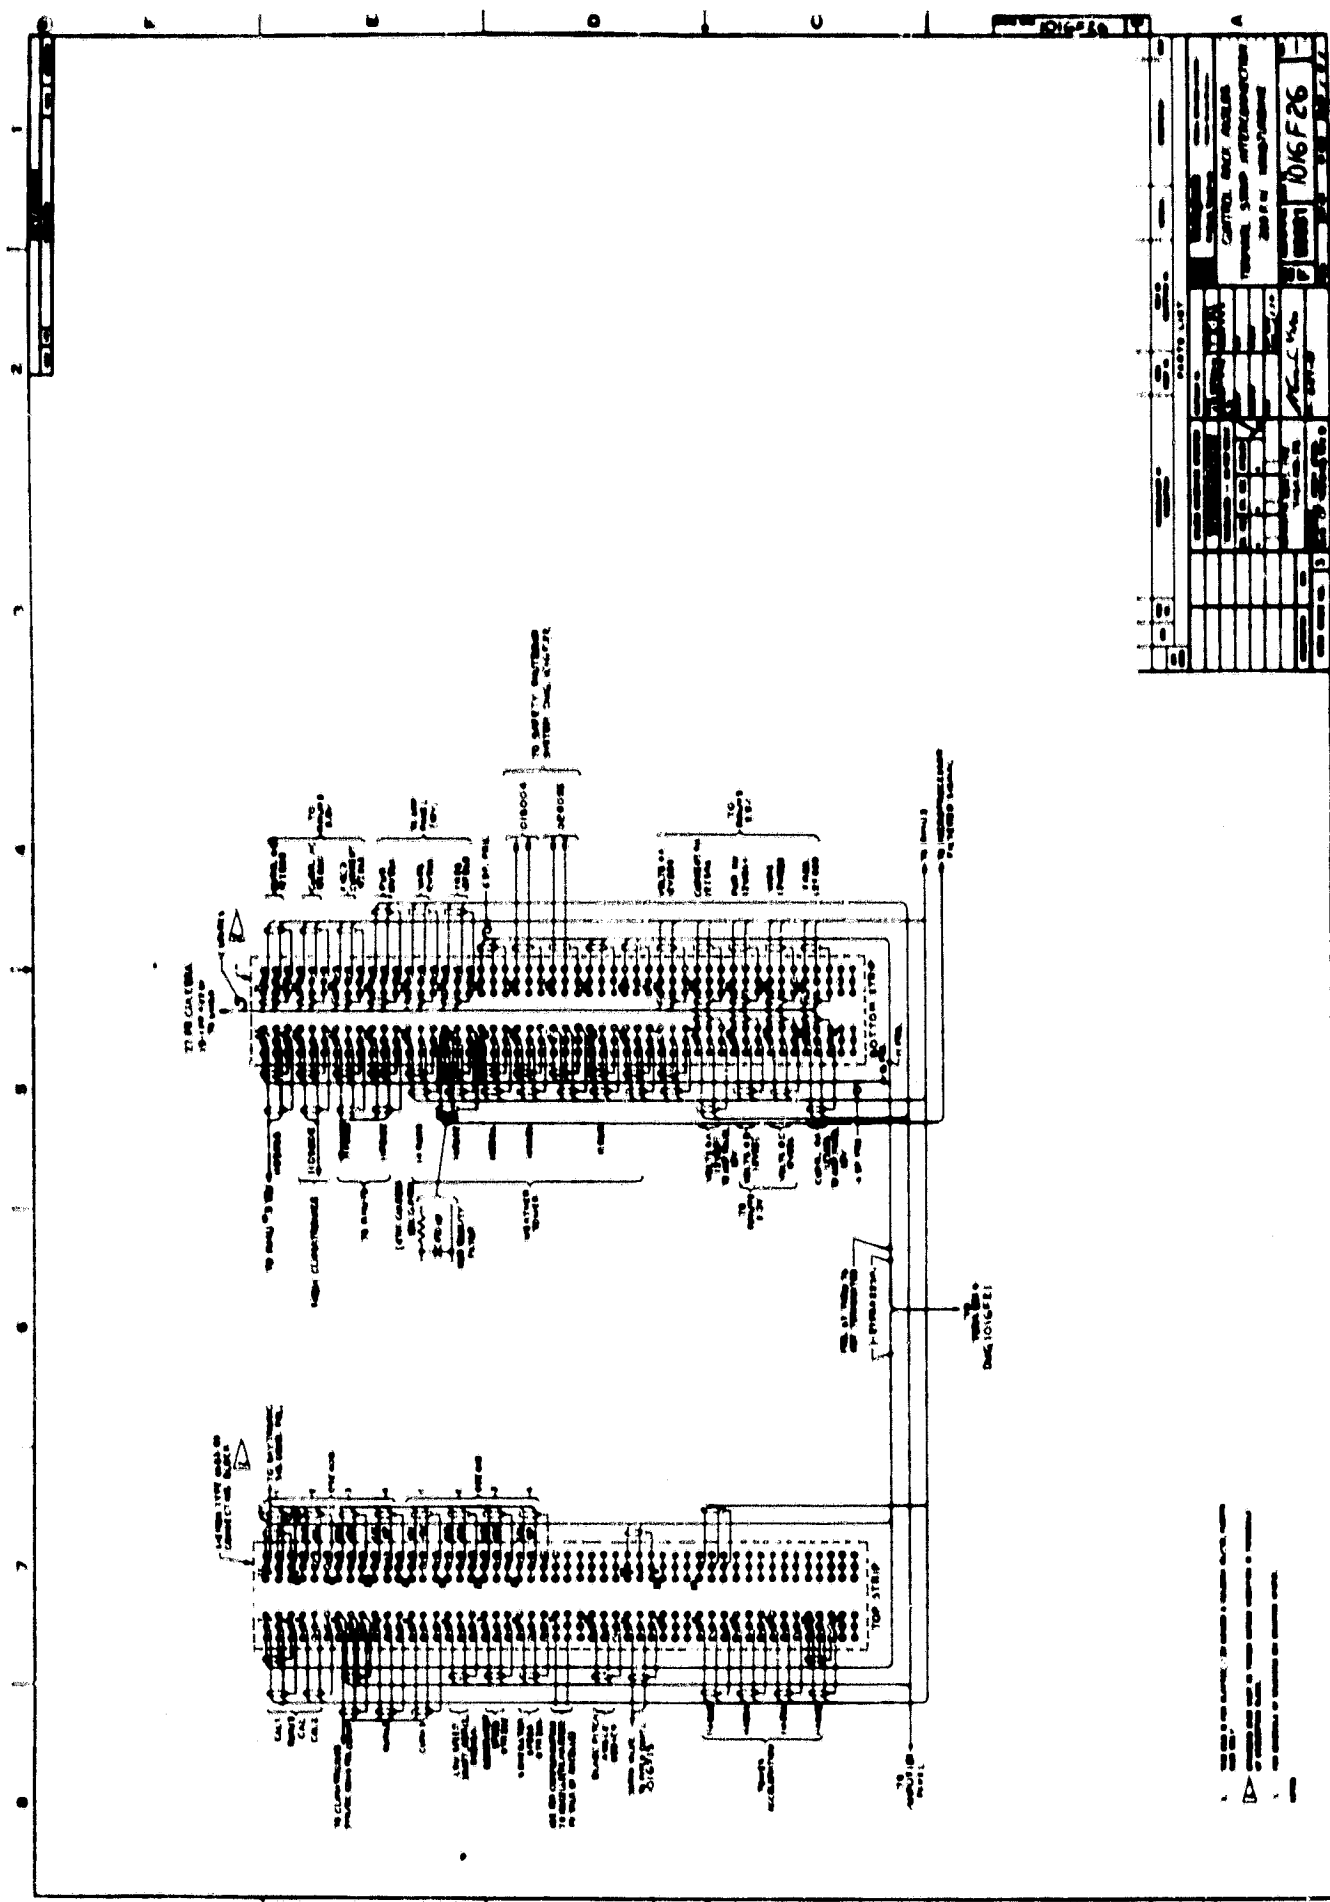


POSTS LIST		DATE		BY	
1	2	3	4	5	6


[illegible][illegible]

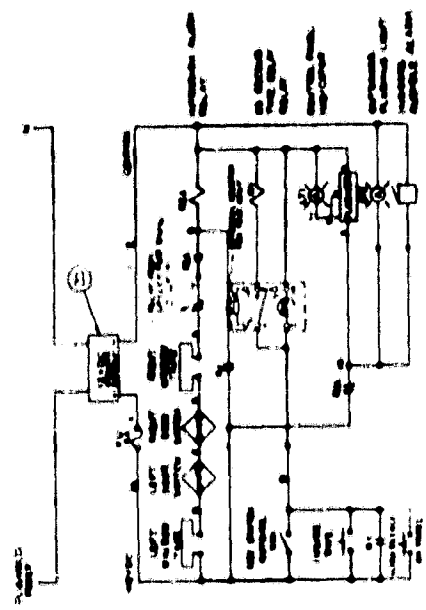


INTRUSION ALARM ELEMENTARY CIRCUIT

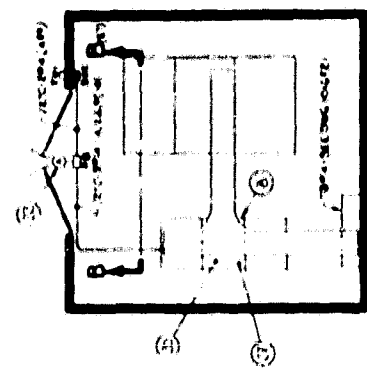

PLAN VIEW

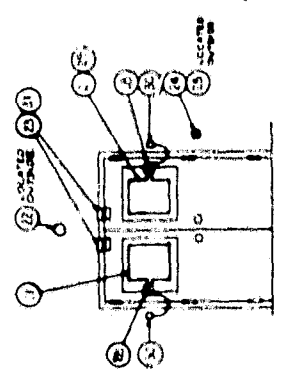


PLAN VIEW

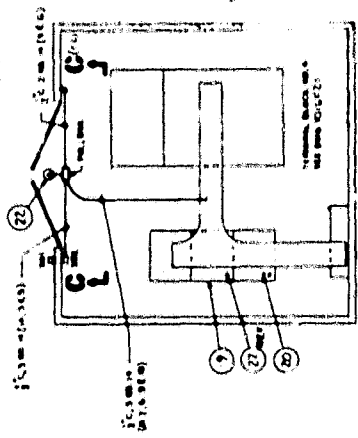

PLAN VIEW

SCALE 1" = 1'-0"

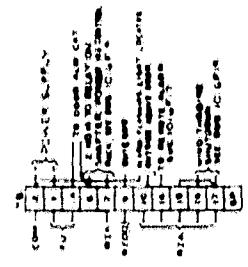


TERMINAL CONNECTIONS

GROUP NO.	PART NO.
1	10167200-1
2	10167200-2




CROSS LAYOUT
SCALE -

CROSS LAYOUT
SCALE -

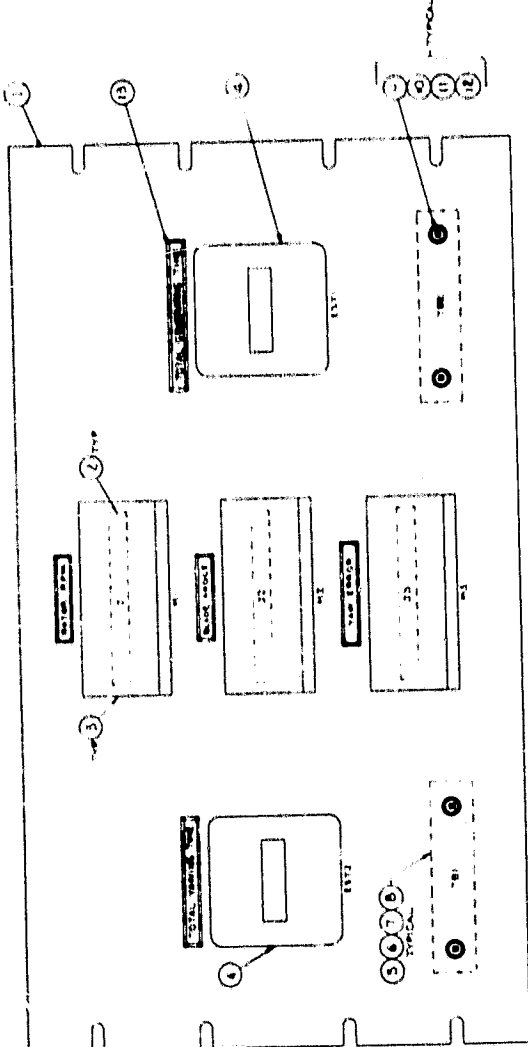



PANEL ASSEMBLY
FRONT VIEW

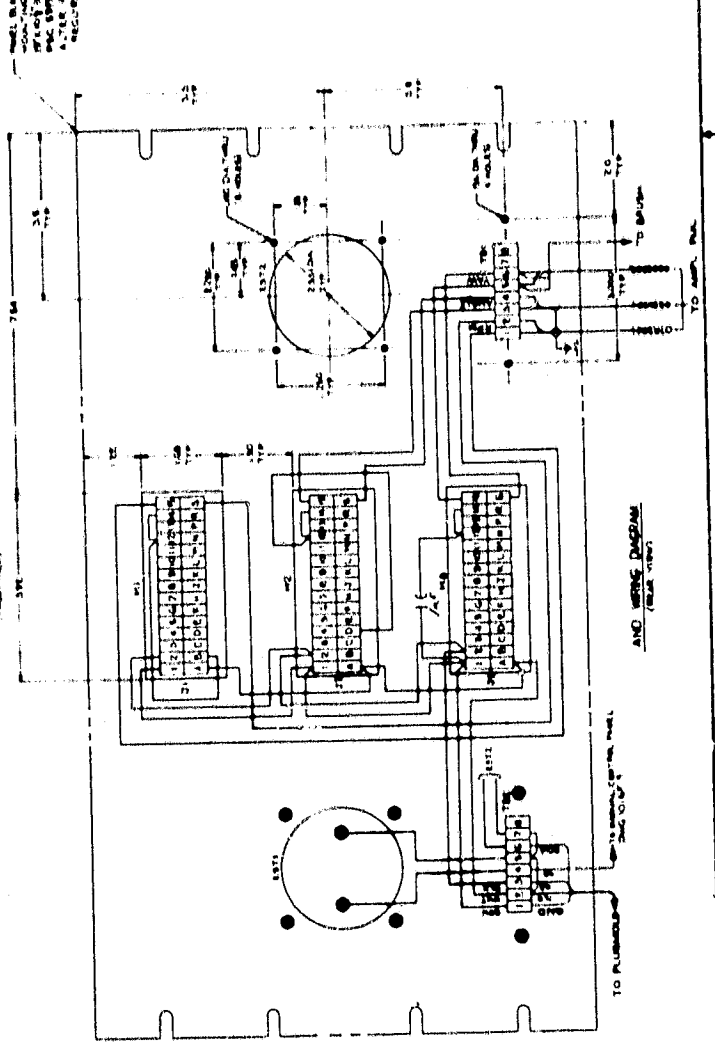


AND WIRING DIAGRAM
(REAR VIEW)



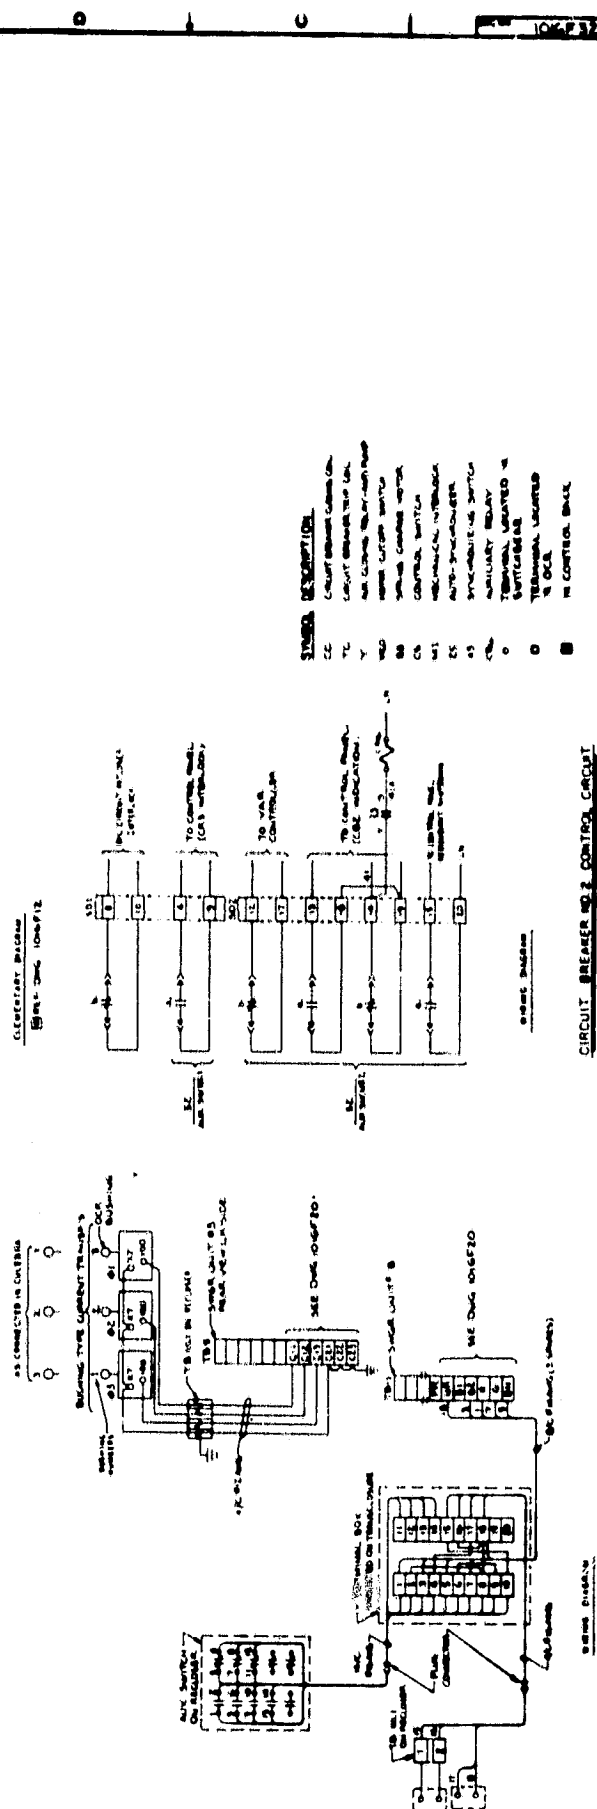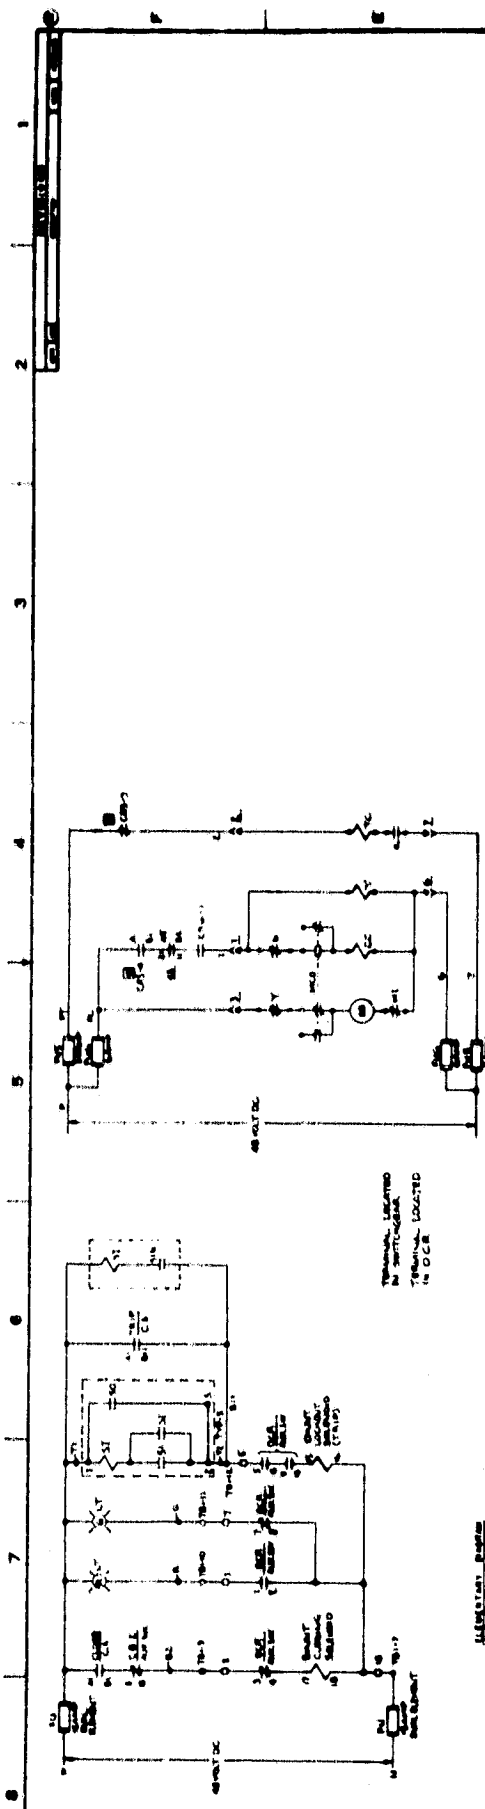
[illegible]

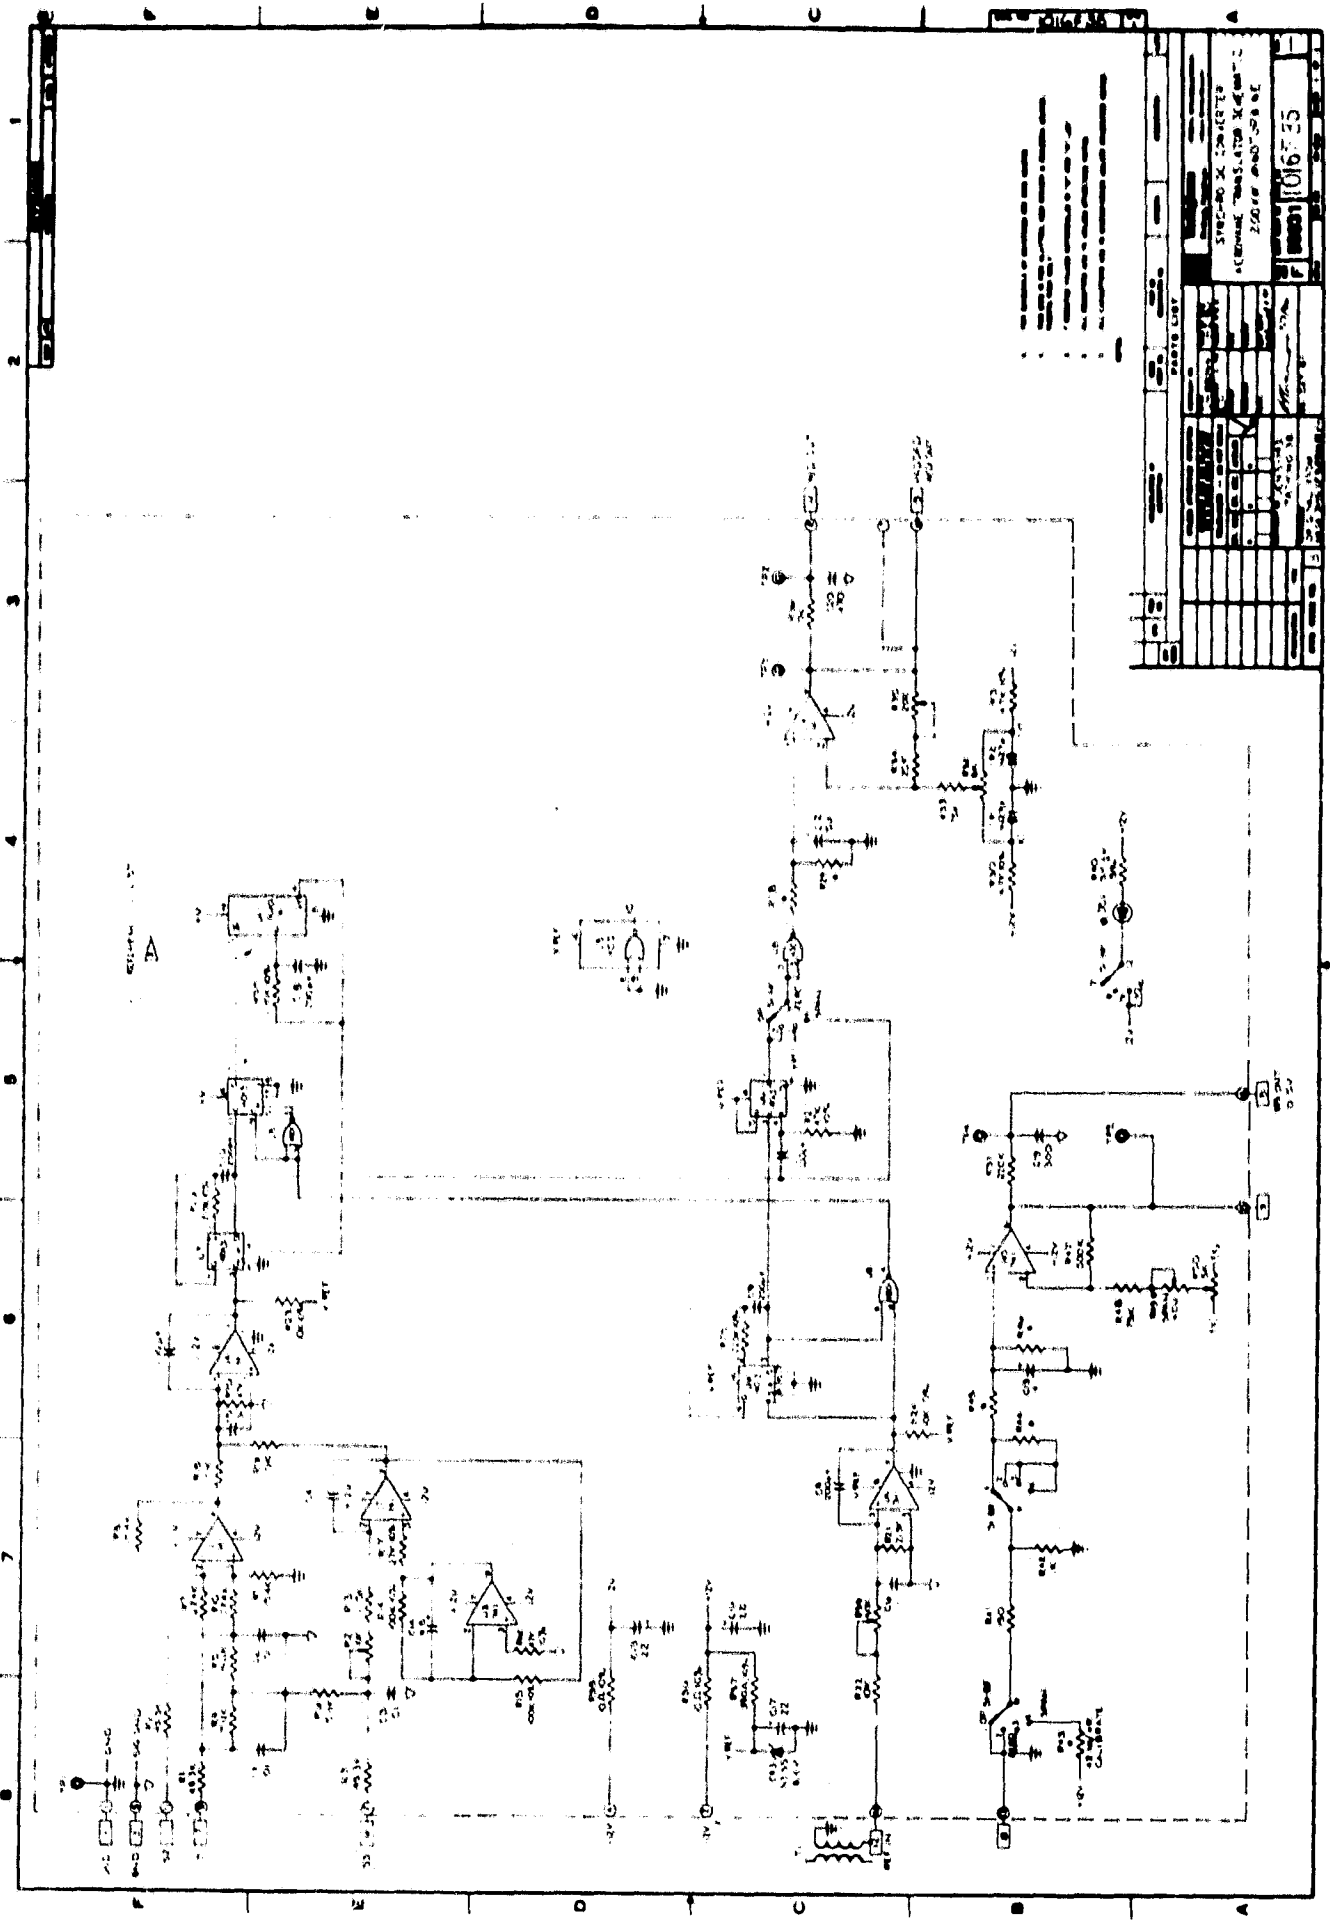

PARTS LIST	
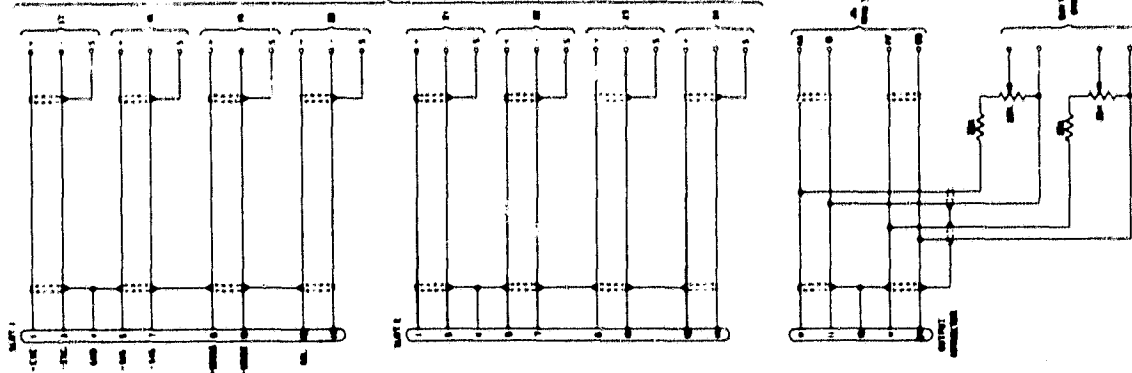


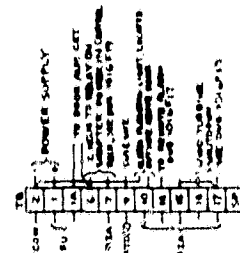

TERMINAL CONNECTIONS

INTRUSION ALARM ELEMENTARY DIAGRAM

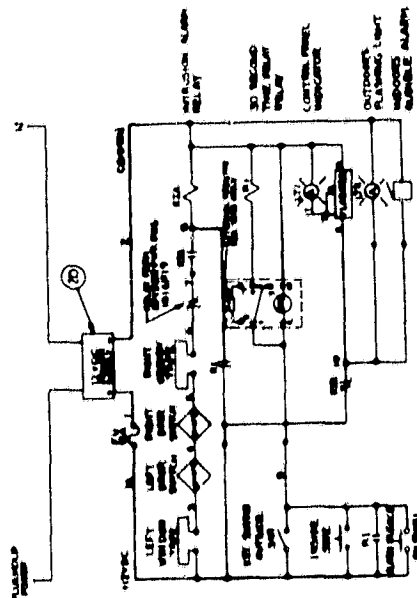

1016 F36